


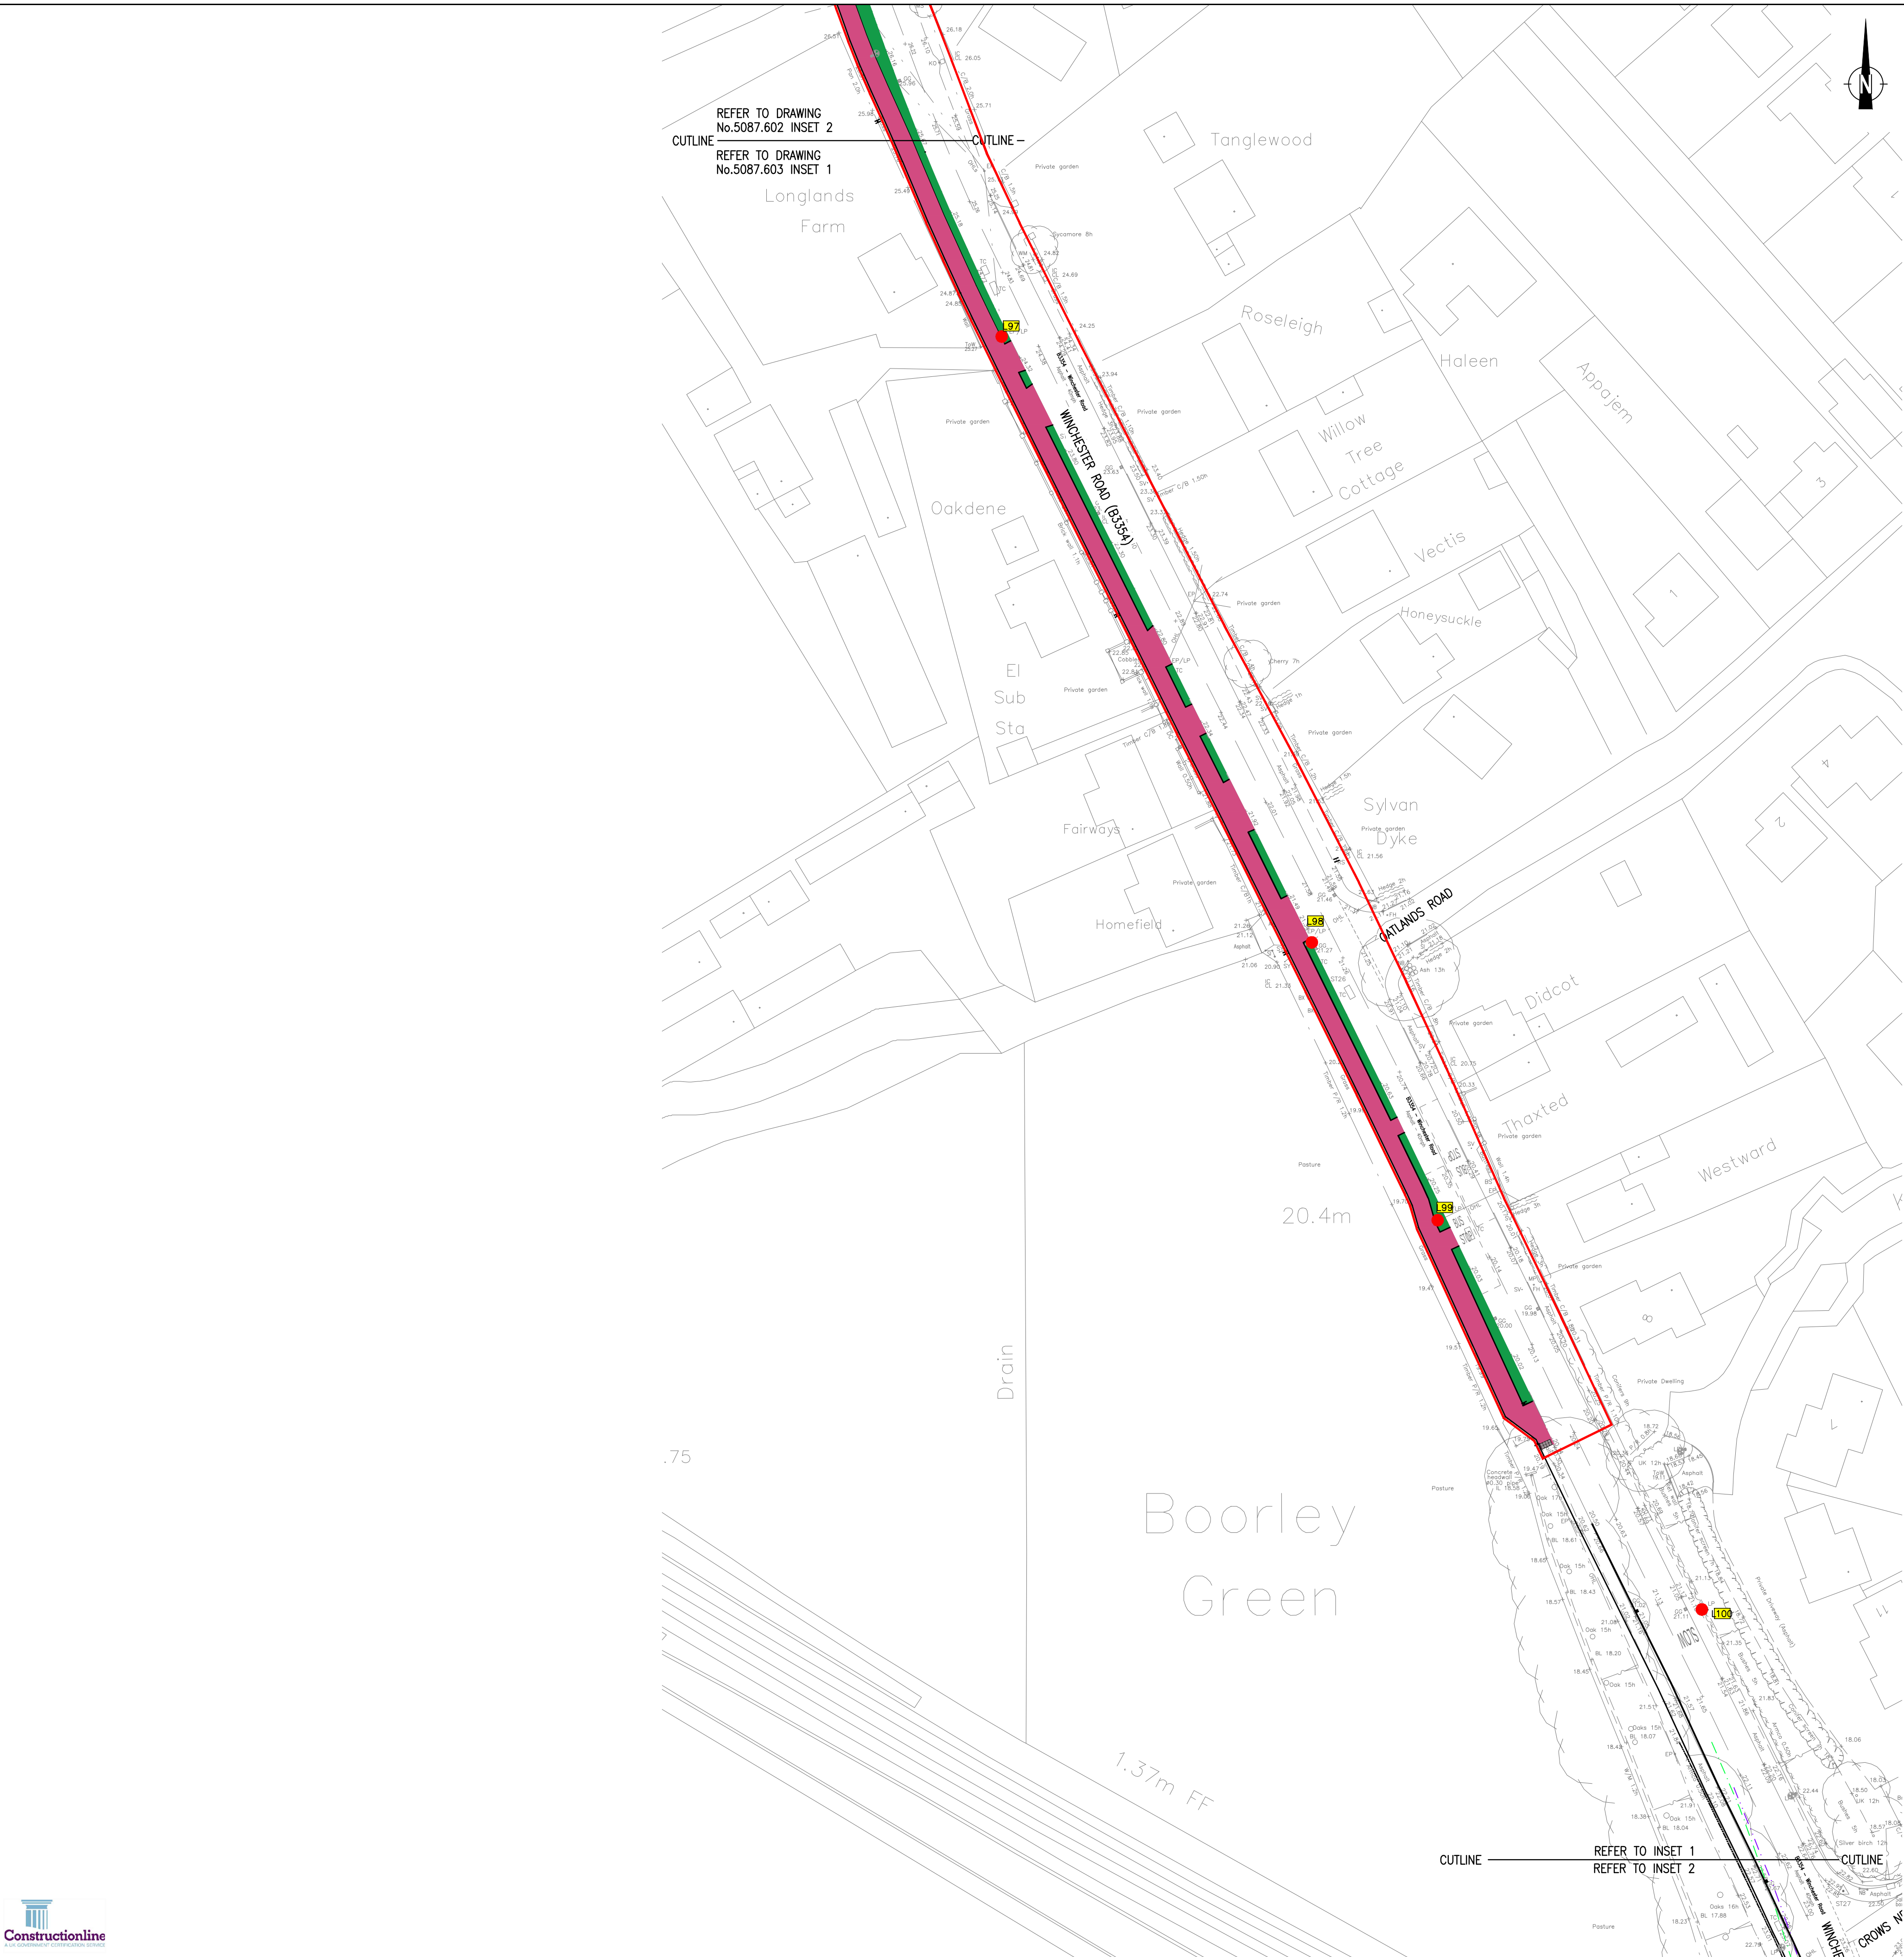

GENERAL NOTES:

- DO NOT SCALE FROM THIS DRAWING.
- ALL DIMENSIONS ARE IN METRES, UNLESS STATED OTHERWISE.
- LEVELS ARE IN METERS & RELATE TO ORDNANCE SURVEY DATUM VIA GPS NETWORK.
- SURVEY GRID & COORDINATES RELATE TO A LOCAL ARBITRARY GRID.
- THIS DRAWING IS BASED ON TOPOGRAPHICAL SURVEY (REF: 10633 DEC 2011) UNDERTAKEN BY: SURVEY SOLUTIONS.
- THIS DRAWING WAS READ IN CONJUNCTION WITH ALL RELEVANT SCHEME DRAWINGS AND SPECIFICATIONS.
- ALL WORKS WERE CARRIED OUT IN STRICT ACCORDANCE WITH "THE SPECIFICATION FOR HIGHWAY WORKS – MODIFIED AND EXTENDED", INCLUDING HAMPSHIRE COUNTY COUNCIL'S SUPPLEMENTARY CLAUSES.
- ALL WORKS WITHIN THE PUBLIC HIGHWAY WERE CARRIED OUT & COMPLY WITH THE REQUIREMENTS OF THE DTP "TRAFFIC SIGNS MANUAL CHAPTER 8 – TRAFFIC SAFETY MEASURES AND SIGNS FOR ROAD WORKS AND TEMPORARY SITUATION".
- ALL ROAD MARKINGS & TRAFFIC SIGNS SHALL COMPLY WITH "THE TRAFFIC SIGNS REGULATIONS AND GENERAL DIRECTIONS 2016".
- ALL EXISTING LEVELS WERE CONFIRMED ON SITE PRIOR TO COMMENCEMENT OF ANY WORKS.
- BEFORE ANY WORKS COMMENCED THE HAMPSHIRE COUNTY COUNCIL AREA HIGHWAY MANAGER WAS CONTACTED.

- KEY:
- LIMIT OF S278 WORKS AREA
 - CARRIAGEWAY
 - SHARED FOOTWAY/CYCLEWAY
 - FOOTWAY
 - VERGE
 - HIGHWAY EASEMENT
 - STREET LIGHTS
 - HIGHWAY SURFACE WATER

AS BUILT

Rev	Description	Dwn	Chk	Date
REVISIONS				
Preliminary Issue	Submitted for S104			
Planning Issue	Issued for Tender			
Submitted for S38	Issued for Construction			
Submitted for S278	As Built			✓
DRAWING STATUS				

STUART MICHAEL ASSOCIATES
CONSULTING ENGINEERS
Stuart Michael Associates Ltd
Coombe House, Coombe Square, Thatcham, Berkshire RG19 4JF
T: 01635 867 711 e: mail@stuartmichael.co.uk
F: 01635 861 715 W: www.stuartmichael.co.uk

Linden BOWIS HOMES
BLOOR HOMES

JOB TITLE
**BOTLEY PARK HOTEL
BOORLEY GREEN**
DRAWING TITLE
**WINCHESTER ROAD
S278 IMPROVEMENT WORKS
AGREEMENT PLAN SHEET 3**

DATE	DRAWN	CHECKED
JUNE '21	JS	MSR
DRAWING NO.	REV	SCALE
5087.667	-	1:500 @ A1

© This drawing is the copyright of Stuart Michael Associates Limited. It may not be reproduced or amended without the written approval of Stuart Michael Associates