




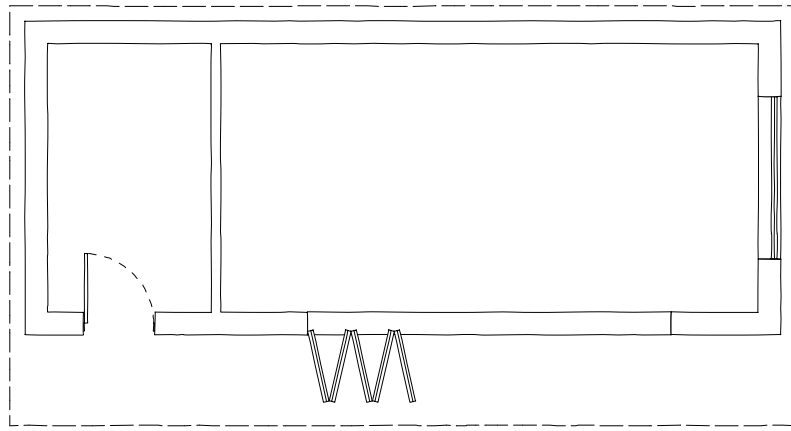


1 floor plan (as built / proposed)
Scale: 1:100

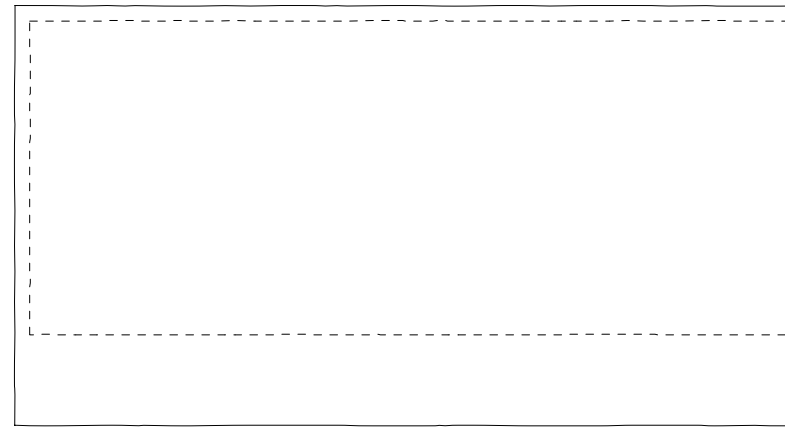


2 roof plan (as built / proposed)
Scale: 1:100

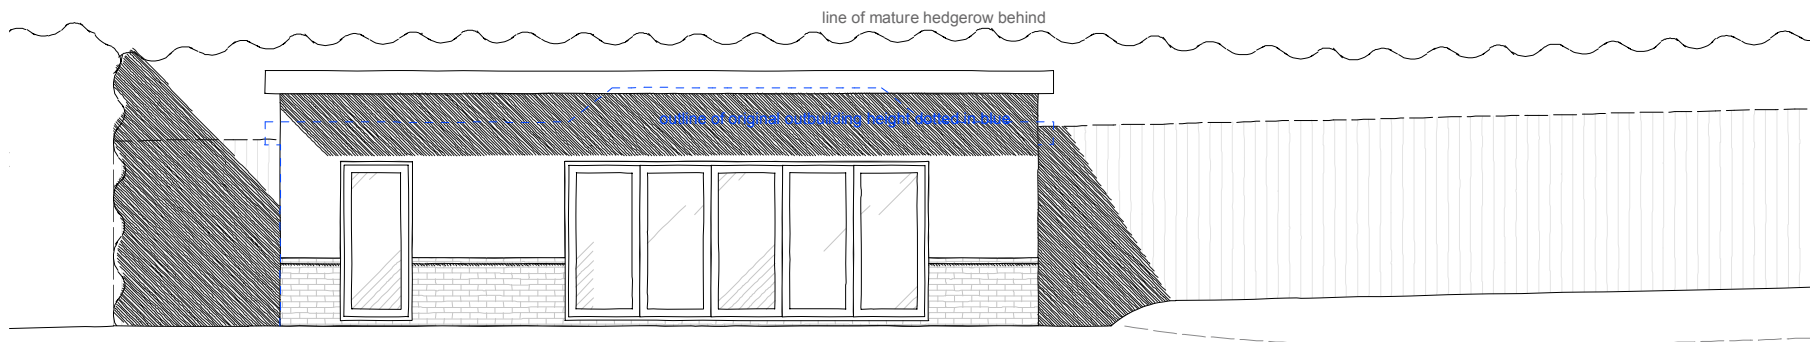


3 south elevation (as built / proposed)
Scale: 1:100

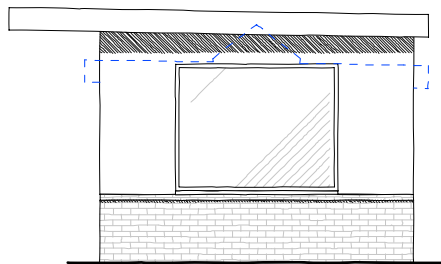



4 east elevation (as built / proposed)
Scale: 1:100

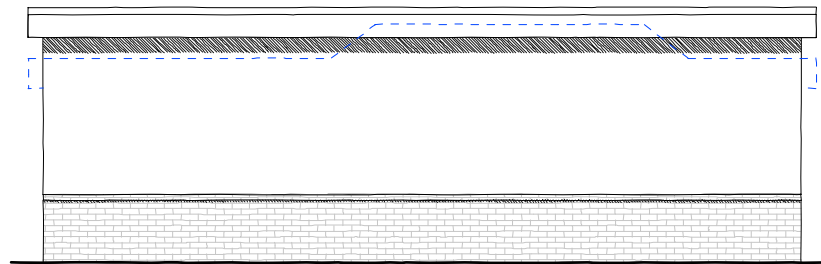

5 north elevation (as built / proposed)
Scale: 1:100

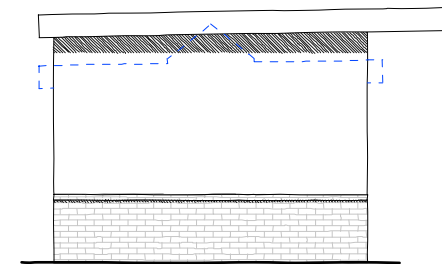

6 west elevation (as built / proposed)
Scale: 1:100

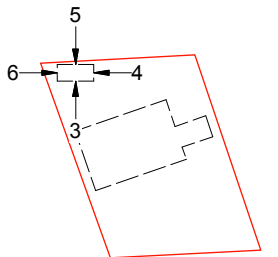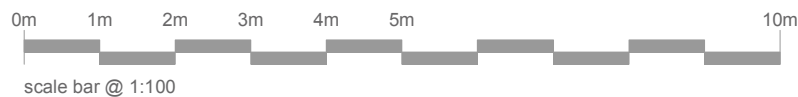

THIS DRAWING REMAINS PROPERTY OF KODE ARCHITECTURE LTD AND CANNOT BE REPRODUCED OR COPIED WITHOUT PRIOR WRITTEN CONSENT.

DRAWING TO BE USED FOR THE STATUS AS NOTED, DO NOT SCALE FROM THE DRAWING OTHER THAN FOR PLANNING PURPOSES. ALL SIZES TO BE CONFIRMED ON SITE BEFORE CONSTRUCTION. ALL WORKS MUST BE CARRIED OUT IN ACCORDANCE WITH THE RELEVANT STATUTORY AUTHORITIES.

UNLESS STATED, NO TOPOGRAPHICAL SURVEY CARRIED OUT. KODE ARCHITECTURE ACCEPT NO RESPONSIBILITY FOR ERRORS OR OMISSIONS ON DRAWINGS/MEASUREMENTS .

notes:
REV A: Existing (prior to works) plans + elevations shown
22/09/2022



project date:	Sep 2022	project title:	Outbuilding 263 Winchester Road, Chandlers Ford
status:	Planning	sheet name:	As built / Proposed Floor Plan + Elevations
scale	as noted @ A3	drawing no.:	KA/2022/J33.02 REV A