


GENREAL KEY:

Visibility Splay
2.4m x 43m visibility splay

Photo Reference Point
As Built

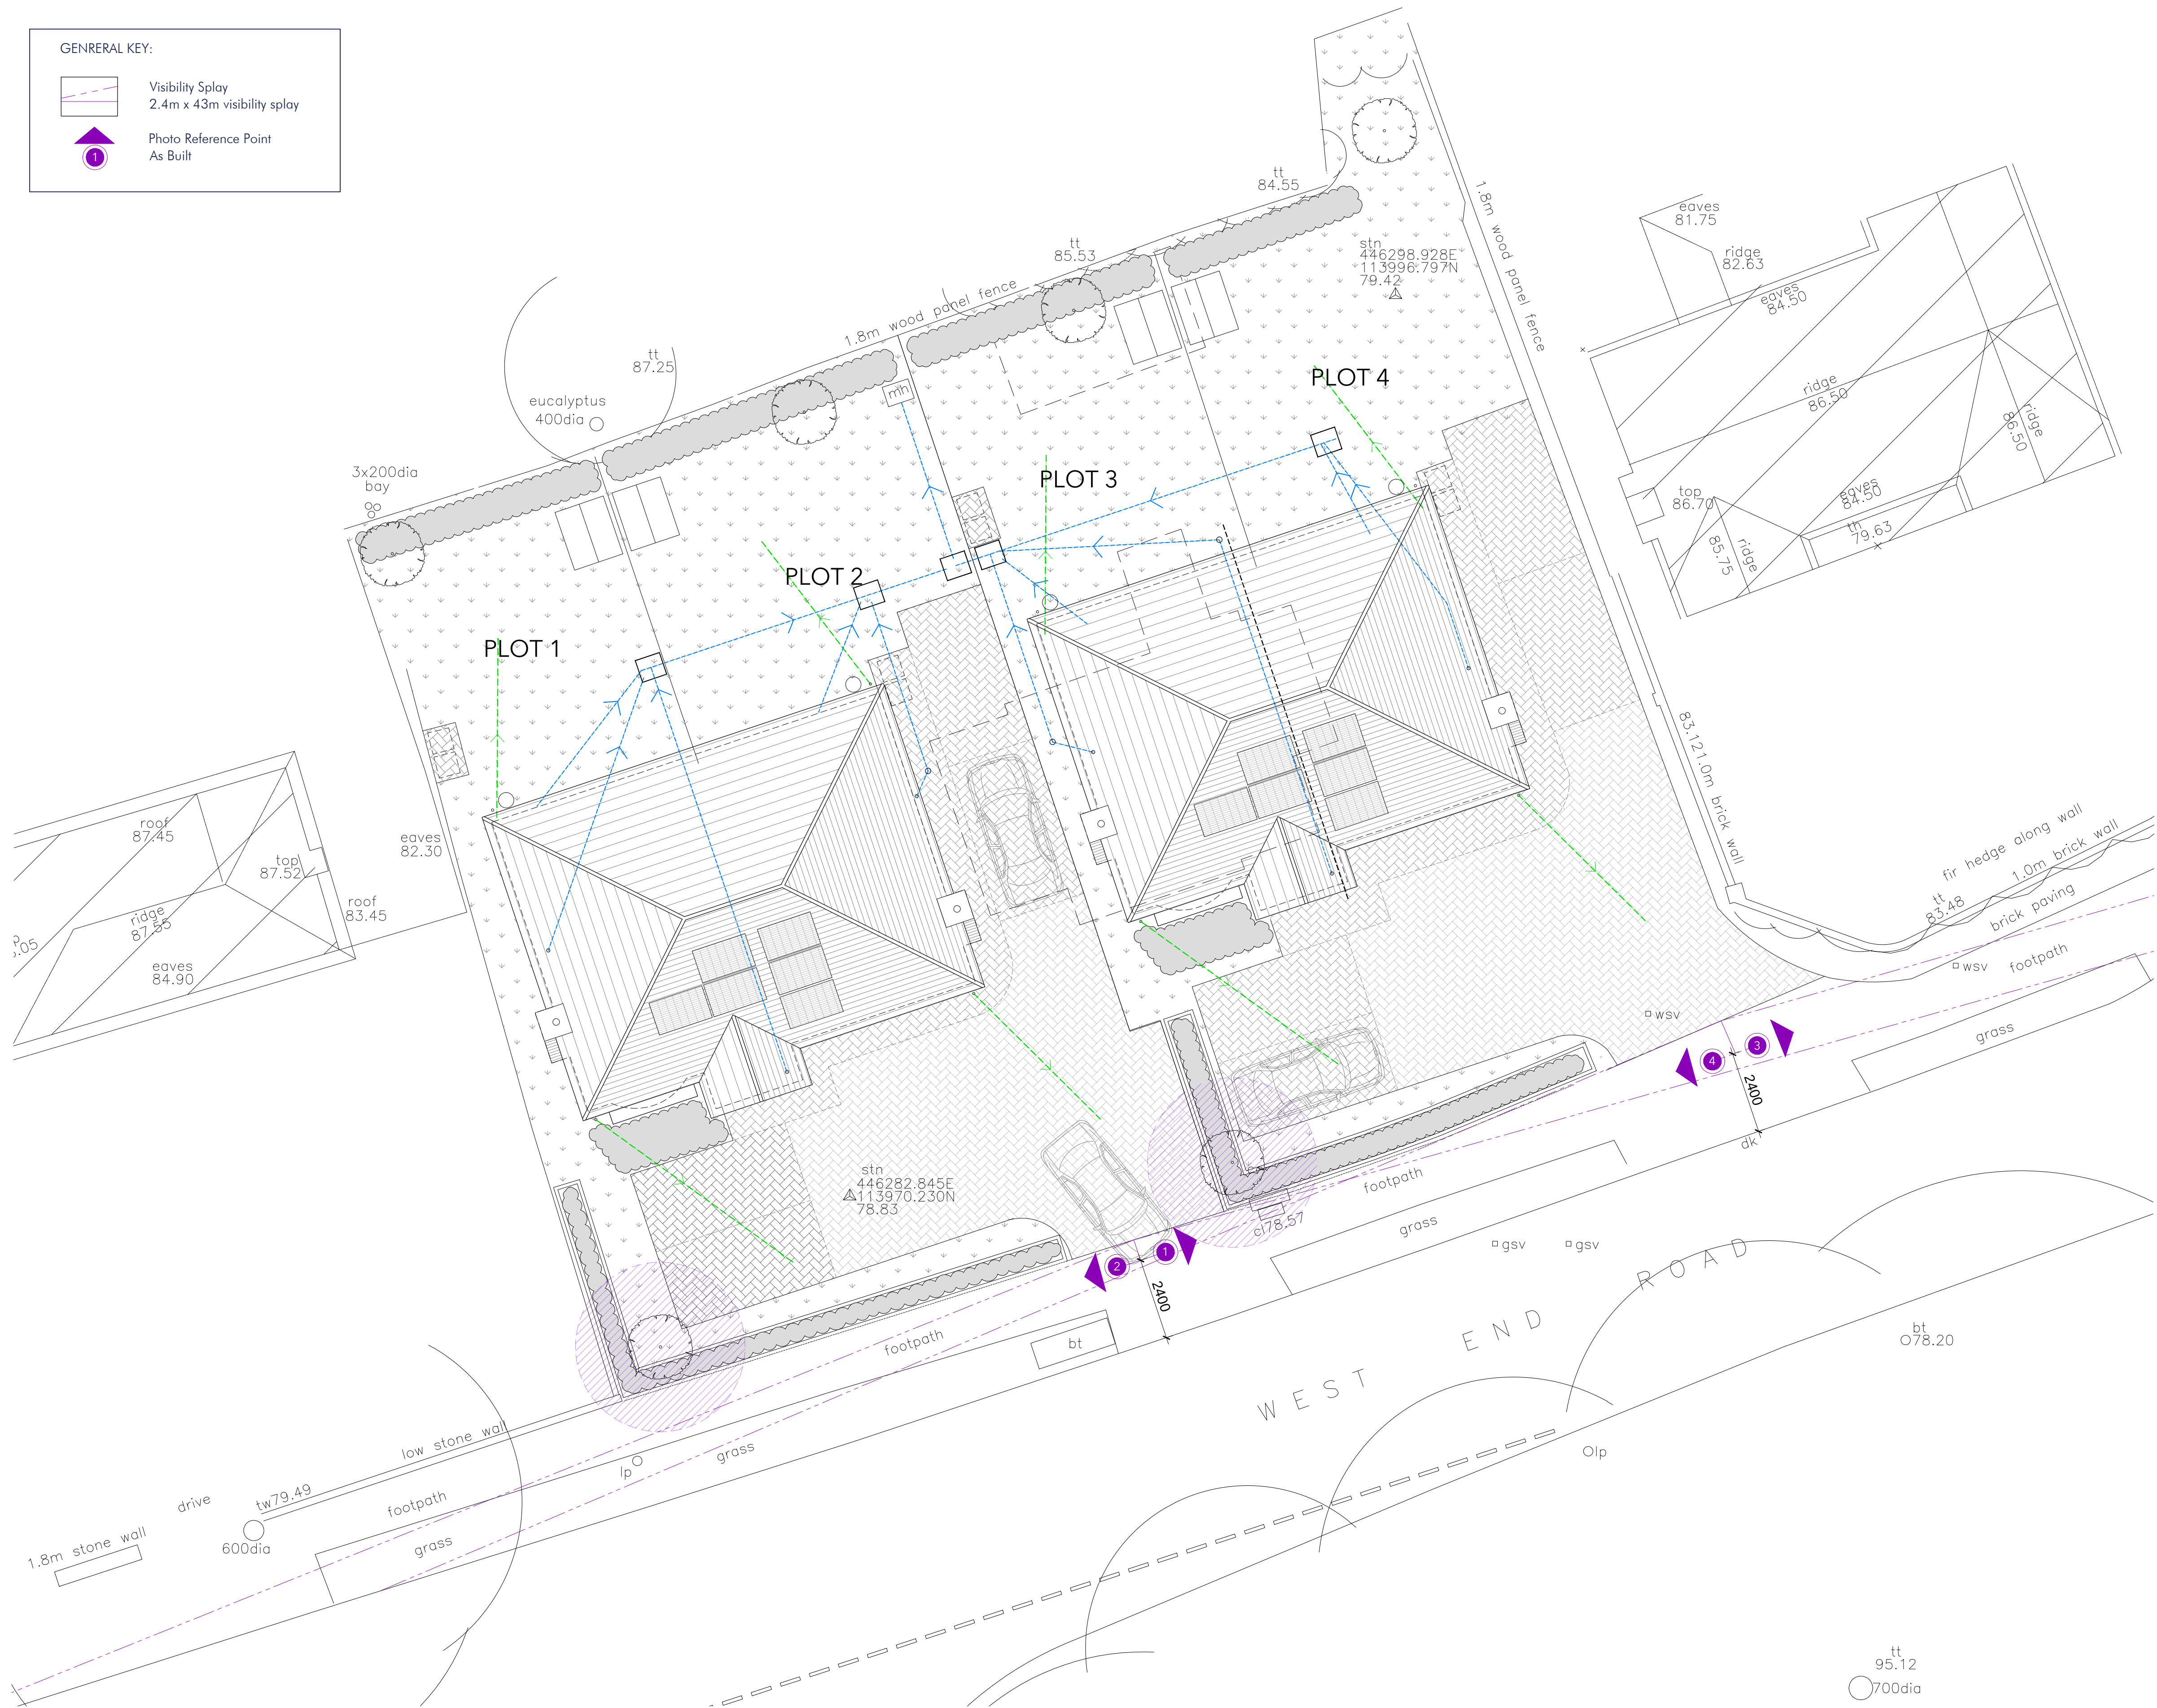

1 Plot 1/2 - View towards A27



2 Plot 1/2 - View towards Beauworth Av.



3 Plot 3/4 - View towards A27



4 Plot 3/4 - View towards Beauworth Av.

Note: All images taken 2.4m set back from Pavement/Road junction

No.	Description	Date

studio

t. 02382 542011
e. info@rs-studio.co.uk
w. www.rs-studio.co.uk

Drawing Title:
Visibilty Splays
AS BUILT

Project Title:
285 West End Road
West End
SO18 3BW

Drawing No.:
1233-DC-05

Date: December 2022

Scale: 1:100

Drawn: ML

Checked: RS

This drawing is the copyright of the company and must not be reproduced or used without permission. Annotatted dimensions are to be taken in preference to scaled dimensions and site dimensions must be checked before work is commenced

Site Plan
AS PROPOSED
Scale 1:100

0 1m 2m 3m 4m 5m