

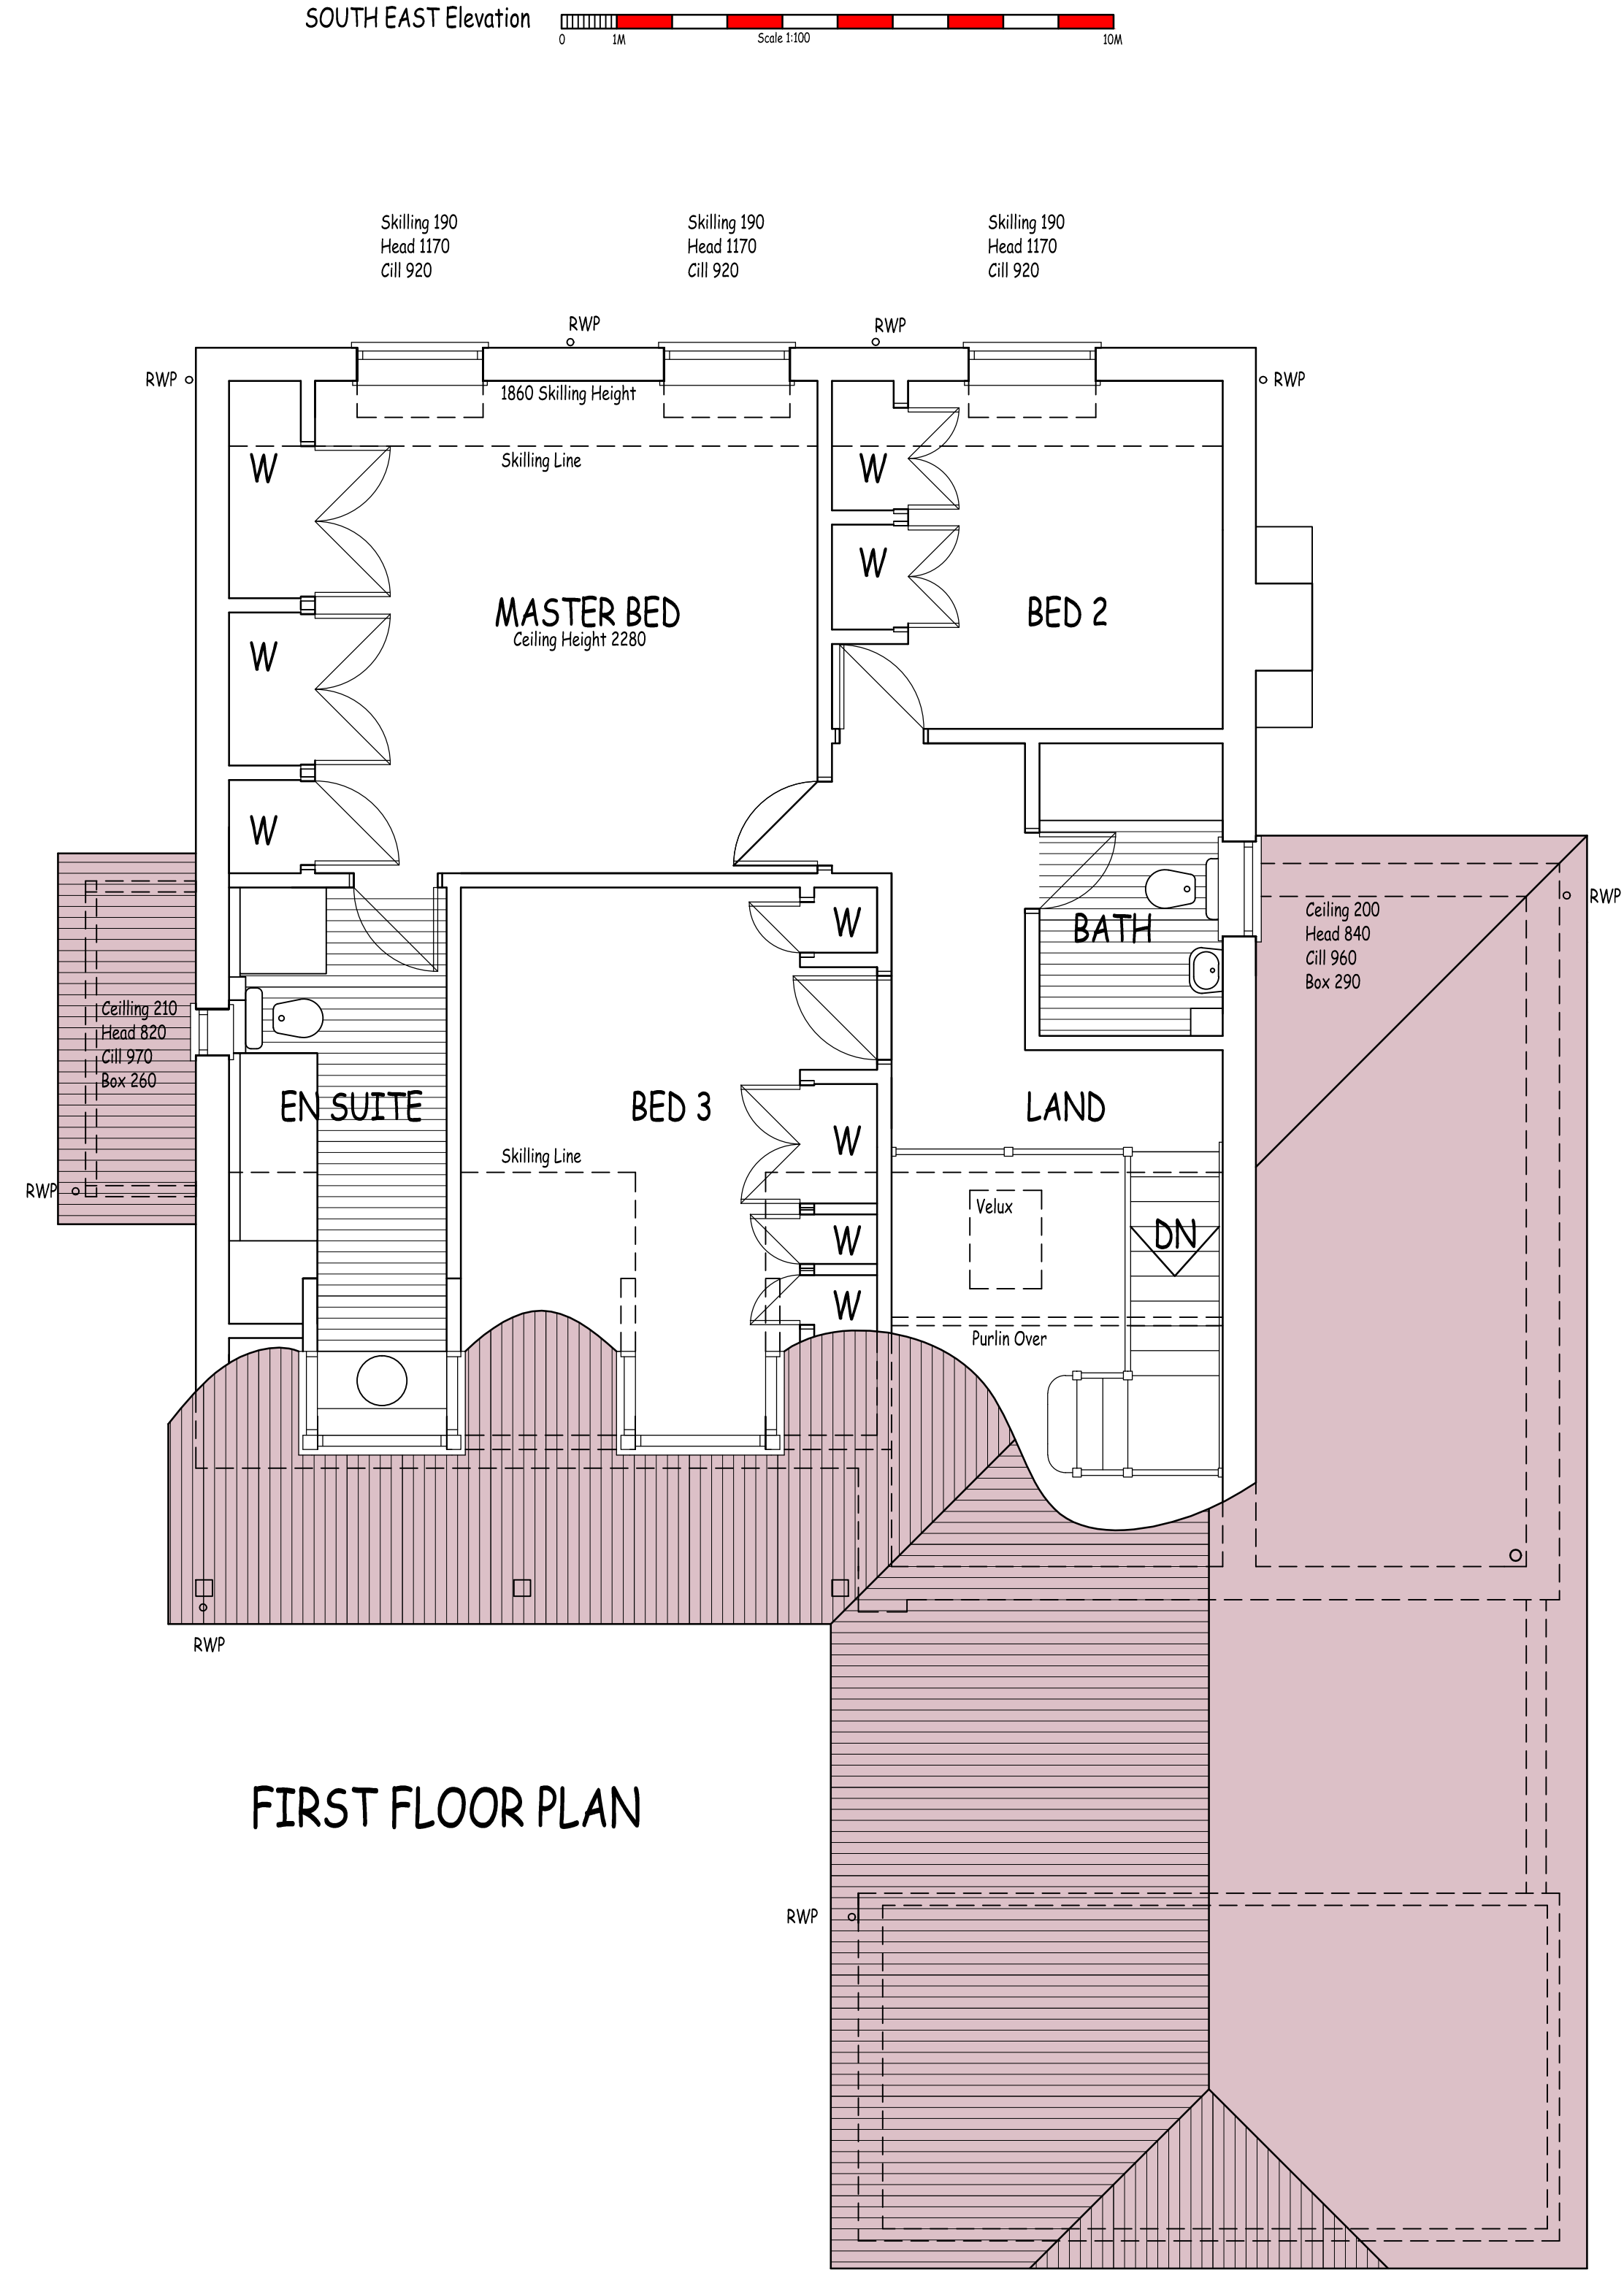
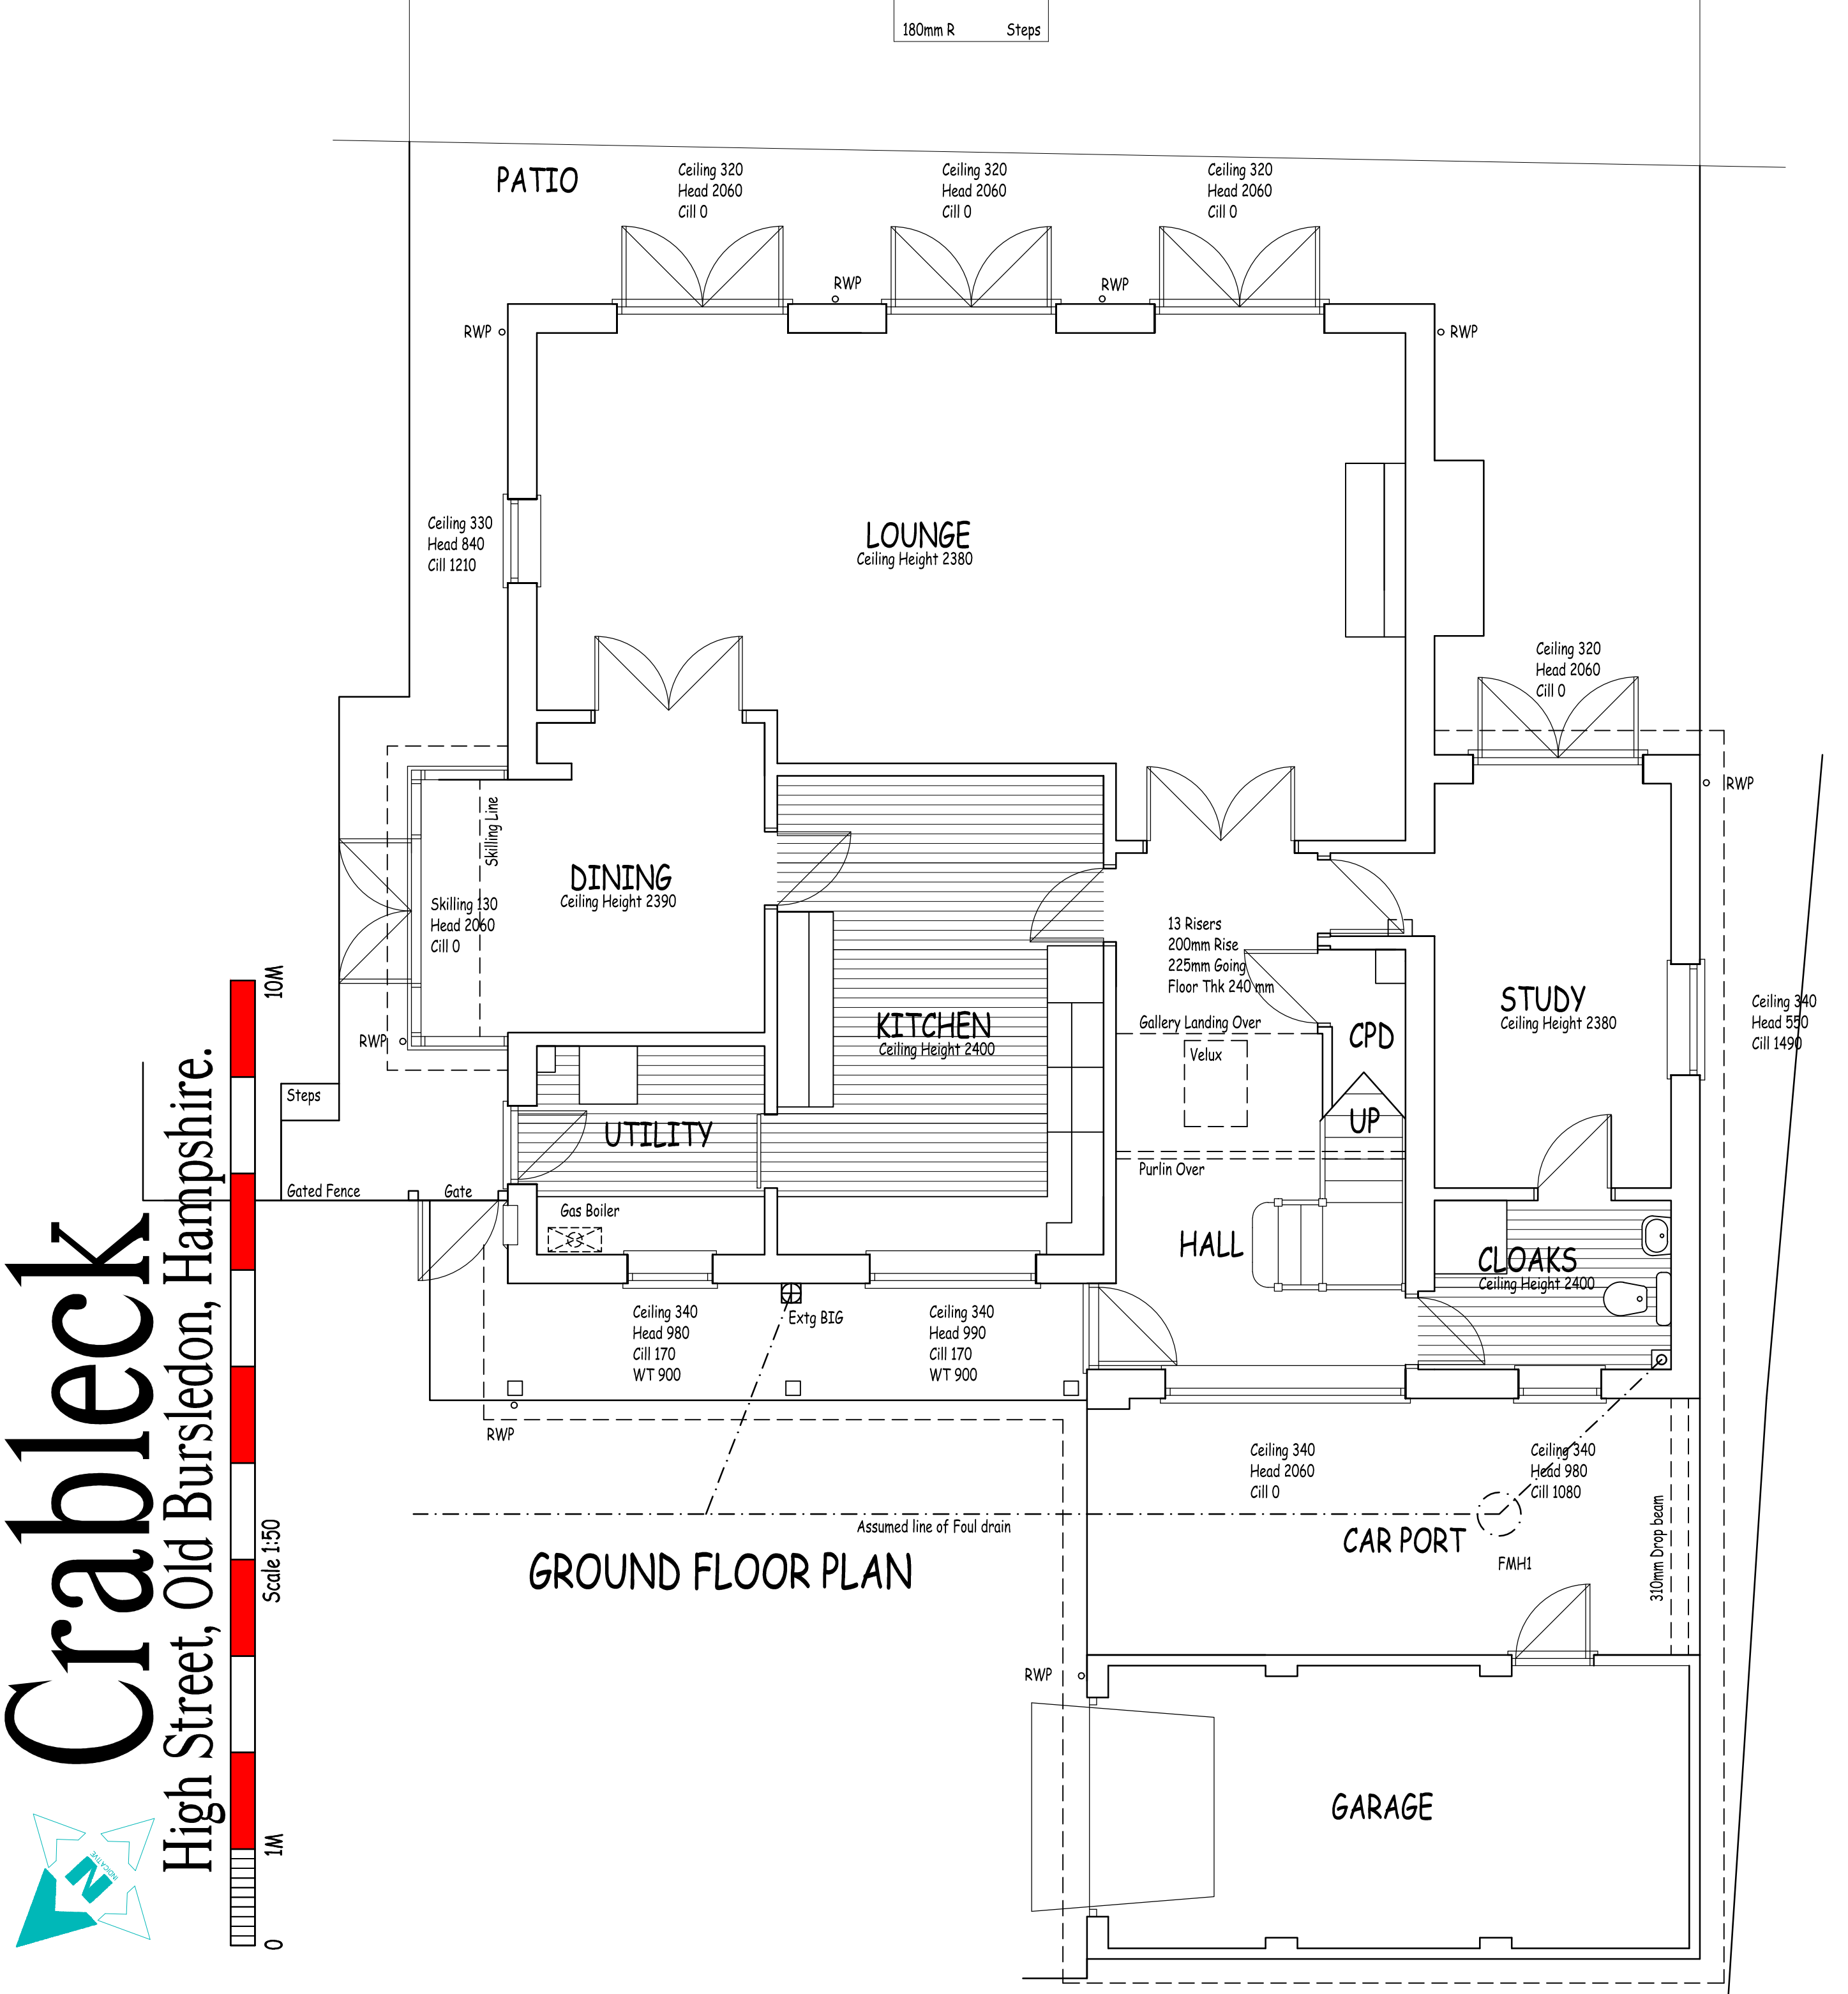


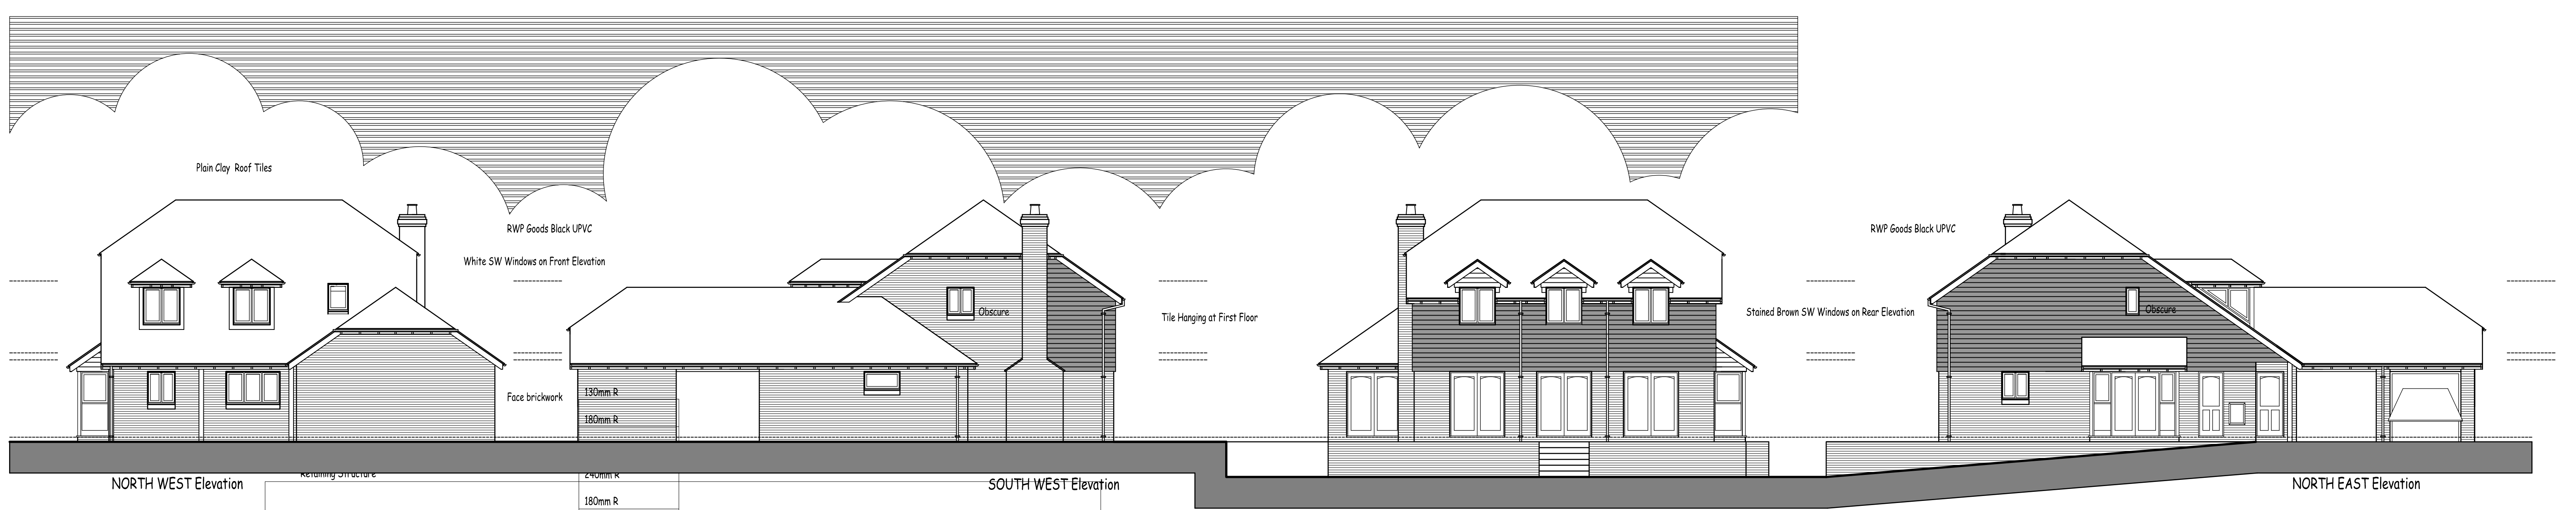

A 26/01/23 CLIENTS OBSERVATIONS NOTED
This drawing is protected by copyright and may not be copied or disclosed to third parties without the expressed permission of Town & Country Architecture.
Preference should be given to written figured dimensions over scale measurements. Discrepancies of any kind must be reported to Town & Country Architecture.

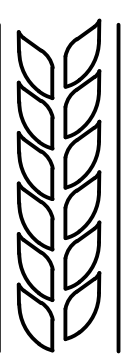

TOWN & COUNTRY ARCHITECTURE
ARCHITECTURAL TECHNOLOGISTS
4 FOWGLOVES
THE MEADOWS
FARHAM
HAMPSHIRE PO16 8JW
TELEPHONE: (01329) 238492
FACSIMILE: (01329) 238492

PROJECT
AS BUILT PLAN
Crableck, High Street
Old Bursledon
Hampshire

CLIENT
Mr & Mrs J.Burke

SCALE
1:100 1:50 1:500 1:1250 (A1)

DATE
-

DRAWN
P.T.E MCIAT

CHECKED
-

REVISION
22/24/01