


This drawing may be scaled with reference to the scale bar for planning application purposes only. Do not scale for any other purpose, use only annotated dimensions. All dimensions are to be checked by parties using the drawing, and any errors or omissions are to be reported to James Potter Associates Ltd.

Rev.	Date	Note	Author	Checked
A	14/02/23	Addition of proposed obscure glass panel	JK	JP




AS BUILT SOUTH WEST ELEVATION

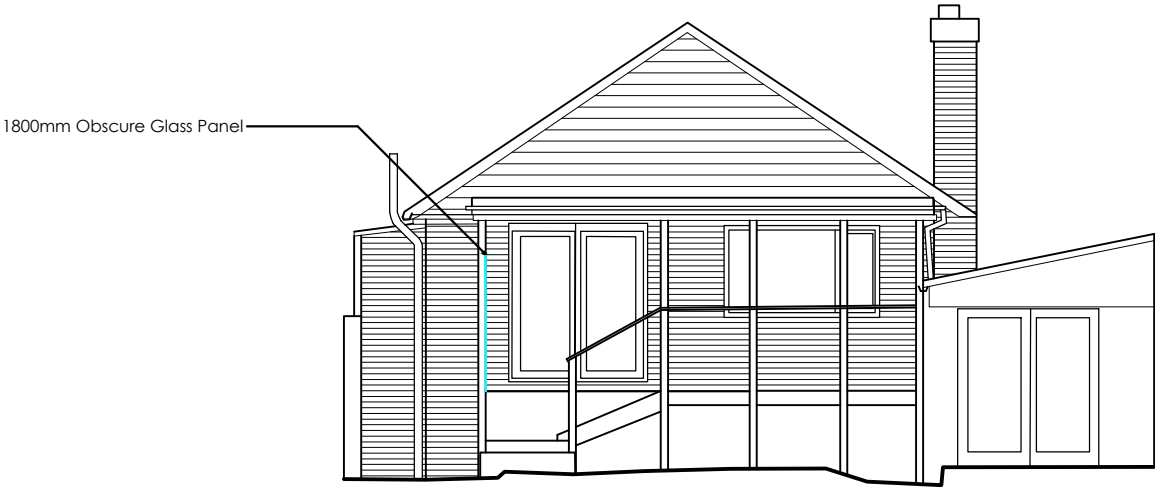

AS BUILT NORTH EAST ELEVATION

KEY

 1800mm Obscure Glass Panel

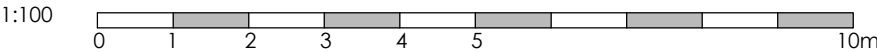

Project	CAR PORT AND VERANDA 9 BRIDGE CLOSE BURSLEDON, SOUTHAMPTON SO31 8AN					Drawing	AS BUILT ELEVATION 1			
						Job-Dwg Number	22078-PL-006		Rev.	A
Client	MR DARREN SMITH					JPA JAMES POTTER ASSOCIATES www.jpa.design JPA - PORTSMOUTH 117 Highland Road, Southsea, Portsmouth, PO4 9DD t. +44(0)2394 002 897				
Status	PLANNING									
Scale	1:100		Sheet Size A3							
Author	JK	Checked	RH	Date	18/11/2022					