



This drawing may be scaled with reference to the scale bar for planning application purposes only. Do not scale for any other purpose, use only annotated dimensions. All dimensions are to be checked by parties using the drawing, and any errors or omissions are to be reported to James Potter Associates Ltd.

Rev.	Date	Note	Author	Checked
A	05/12/22	Door removed from east elevation.	RH	JP
B	14/02/23	Addition of proposed 1800mm obscure glass panel.	JK	JP

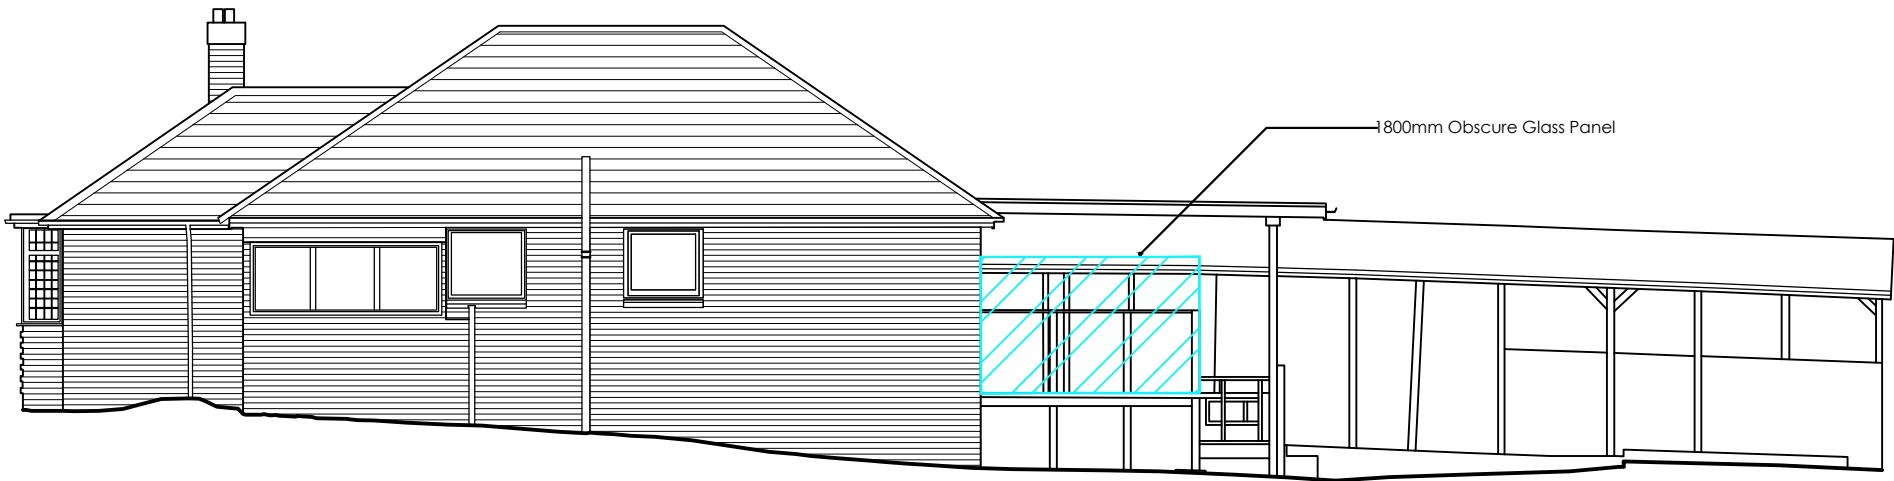


AS BUILT SOUTH EAST ELEVATION

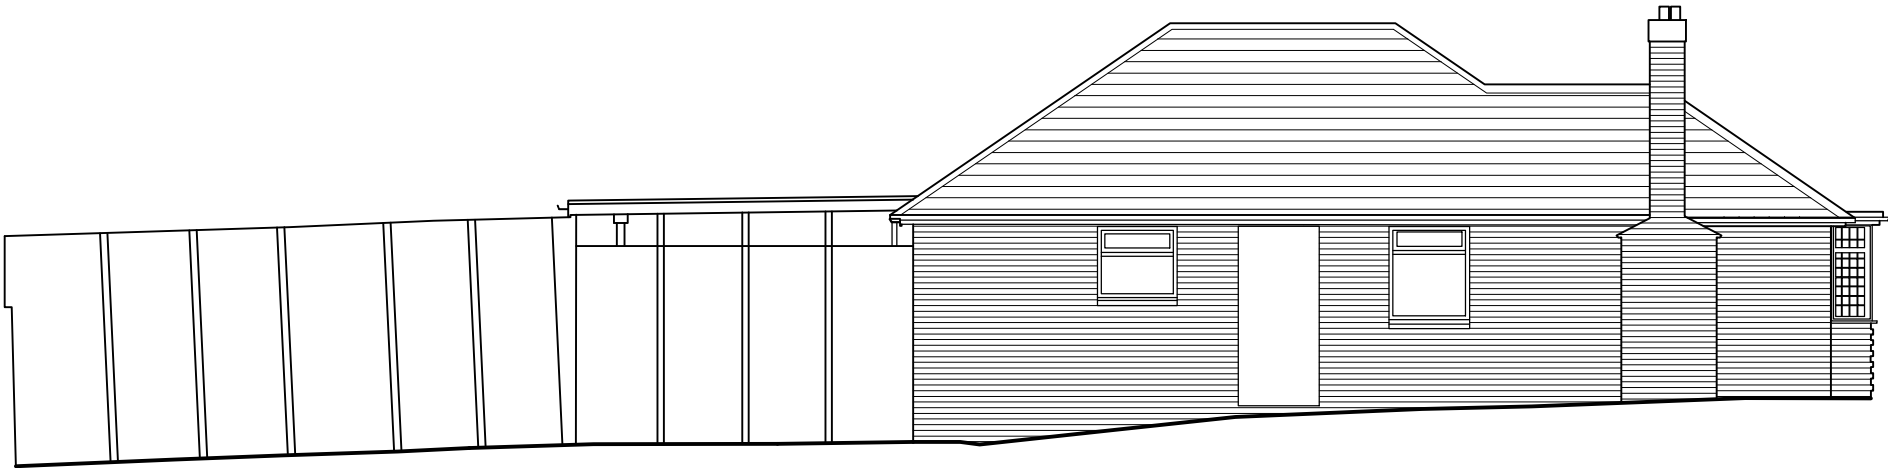

AS BUILT NORTH WEST ELEVATION

KEY

 1800mm Obscure Glass Panel

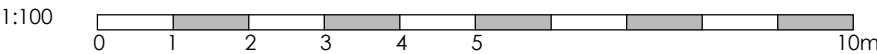

Project	CAR PORT AND VERANDA 9 BRIDGE CLOSE BURSLEDON, SOUTHAMPTON SO31 8AN					Drawing	AS BUILT ELEVATIONS 2			
						Job-Dwg Number	22078-PL-007		Rev.	B
Client	MR DARREN SMITH					JPA JAMES POTTER ASSOCIATES www.jpa.design JPA - PORTSMOUTH 117 Highland Road, Southsea, Portsmouth, PO4 9DD t. +44(0)2394 002 897				
Status	PLANNING									
Scale	1:100		Sheet Size	A3						
Author	JK	Checked	RH	Date	18/11/2022					