
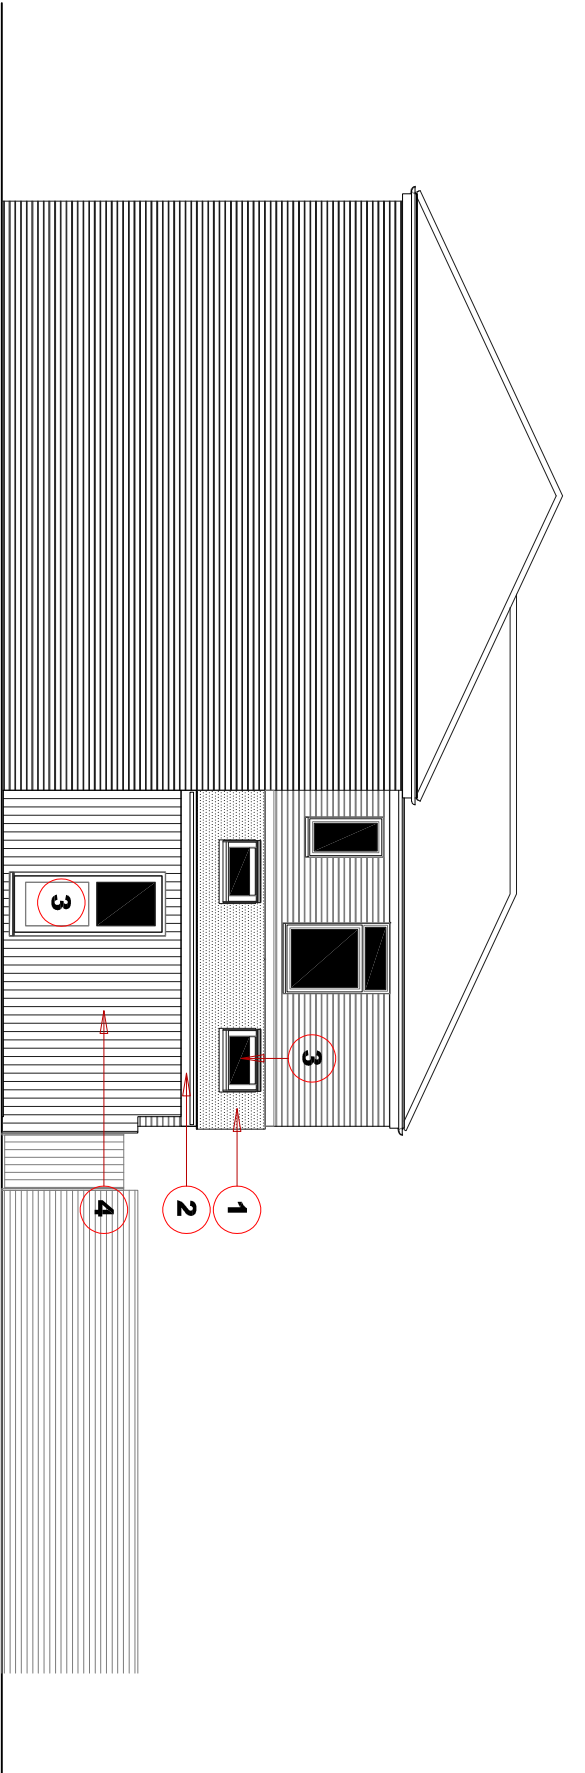



© STRINGENT COPYRIGHT:
This drawing has been produced for:
Ms Ana Slepko
and prepared for submission as part of any statutory Applications. It is not intended for use by any other person or for any other building project or purpose without prior permission from Toldfield Architects Ltd.

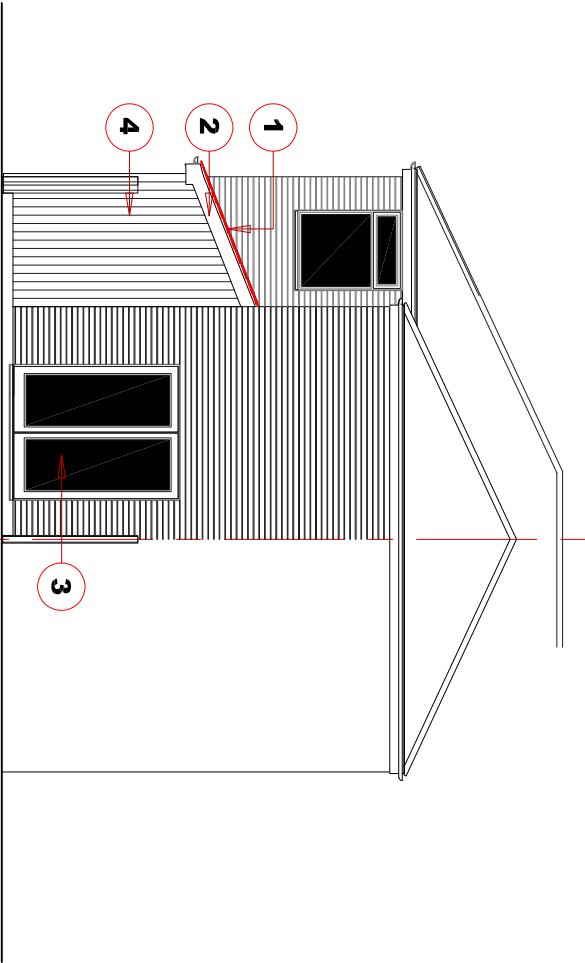

AS_BUILT REAR ELEVATION

AS_BUILT SIDE ELEVATION

1:100

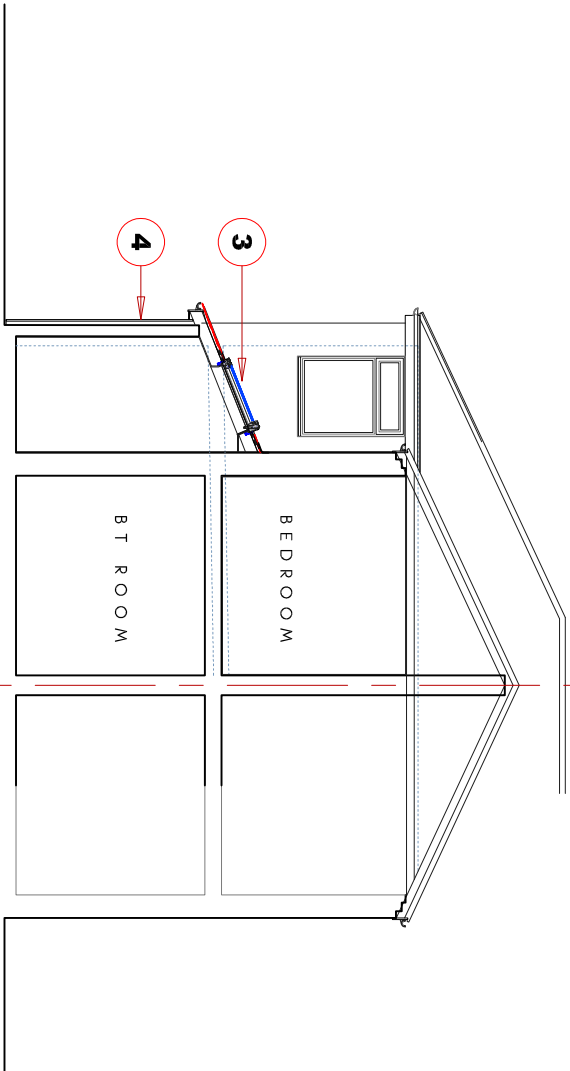


AS-BUILT CROSS-SECTION

1:100

AS-BUILT MATERIAL SPECIFICATION

- NEW PITCH LEAN-TO-ROOF:** In Natural Slates.
- FACIA :** In PVCu (in Dark Gray)
- DOORS & WINDOWS:** Velux Rooflights in black, PVCu frames doors in white.
- WALL FINISH:** Treated vertical timber cladding.

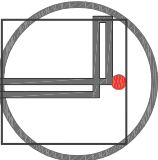 TOLDFIELD ARCHITECTS Toldfield Architectest Ltd 5 Freemantle Business Centre 152 Millbrook Road East Southampton SO15 1JR Tel: 023 80 236165 Emails: info@toldfieldarchitects.co.uk ad@toldfieldarchitects.co.uk kourosh@toldfieldarchitects.co.uk Web: www.toldfieldarchitects.co.uk				Project Name and Address: conversion of existing conservatory into a Shower Rm. & minor internal remodelling @ 4 Nutbeam Rd, Eastleigh				Client: Ms Ana Slepko				Drawing Title: As_Built elevations			
Project Ref:				Origin:				Zone:				Level:			
230201				TA				- 01				- 01			
Status:				P				- A				- P06			
Appraisal				Date:				Rev:				Comments:			
T/A Code:				Project Stage:				Sheet @ A3:				Kourosh			
230201				Planning				1:100				Feb. 2023			
Rev:				Comments:				Dr:				Ch:			