



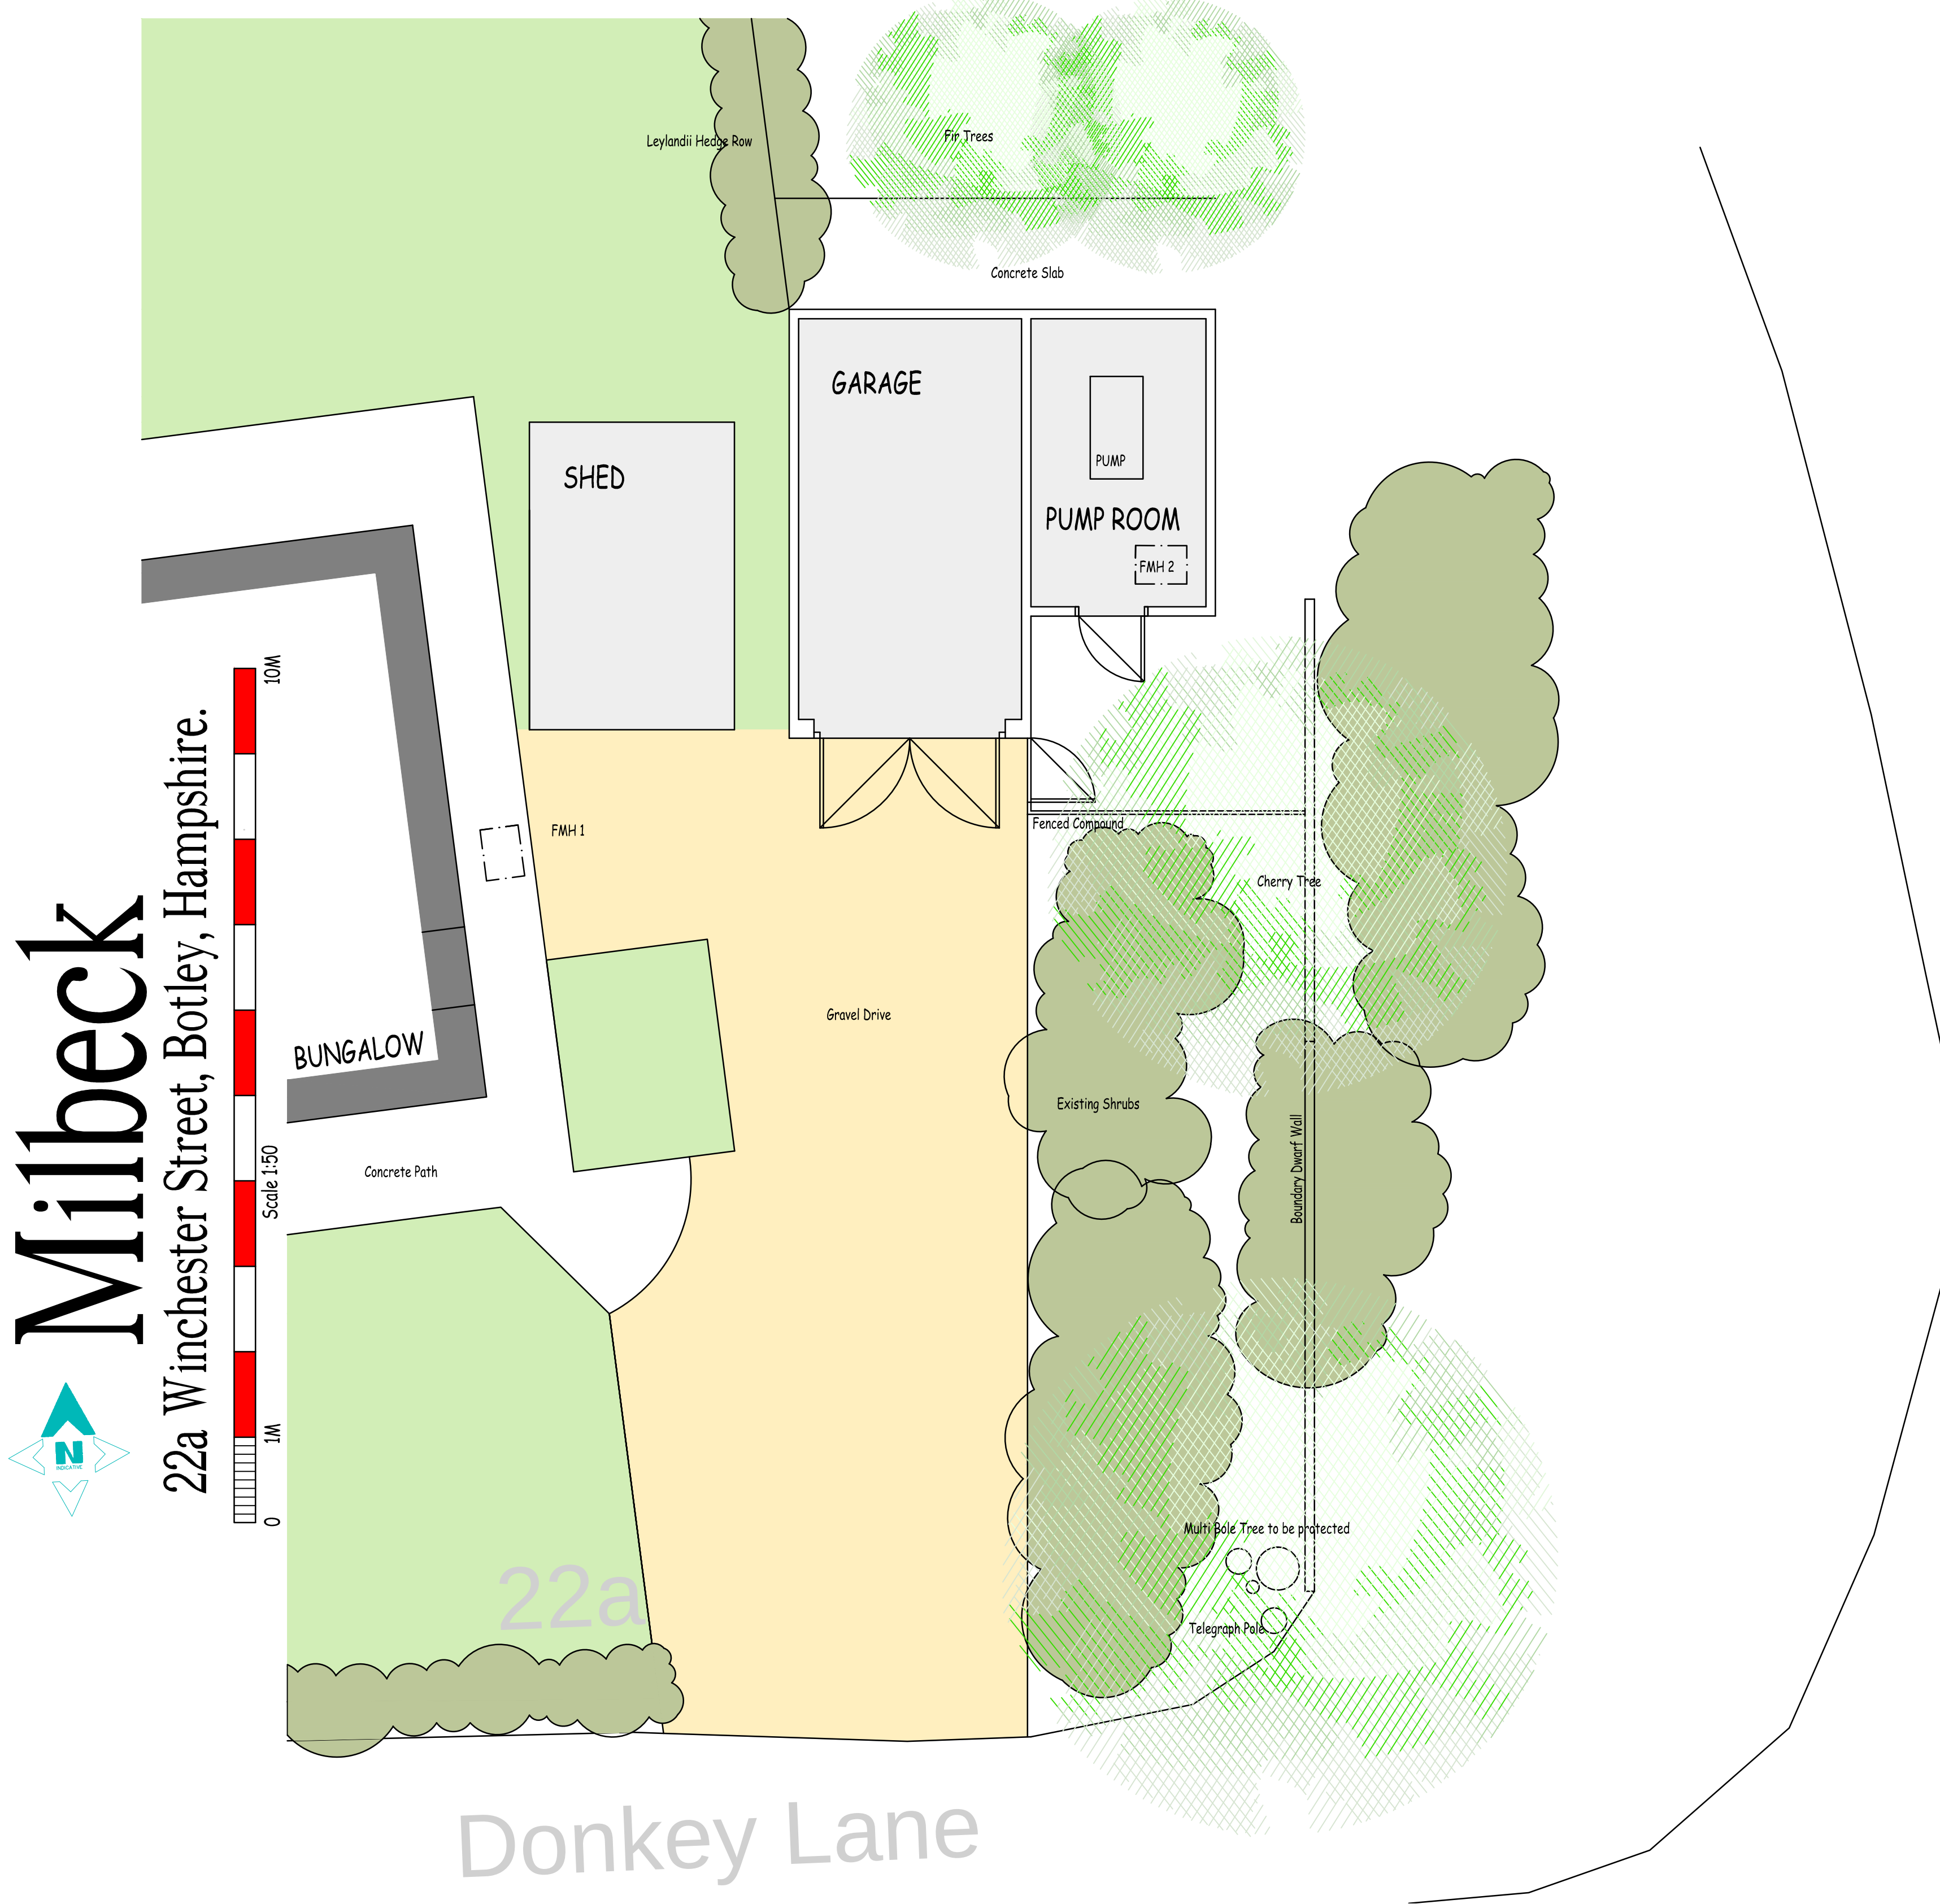

*
This drawing is protected by copyright and may not be copied or disclosed to third parties without the expressed permission of Town & Country Architecture.
Preference should be given to written figured dimensions over scale measurements. Discrepancies of any kind must be reported to Town & Country Architecture.

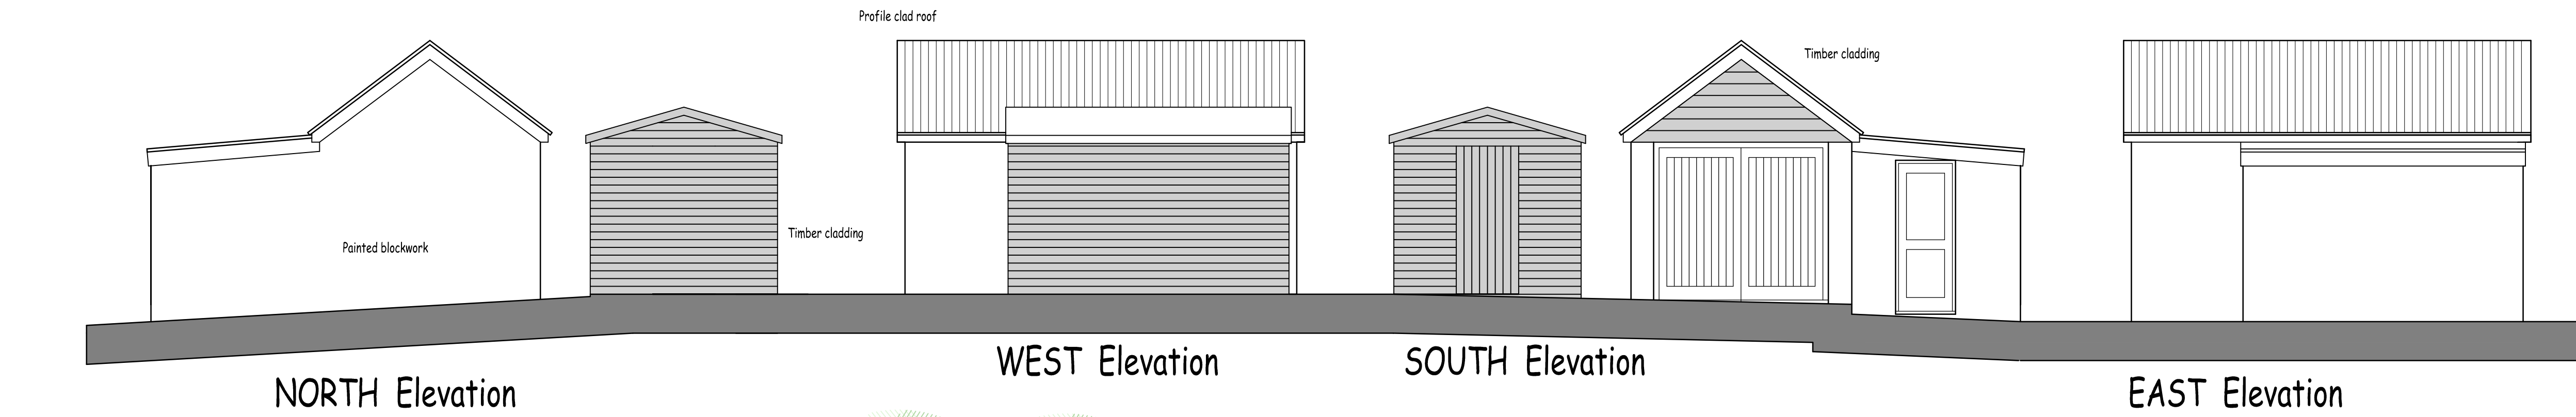

TOWN & COUNTRY ARCHITECTURE
ARCHITECTURAL TECHNOLOGISTS
4 FOXGLOVES
THE MEADOWS
FAREHAM
HAMPSHIRE PO16 8UW
TELEPHONE: (01329) 238482
FACSIMILE: (01329) 238482

PROJECT
AS BUILT PLAN
Milbeck
22a Winchester Street
Botley, Hampshire

CLIENT
Mrs E. Cowlshaw

SCALE
1:50 1:500 1:1250 (A1)

DRAWN
P.T.E MCIAT

DATE
13/23/01

CHECKED
-

REVISION
000000