




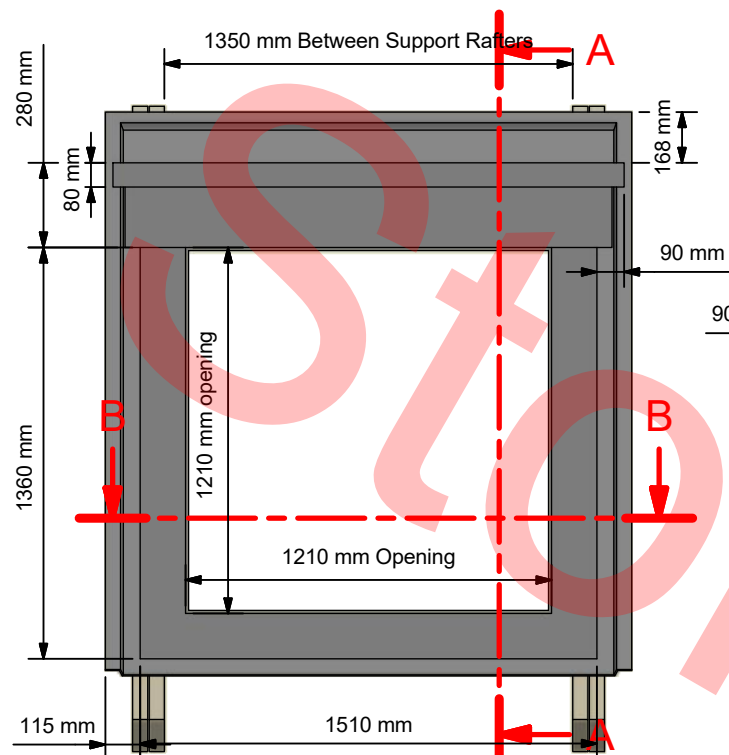



Front Elevation (1 : 25)

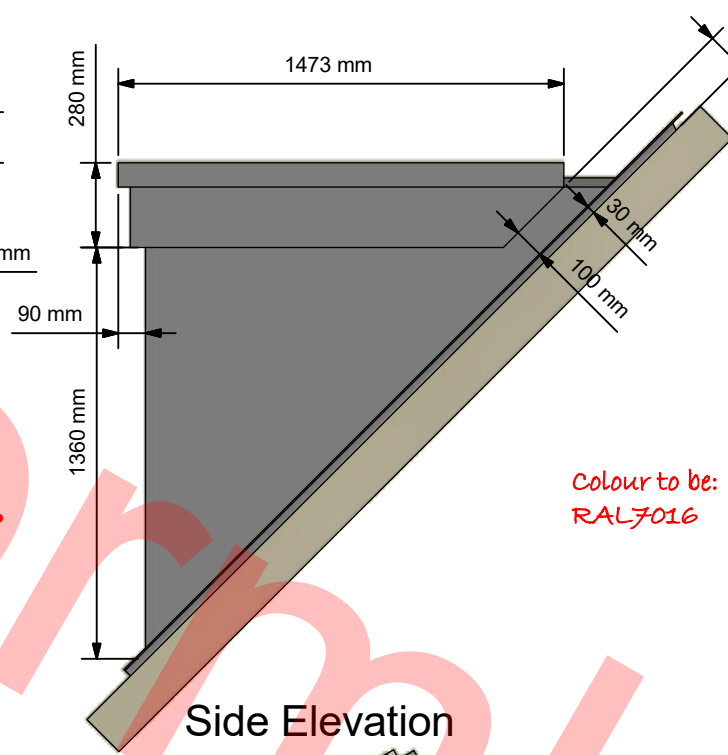

Side Elevation

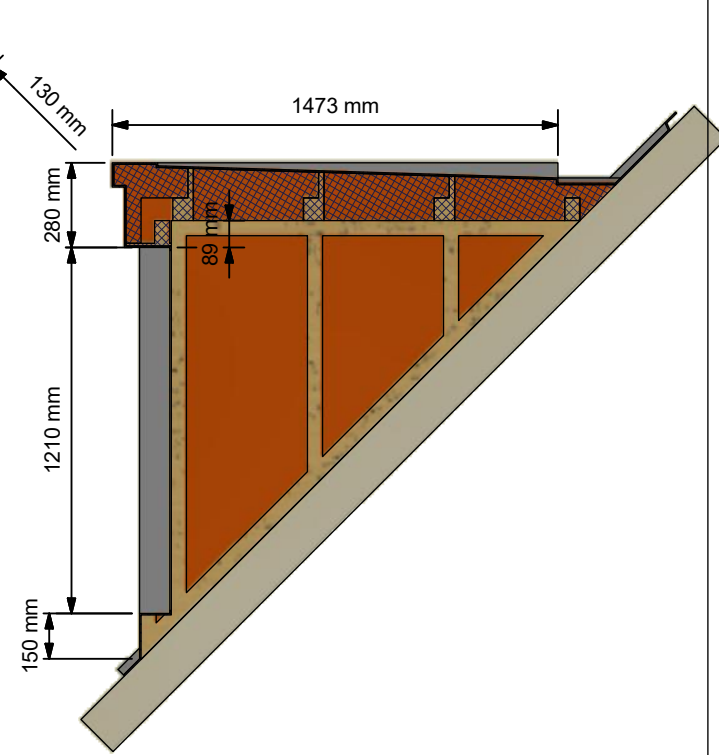

A-A (1 : 25)

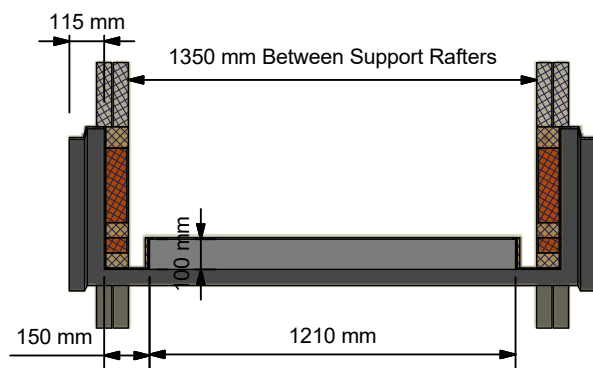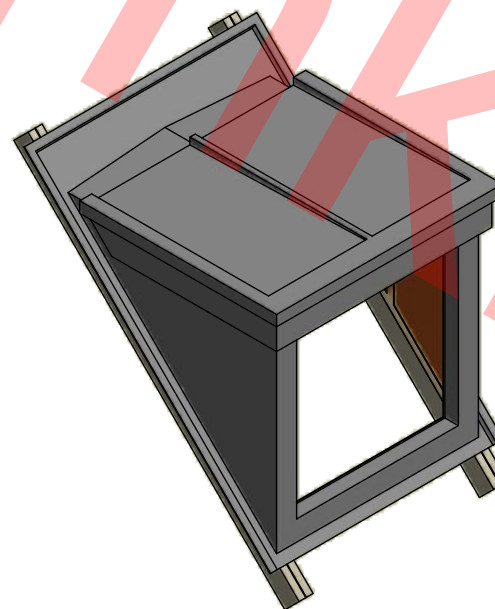

B-B (1 : 25)

B.3	Sections Added	07/09/2018	danpriest
B.2	Fascia Profile Amended For New Tool	17/02/2015	danpriest
B.1	1st Production Issue	13/01/2014	danpriest
B	Correct Window Opening Size Shown	13/01/2014	danpriest
A	Redrawn	13/01/2014	danpriest
REV	DESCRIPTION	DATE	AUTHOR

REVISION HISTORY

Description

Dormer FT45 - 12,12

Designed by

danpriest

Date

13/01/2014

Manufacture Notes

1. As Built

Scale

Checked

GP

Approved

DP

Date

13/01/2014

Drawing Number

3383

Manuf. App

PO

Manuf. App

07/09/2018

Sheet

1

Of

1

Revision

B.3