
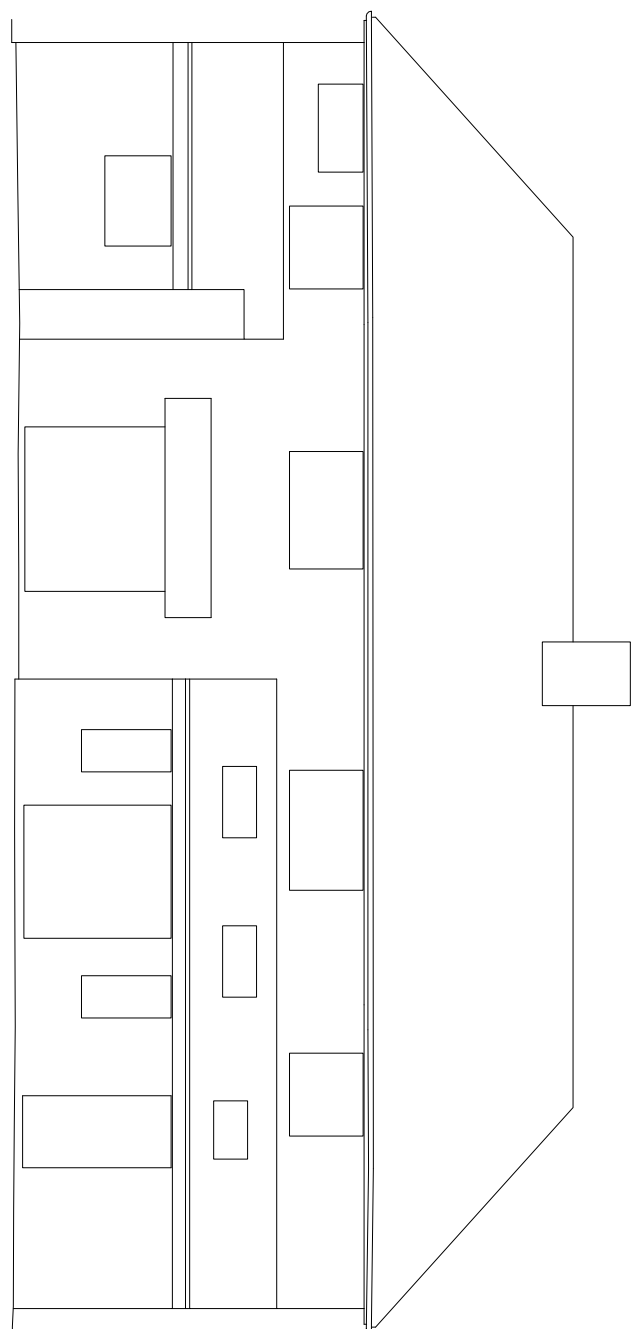
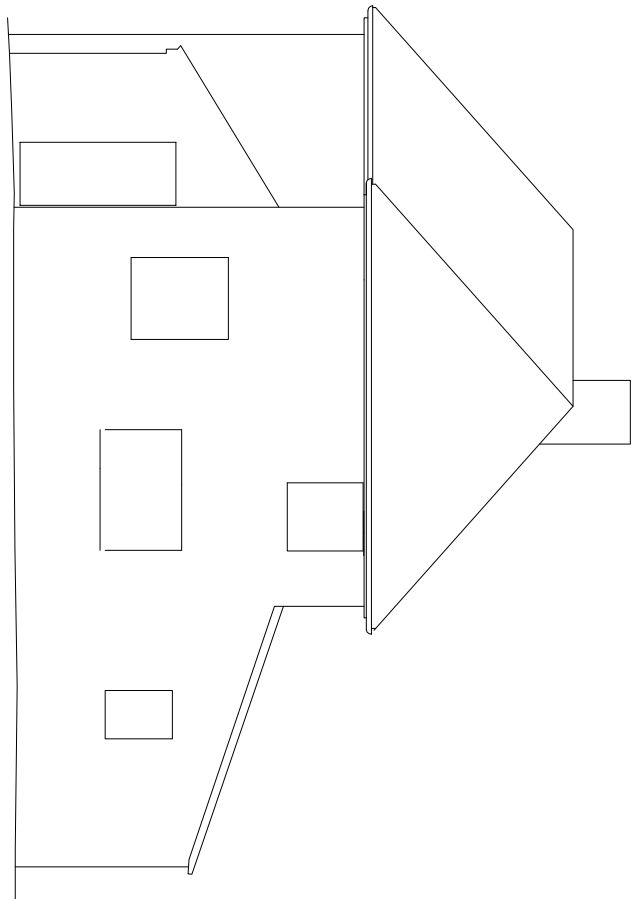
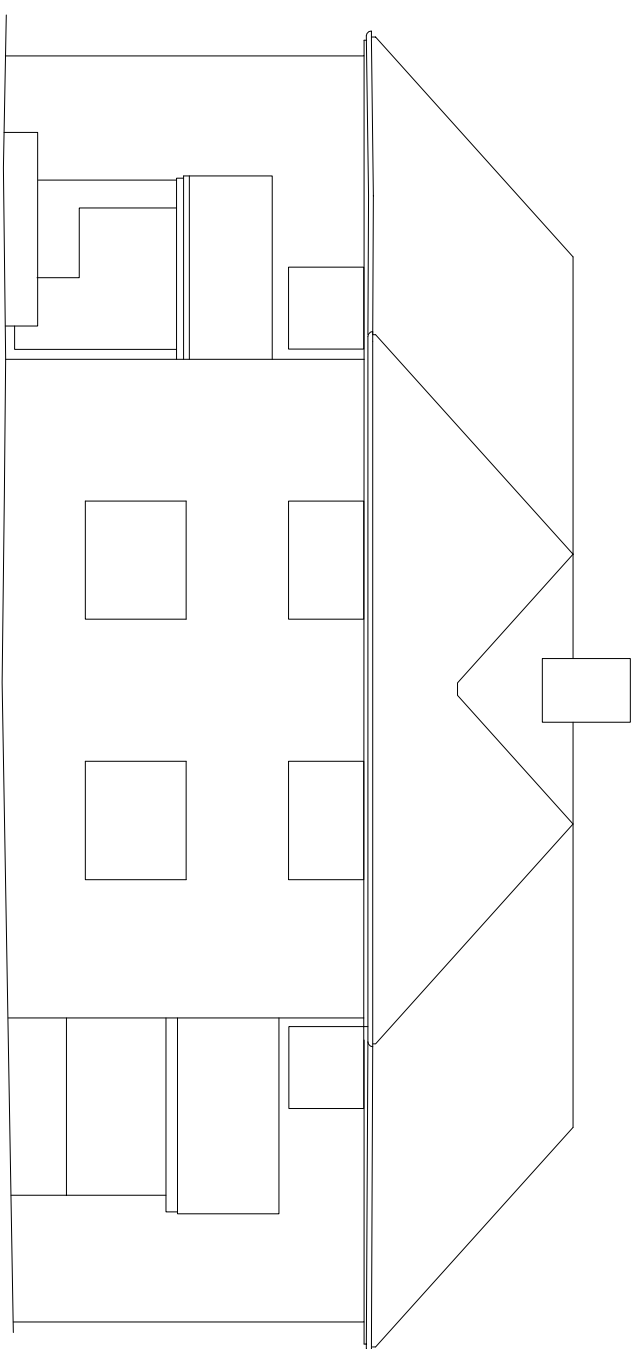
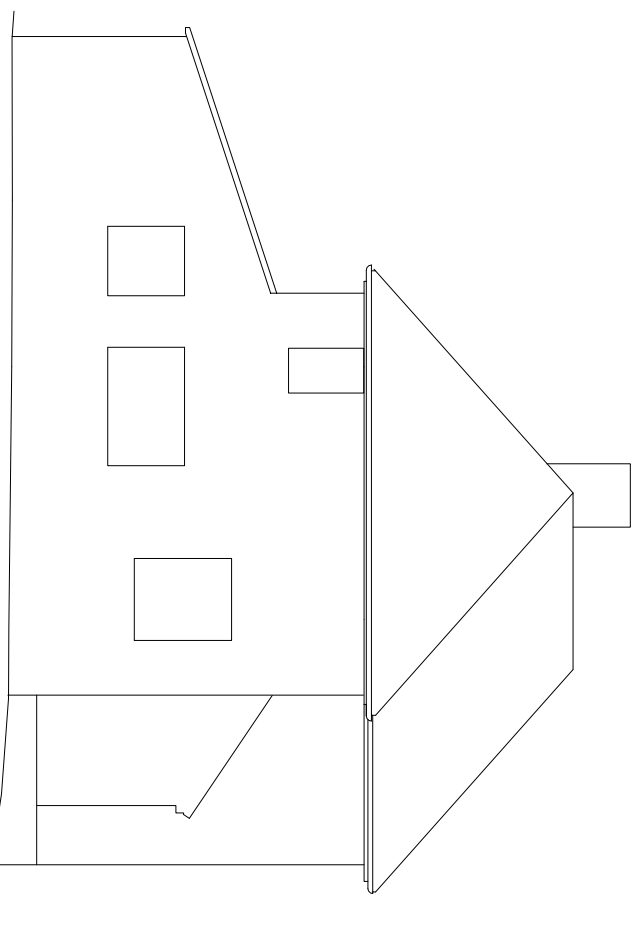
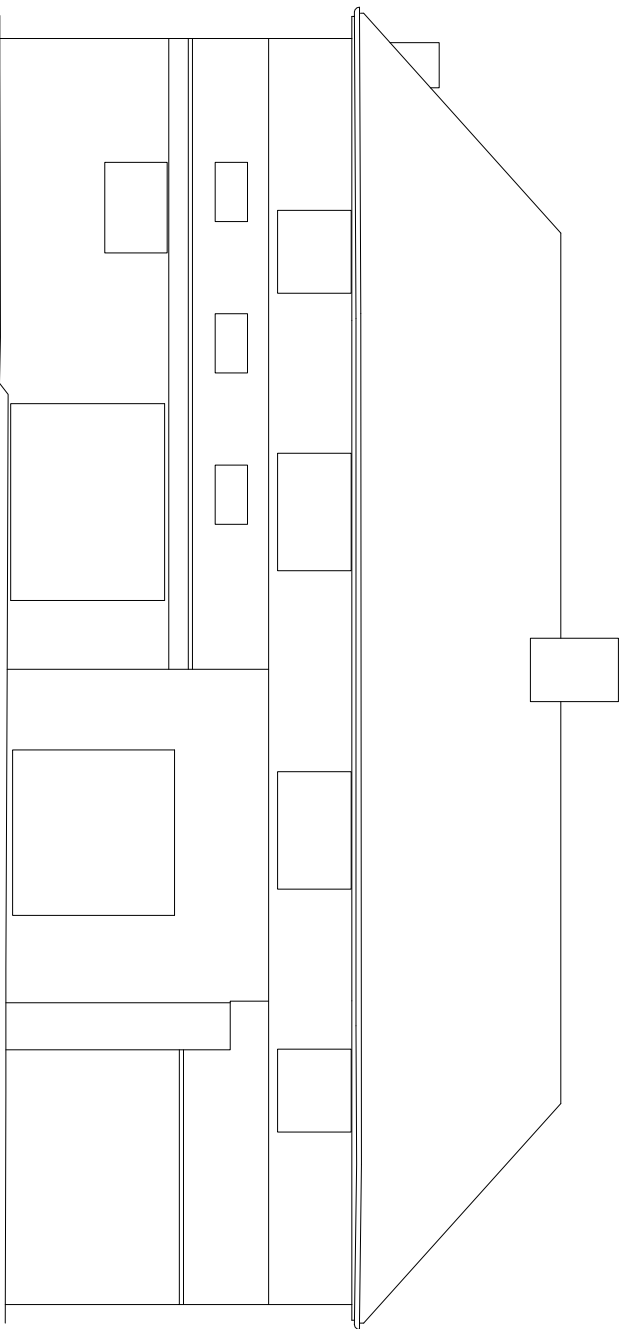
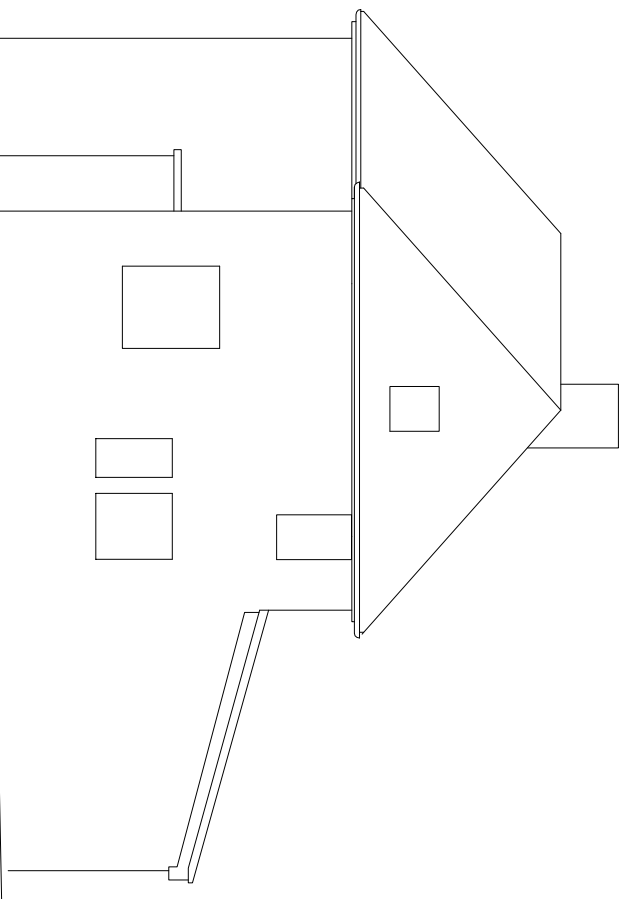
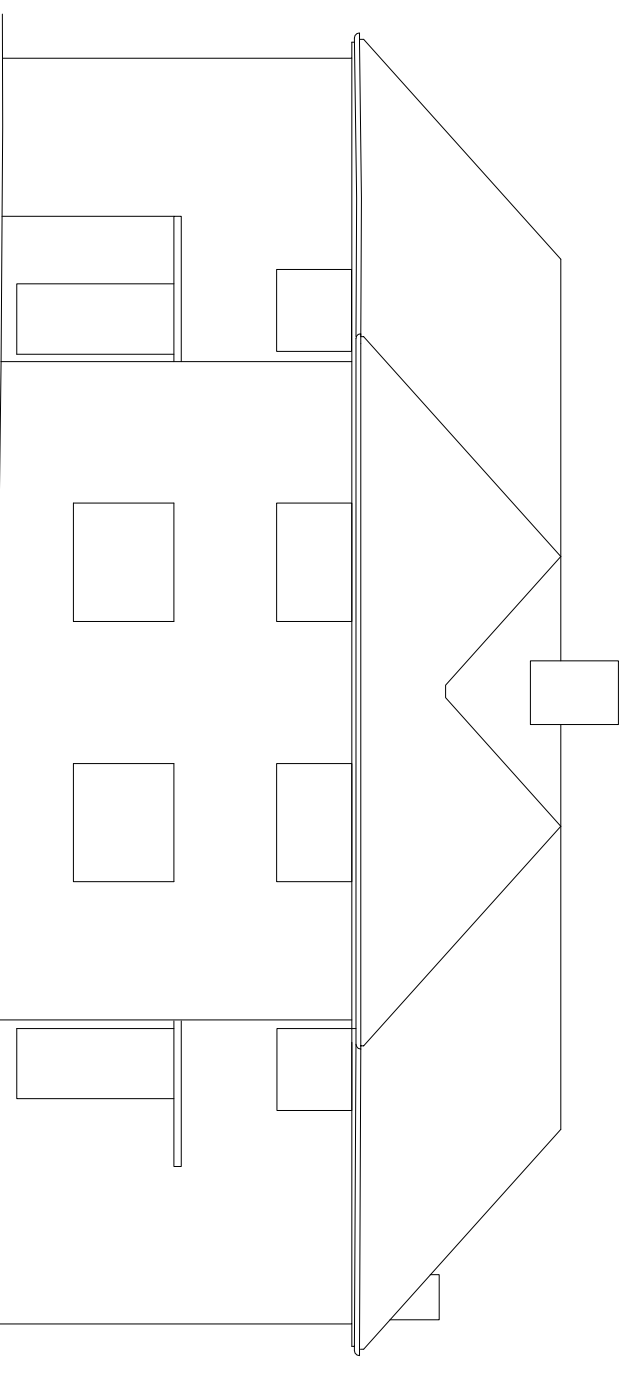


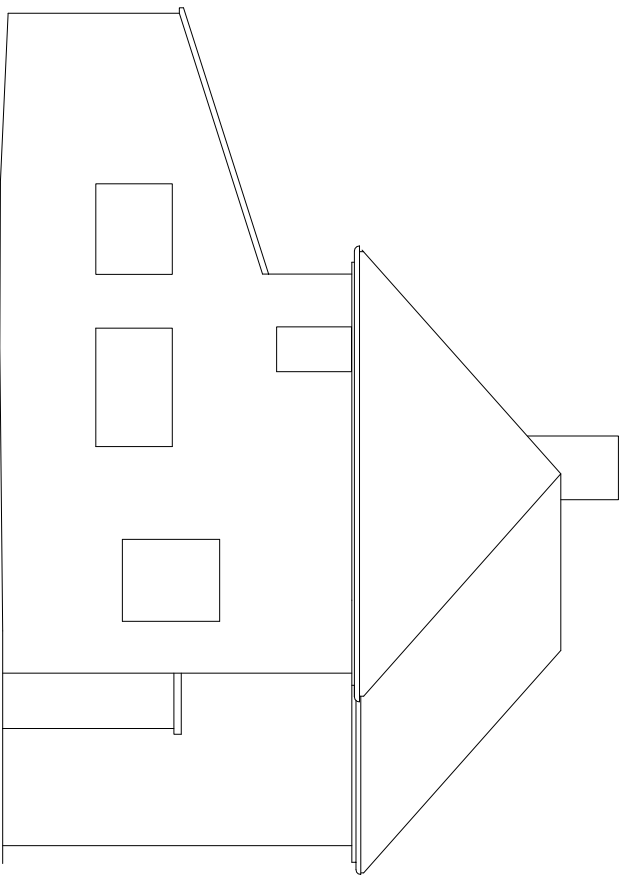

			
The Manor Stables, Great Southfield, Cheltenham Withington, SN15 5EH.			
Email: admin@surveys.co.uk Website: www.surveys.co.uk		Tel: 01290 750645 Fax: 01290 721134	
Topographic Surveys Elevation Surveys Floor Plan Surveys Valuations Surveys		As Built Drawings Surveys Construction of Site Layouts Referred Photo Elevations C.A.D Plotting Bureau	
Project Name: 2-5 Romney Close Eastleigh			
Drawing Title: Basic Elevations			
Client: Churchill Retirement Living Agent: www.churchill.co.uk			
Date:	June 2023		Scale: As @ 1:100
Drawn	Surveyor	Dwg No	Revision
KJH	SCB	EL-2-5-01	
Site Datum	OSBM Ref		
Grid Orientation			Sheet ID
NA			CHURCHILL-EASTLEIGH-ROMNEY
Disclaimer D & H Surveys will Guarantee that this Survey Data & Station Coordinates are Correct to the Indicated Scale ONLY Copyright of this Drawing Remains With D & H Surveys.			