

GAS PIPE AS-LAID LEGEND

- EXISTING MP MAIN
- EXISTING LP MAIN
- MAIN TO BE INSTALLED
- MP MAIN INSTALLED PREVIOUS DRAWING ISSUES
- MP MAIN INSTALLED THIS ISSUE
- LP MAIN INSTALLED THIS ISSUE

GAS AS-LAID LEGEND

- CAP END
- REDUCER
- GAS CABINET
- VALVE L/P
- VALVE M/P
- ABANDON

OTHER INFORMATION

34 PLOT NUMBER CONNECTED

QUANTITIES (MAINS PIPE ONLY)

(TOTALS DO NOT INCLUDE SERVICE PIPES)

DIAMETRE OF PIPE	TO BE INSTALLED	%AGE	INSTALLED THIS ISSUE	%AGE	PREVIOUSLY INSTALLED	%AGE	TOTAL
63mm	0.0M	0	1467.8M	100	0.0M	0	1467.8M
90mm	0.0M	0	112.0M	100	0.0M	0	112.0M
125mm	0.0M	0	162.2M	100	0.0M	0	162.2M
180mm	0.0M	0	192.4M	100	0.0M	0	192.4M
TOTAL	0.0M	0	1934.4M	100	0.0M	0	1934.4M


PLOTS CONNECTED - BY PLOT NUMBER

DWG REV	PLOTS CONNECTED	TOTAL
A	ALL - 166No. - 100%	100%

Notes:

GENERAL

- THE INFORMATION SHOWN ON THIS PLAN IS GIVEN WITHOUT OBLIGATION OR WARRANTY. THE ACCURACY THEREOF CANNOT BE GUARANTEED. WHERE SERVICES PIPES ARE SHOWN, THEIR POSITION IS APPROXIMATE. NO LIABILITY OF ANY KIND WHATSOEVER IS ACCEPTED BY THE COMPANY, ITS AGENTS OR SERVANTS FOR ANY ERROR OR OMISSION. THE ACTUAL POSITION OF MAINS MUST BE VERIFIED AND ESTABLISHED ON SITE BEFORE ANY EXCAVATIONS ARE CARRIED OUT OR ANY MECHANICAL PLANT USED.
- THE DEPTH AND POSITION OF ALL SERVICE / DISTRIBUTION EQUIPMENT INSTALLED ARE TAKEN AT THE TIME OF INSTALLATION. HOWEVER, THIRD PARTIES MAY HAVE ALTERED THE LEVELS AND OTHER REFERENCE DATA.
- UNLESS OTHERWISE SPECIFIED ALL MAINS WERE BURIED TO A DEPTH OF 900MM

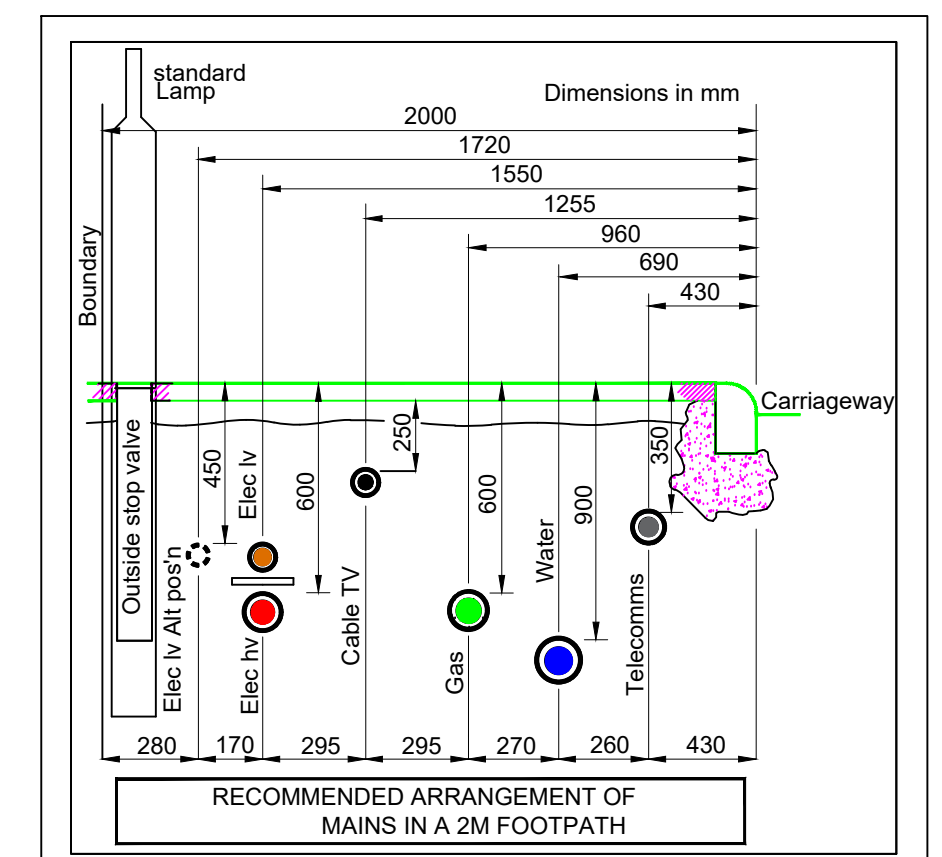

A	AS LAID INFORMATION ADDED	MJW	11/12/20
REV:	DESCRIPTION:	BY:	DATE:

FULCRUM
NETWORK REF: 9018696



CONNECT IT UTILITY SERVICES LTD
Foundation House, Unit C (West)
Hamilton Business Park, Hamilton Way,
Hedge End, Southampton SO30 2JR.

SITE: BERRY FARM, MONARCHS KEEP
HAMBLE LANE, SOUTHAMPTON
SO31 8EL

DRAWING TITLE: GAS AS LAID			
SCALE @A1: 1:500	DATE: 11/12/20	DRAWN: MJW	REVIEWED: CL
DRAWING NUMBER: DWG No		REVISION: A	