


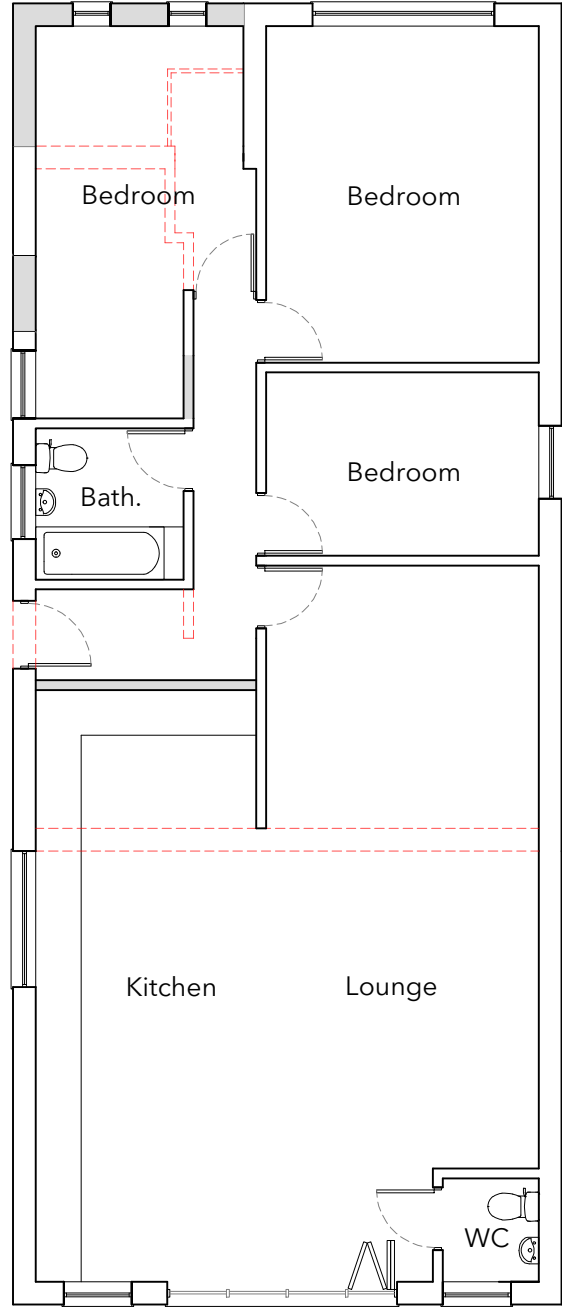


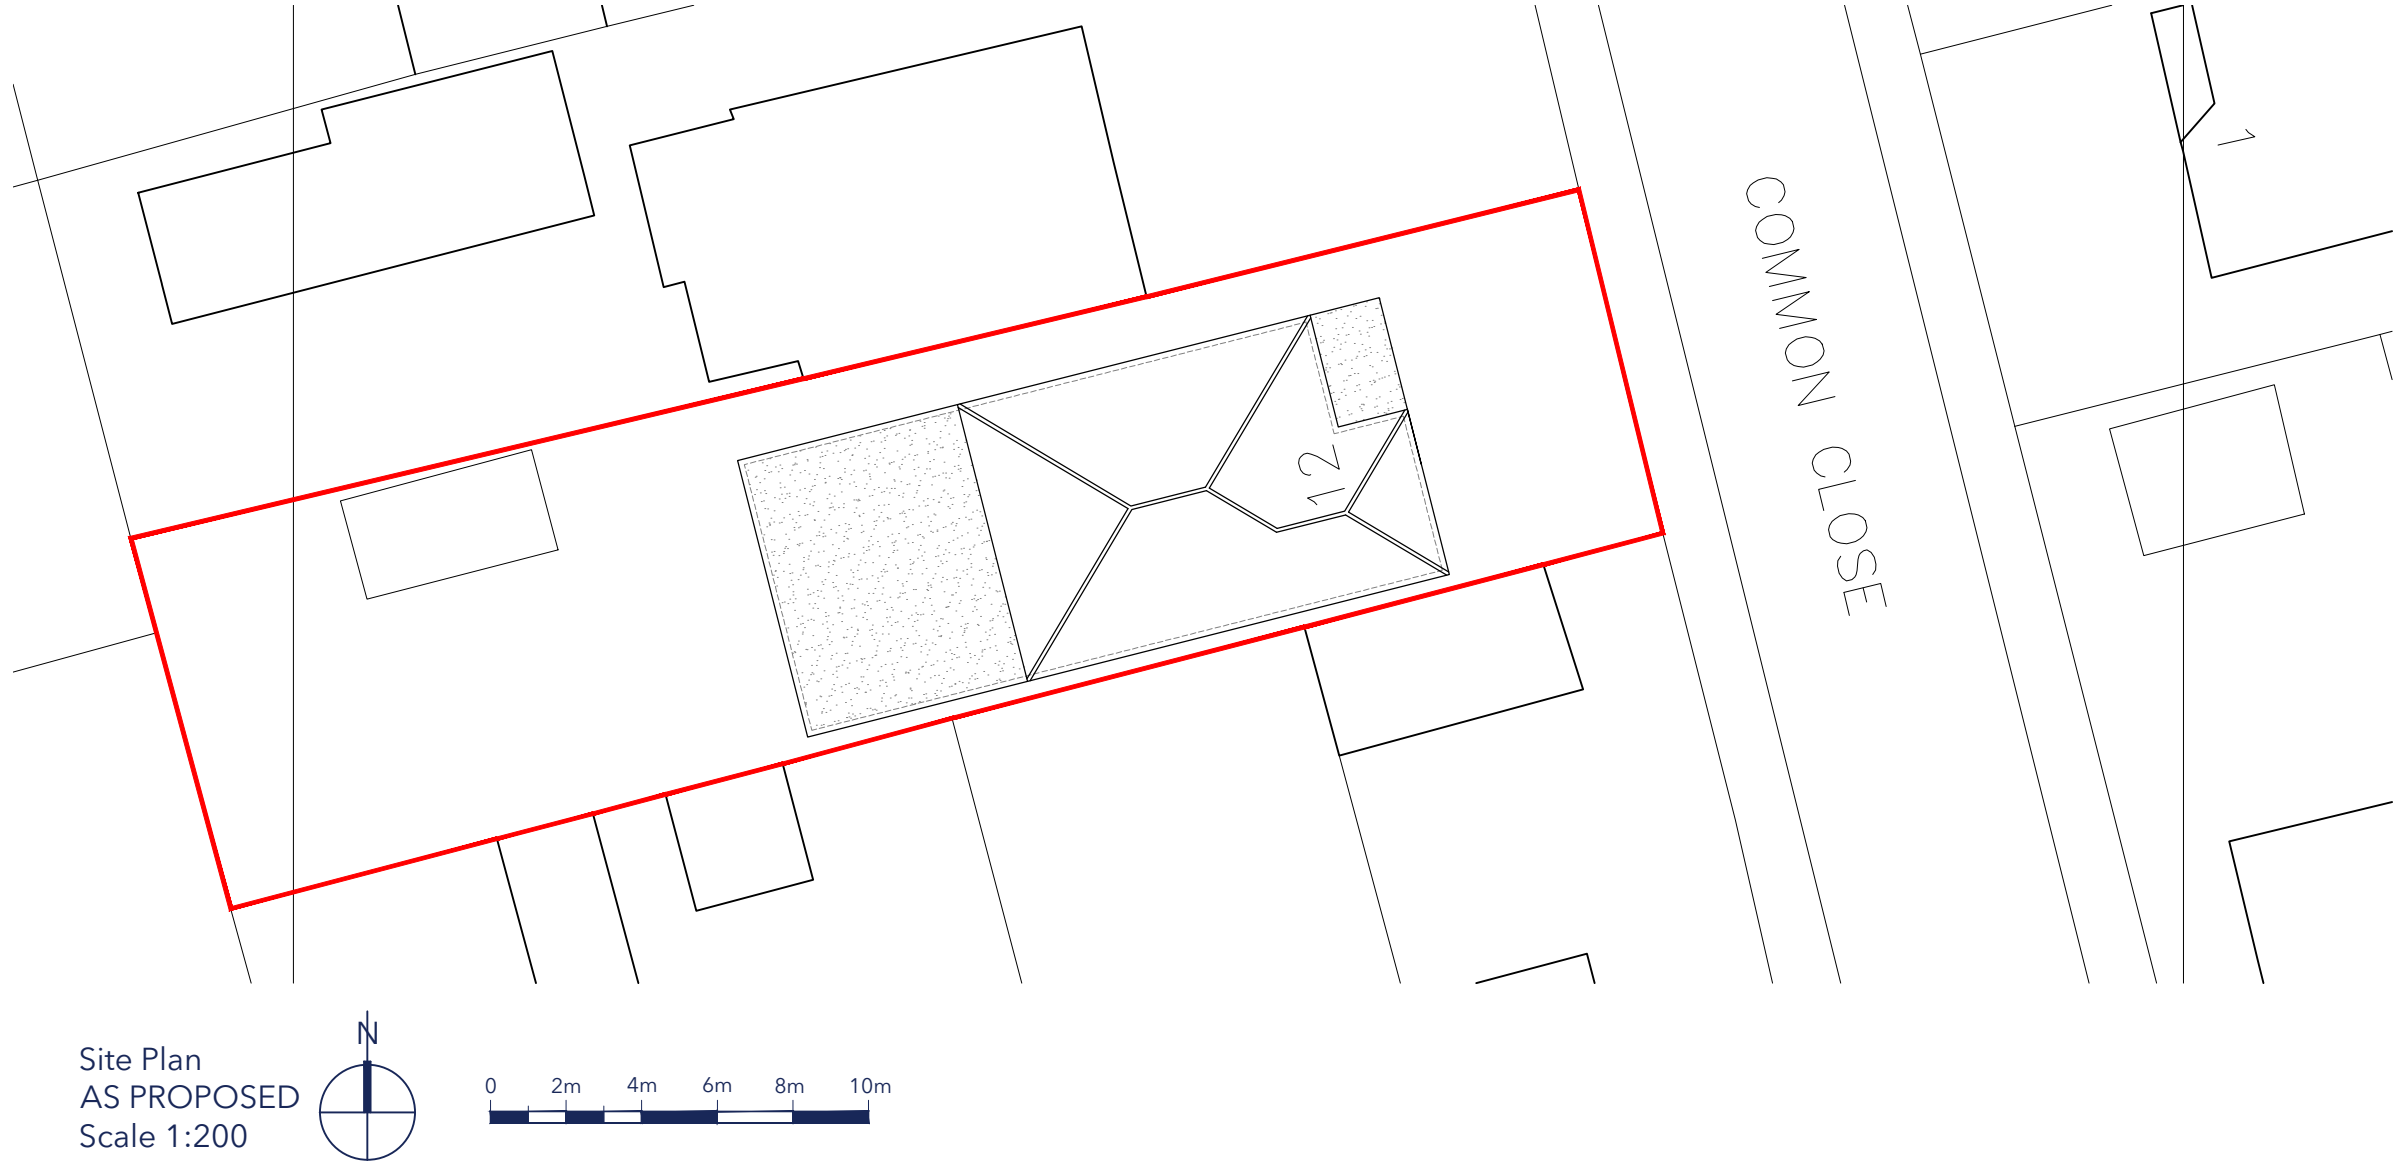


Ground Floor Plan

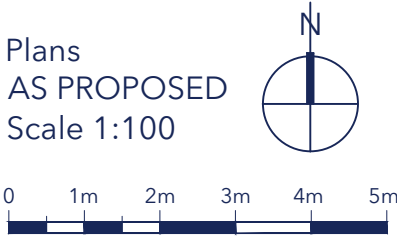


Site Plan
AS PROPOSED
Scale 1:200

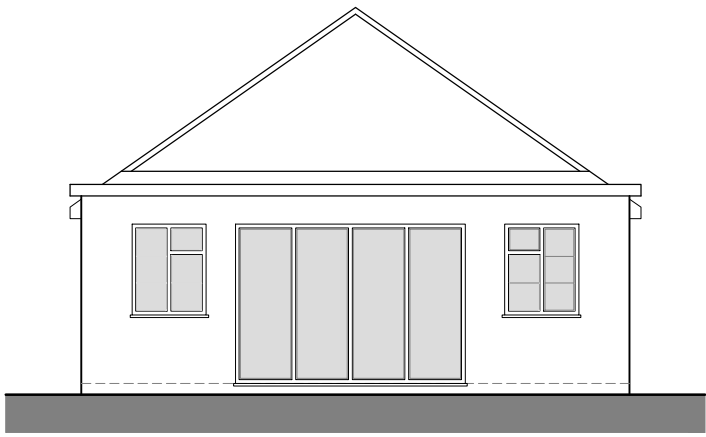


Rear Elevation

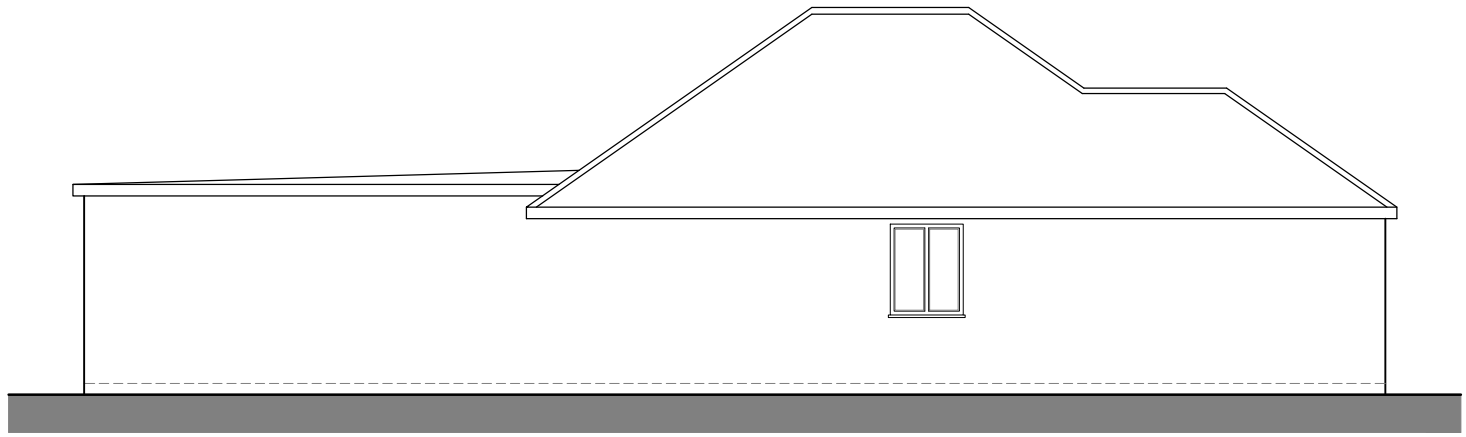

Side Elevation

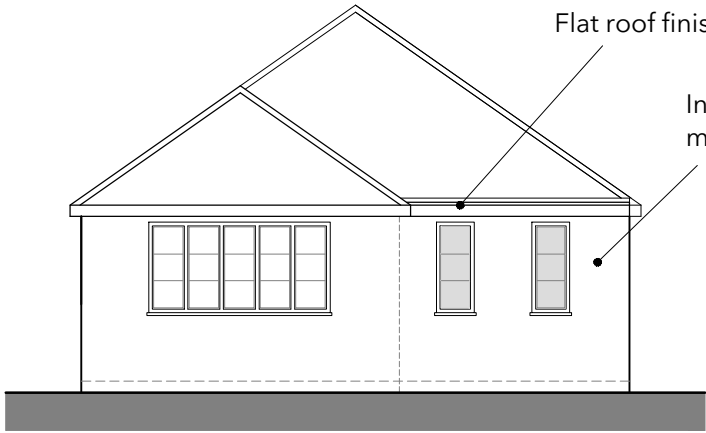

Front Elevation

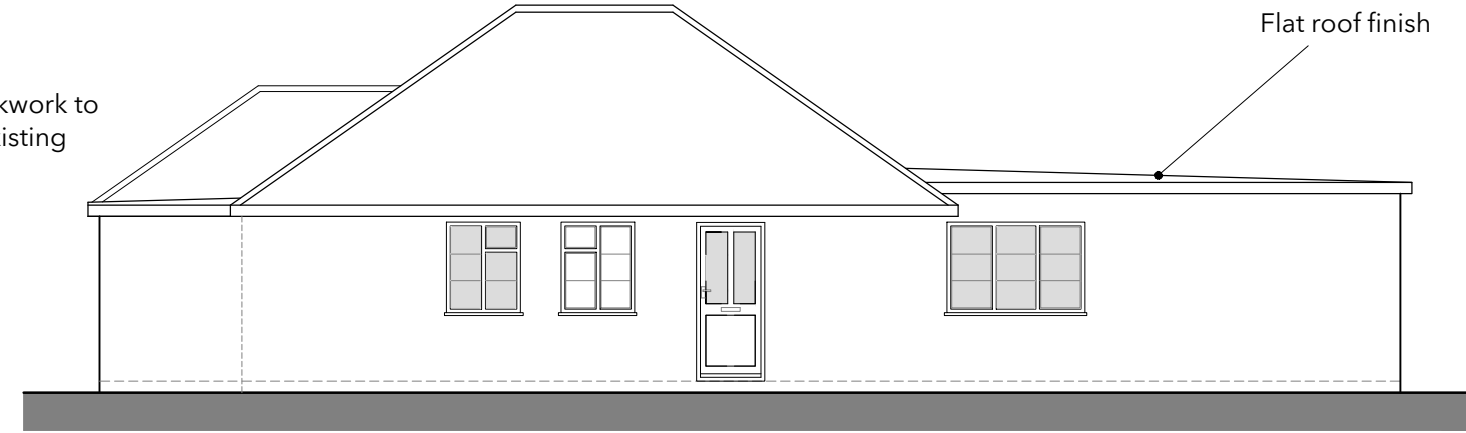

Side Elevation

Elevations
AS PROPOSED
Scale 1:100



No.	Description	Date
E	As Built	12.09.23
D	Flat Roof Amendments	22.08.23
C	General Amendments	14.07.23
B	General Amendments	18.05.23
A	General Amendments	25.04.23

studio

t. 02382 542011
e. info@rs-studio.co.uk
w. www.rs-studio.co.uk

Drawing Title:
Householder Planning
AS PROPOSED

Project Title:
12 Common Close
Chandlers Ford
SO53 1HF

Drawing No.:
1606-P-03

Date: March 2023

Scale: various

Drawn: RS

Checked: LD

This drawing is the copyright of the company and must not be reproduced or used without permission. Annotated dimensions are to be taken in preference to scaled dimensions and site dimensions must be checked before work is commenced