
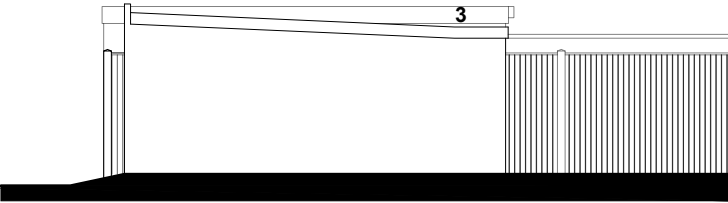
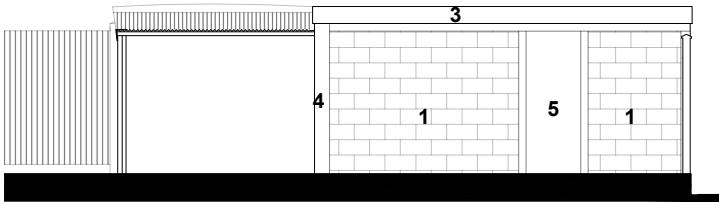
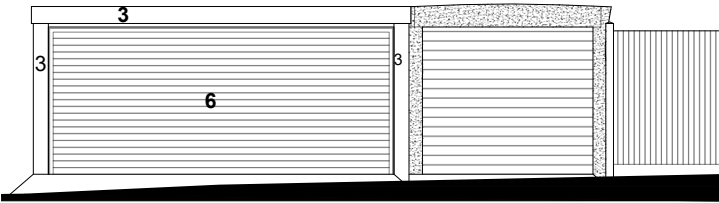


1 **SOUTHEASTERN ELEVATION - AS-APPROVED**
F/24/98018
scale - 1:100

2 **SOUTHWESTERN ELEVATION - AS-APPROVED**
F/24/98018
scale - 1:100

3 **NORTHWESTERN ELEVATION - AS-APPROVED**
F/24/98018
scale - 1:100

4 **NORTHEASTERN ELEVATION - AS-APPROVED**
F/24/98018
scale - 1:100

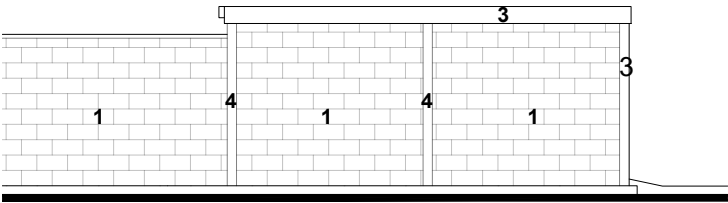

5 **SOUTHEASTERN ELEVATION - AS-BUILT**
scale - 1:100

6 **SOUTHWESTERN ELEVATION - AS-BUILT**
scale - 1:100

7 **NORTHWESTERN ELEVATION - AS-BUILT**
scale - 1:100

4 **NORTHEASTERN ELEVATION - AS-BUILT**
scale - 1:100

0 1m 2m 3m 4m 5m
1:100

- This drawing is the copyright of ATP Architectural Design and is not to be reproduced in any way without prior written consent.
- Use given dimensions over scaling, do not scale from this drawing unless for local authority purposes.
- Dimensions to be checked on site prior to works with any discrepancies to be reported immediately.
- This drawing should be read in conjunction with other consultant drawings, specifications and calculations.
- The client must abide by the construction design and management regulations 2015.
- The client must abide by the requirements of the party wall act 1996.
- The building owner has a duty under the requirements of the party wall act 1996.
- All materials and workmanship must comply with regulation 7 of the building regulations.
- If information within drawings & specifications relates to building regulations this is a guide as to what is required to comply with the current building regulations, this does not imply that this is the only acceptable way of achieving building regulations approval.
- No liability is accepted for any loss of any sort or additional expense incurred consequent on any variation to the layout or specification that may be required as a result of site conditions, availability of materials, custom or practice, the requirements of the building inspector or any other circumstances.

MATERIALS

- 140mm fair-faced paint-grade concrete blocks painted, colour Sandtex Mid Stone
- Anti-con metal roof sheets, colour Goosewing grey
- Metal fascia cladding, colour Goosewing grey
- Metal cladding to other areas, colour Sandtex Mid Stone
- Back door, colour Goosewing Grey
- Front garage door, colour white

REV:	DESCRIPTION:	BY:	DATE:

STATUS:
PLANNING

SCALE AT A3:
1:100

DATE:
26/01/2026

DRAWN:
TKP

PROJECT NO:
26484

DRAWING NO:
200.VOC

REVISION:
.

PROJECT:
**GARAGE EXTENSION
VOC OF H/22/92199**

TITLE:
**AS-APPROVED & AS-BUILT
ELEVATIONS**

ADDRESS:
**35 BRACKELEY AVENUE
FAIR OAK
SO50 8FL**

CLIENT:
SHARON SCALES

atp | **ARCHITECTURAL
DESIGN**

info@atpad.co.uk
07590 762966
www.atpad.co.uk