

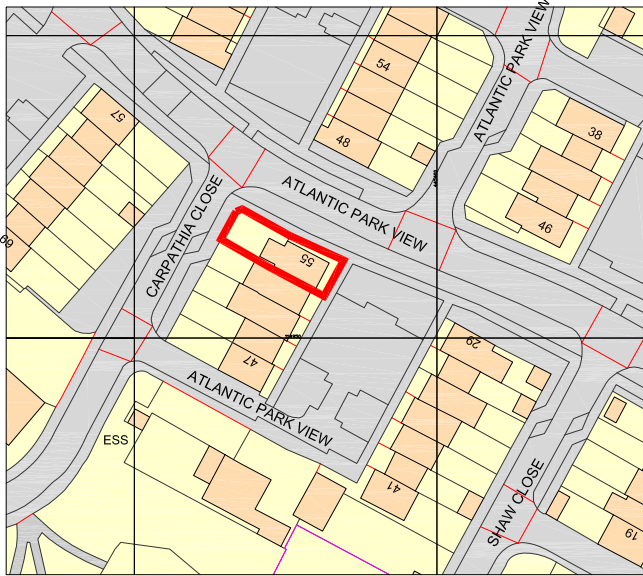



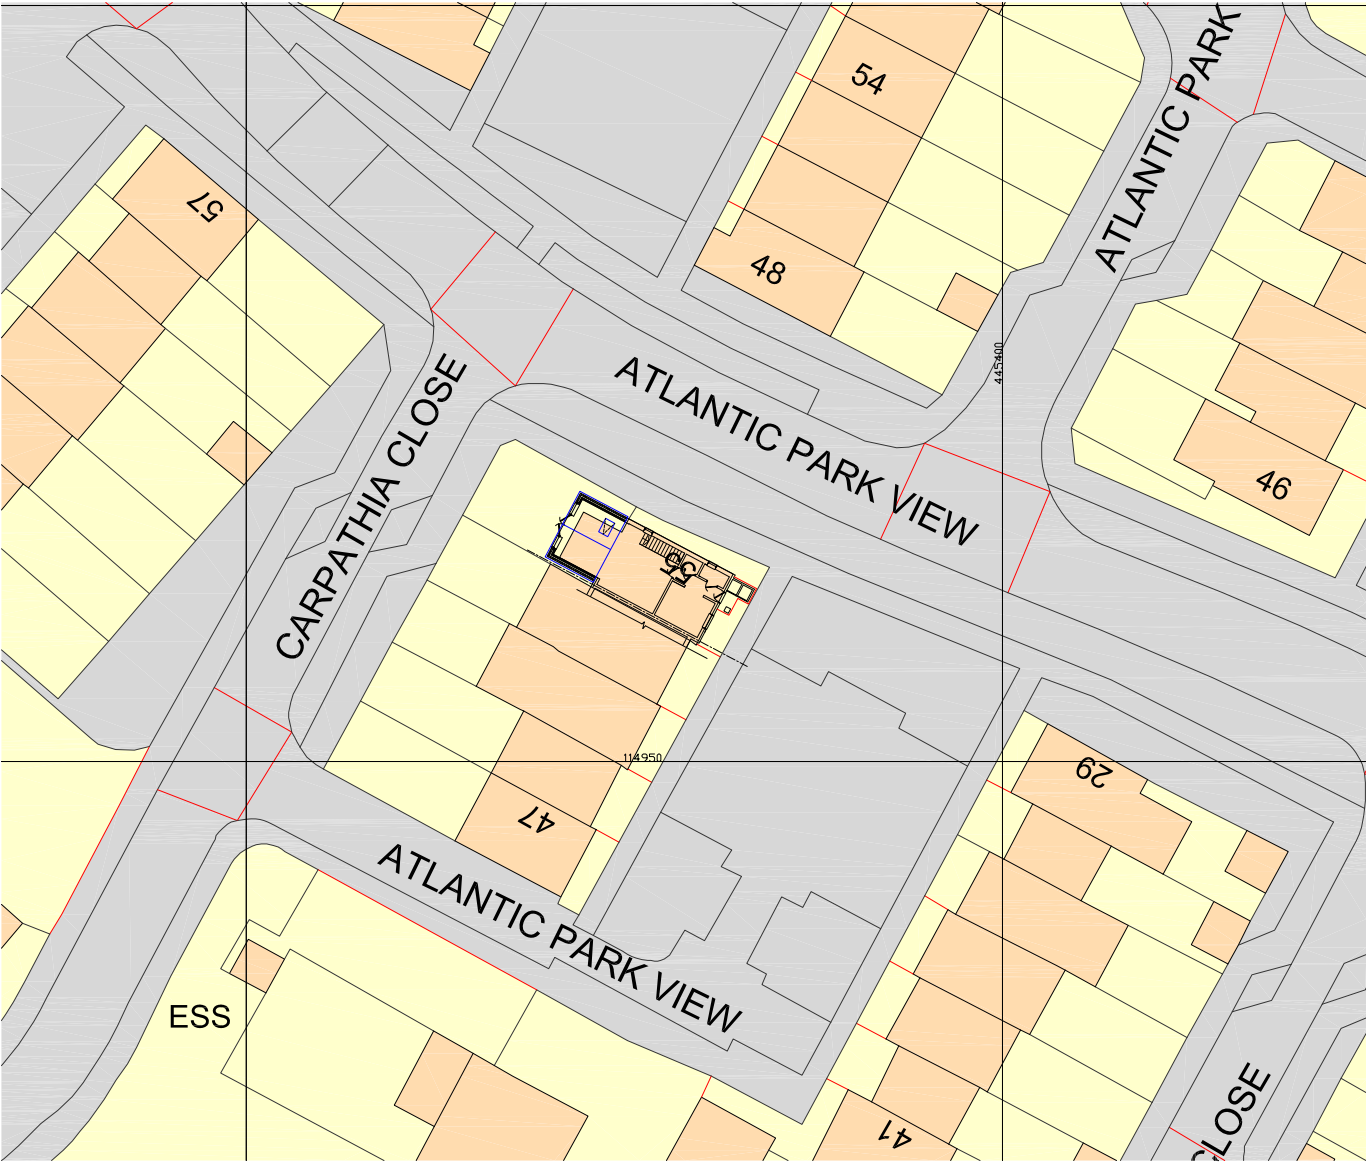


Ordnance Survey, (c) Crown Copyright 2025. All rights reserved. Licence number 100022432


Site Location Plan
Scale 1:1250

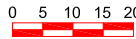


Block Plan as approved
Scale 1:500

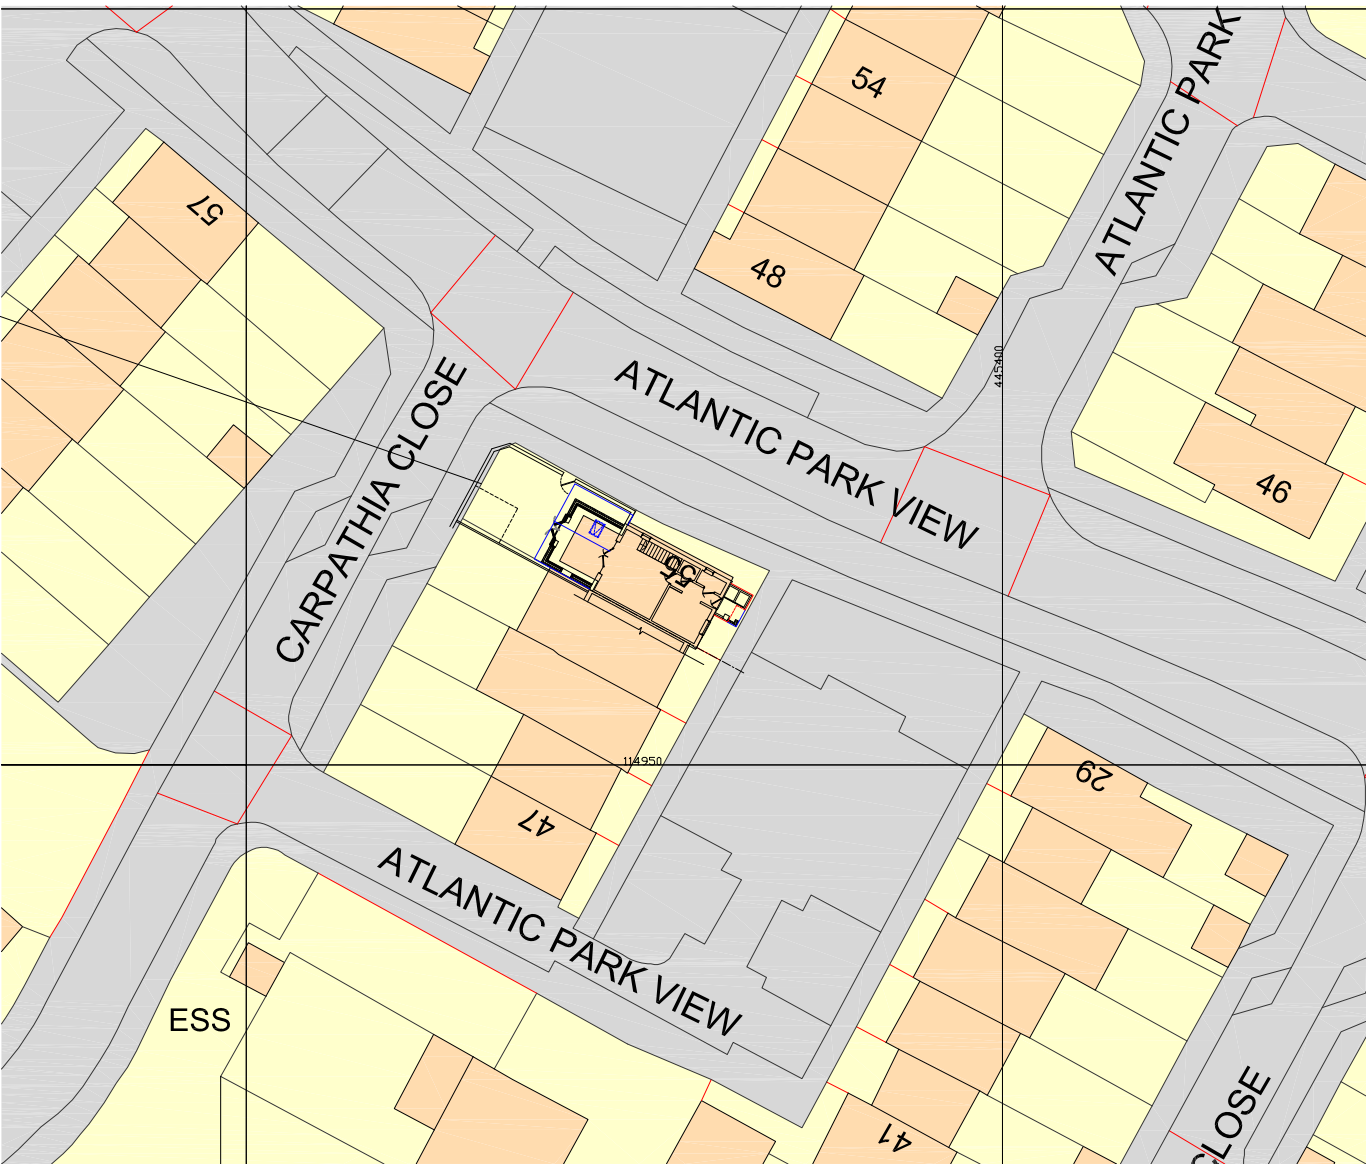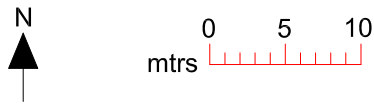

Block Plan as built
Scale 1:500

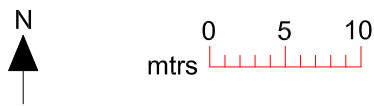

Notes
All dimensions and details to be checked on site by builder prior to commencement of works.
This plan must not be acted upon until it has been approved by the Local Authority.
Client to conform to party wall act of 1996 if required.

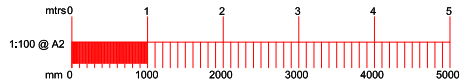

B		
A		
	Date	Revisions

Drawing Title.
Maps

SITE ADDRESS 55 Atlantic Park View West End Southampton SO18 3RR	CLIENT ADDRESS
--	----------------

as noted	PAPER SIZE A2
Scale.	Drawn by. <i>R.N.S.</i>
Date. April 2026	

Sanders Design Services Ltd

95 Cedar Road
Hythe
Southampton
SO45 3PX

www.sandersdesignservices.co.uk
info@sandersdesignservices.co.uk

023 8020 7195

Drawing No	Revision
duhr sht 3	x