




PROPOSED FRONT ELEVATION (NORTH)



PROPOSED SIDE ELEVATION (EAST)



PROPOSED REAR ELEVATION (SOUTH)

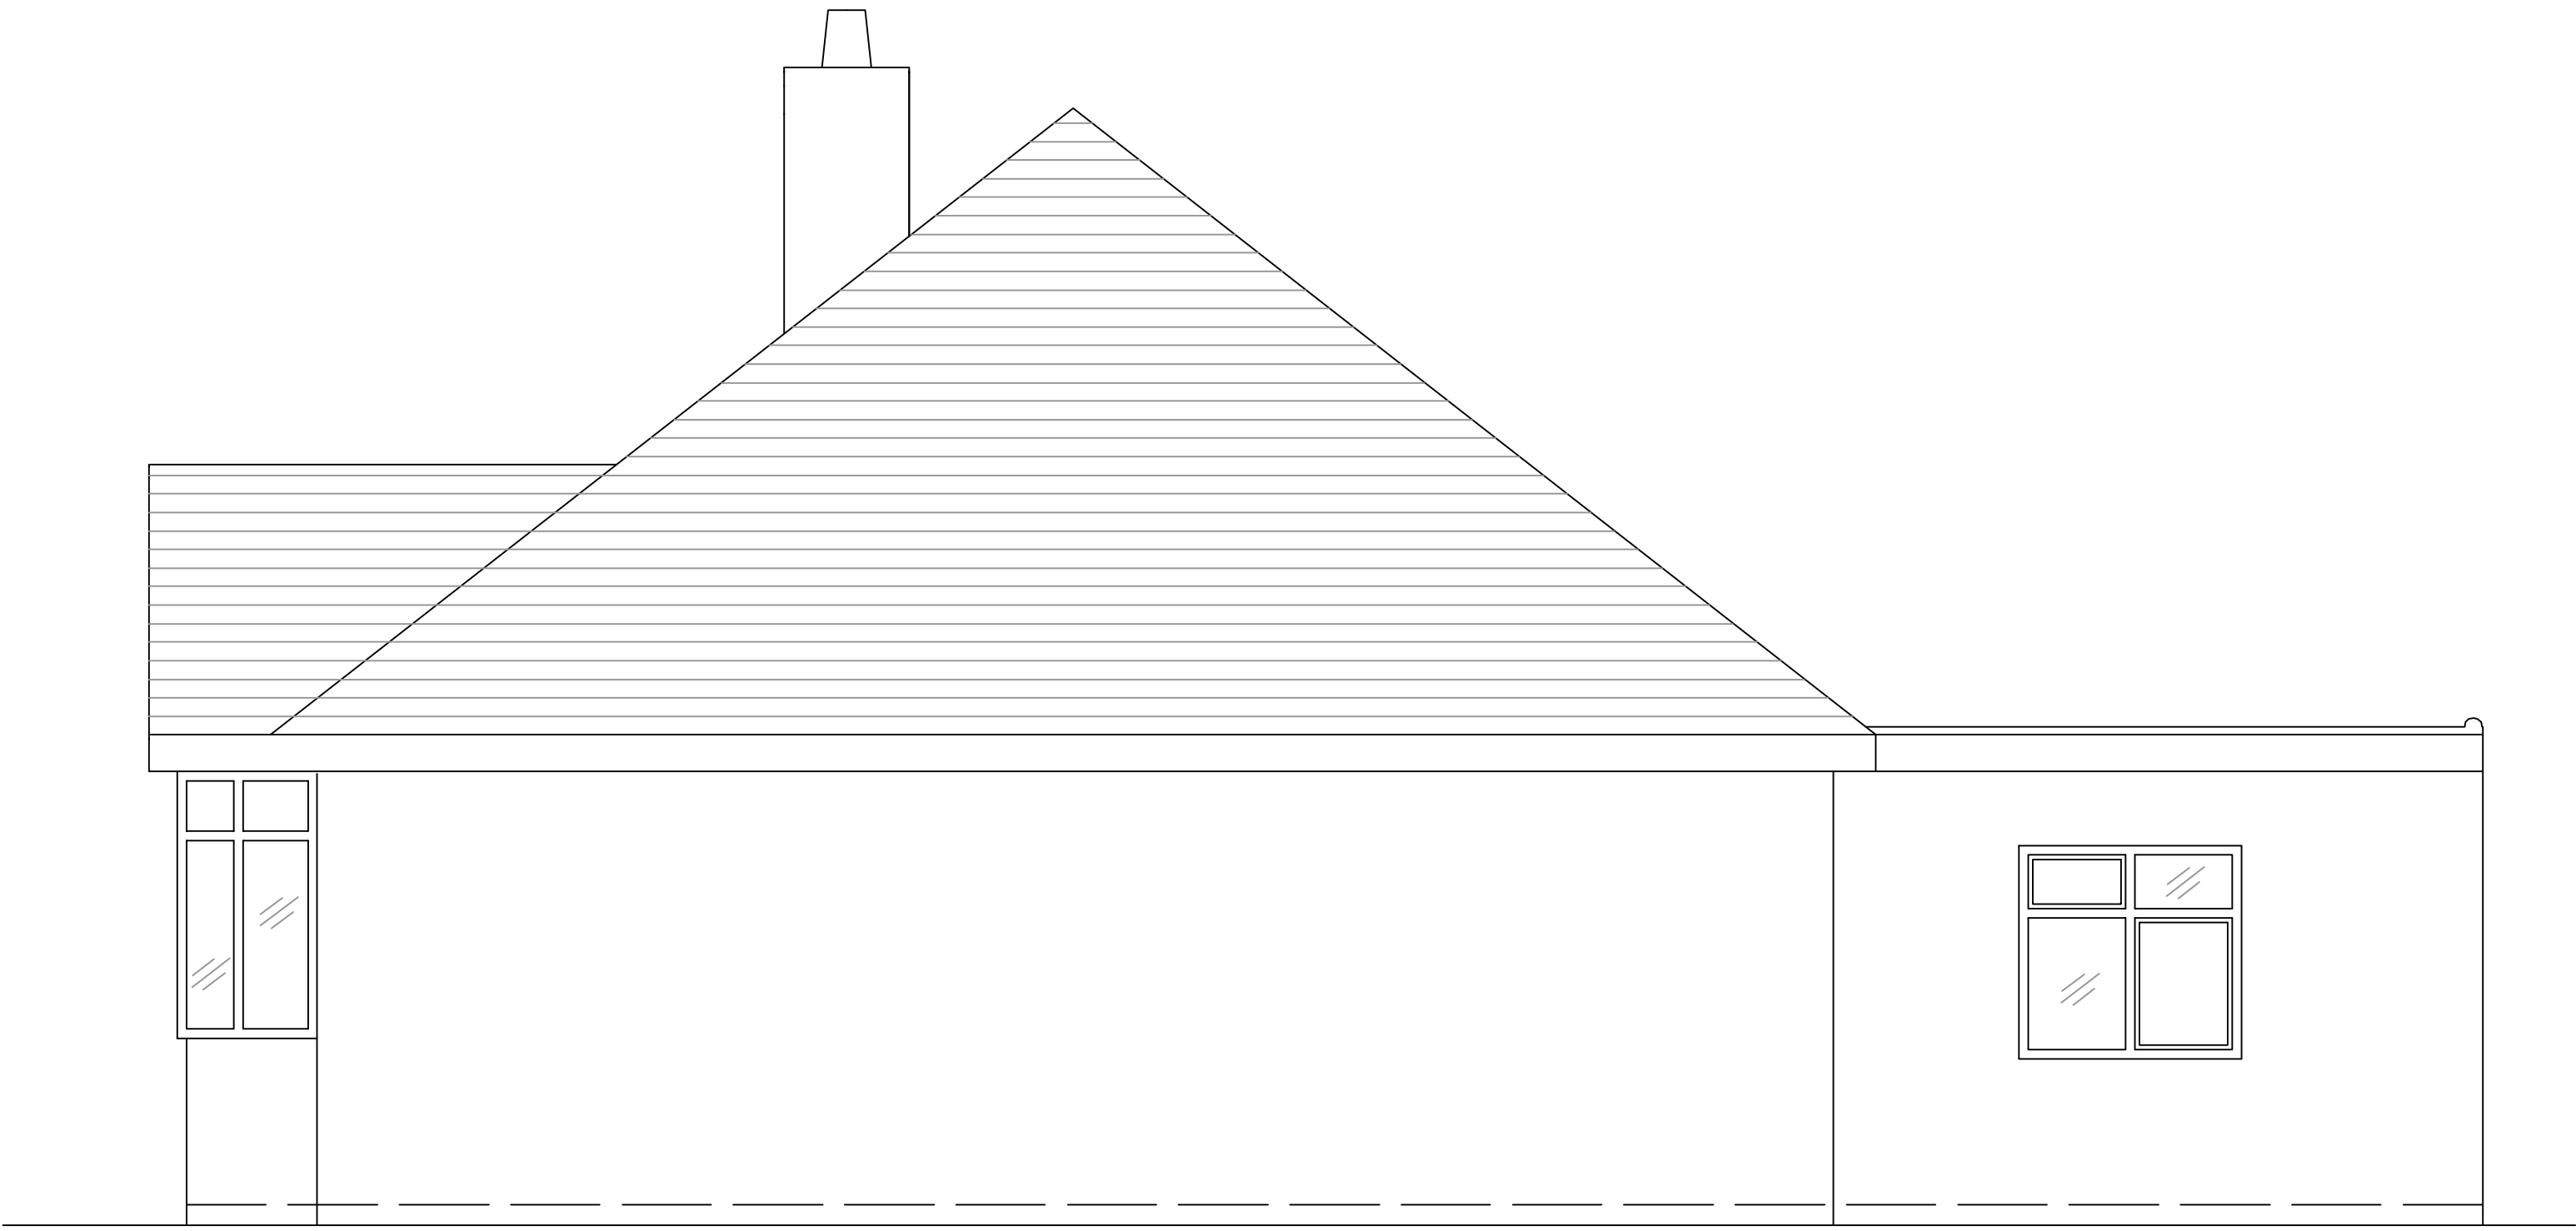

PROPOSED SIDE ELEVATION/SECTION (WEST)



B	06.07.26	As Built Update	AG							
A	16.03.20	Planning Submission	AG							
ISSUE	DATE	REMARKS	DR	CH	PE	MAINT	CE	PRDD	MHG	
Mr Ryan Ellis 45 Mead Road, Southampton, So53 2FB Proposed Elevations										
SCALE 1:100		DRAWING No. 104				ISSUE B				