



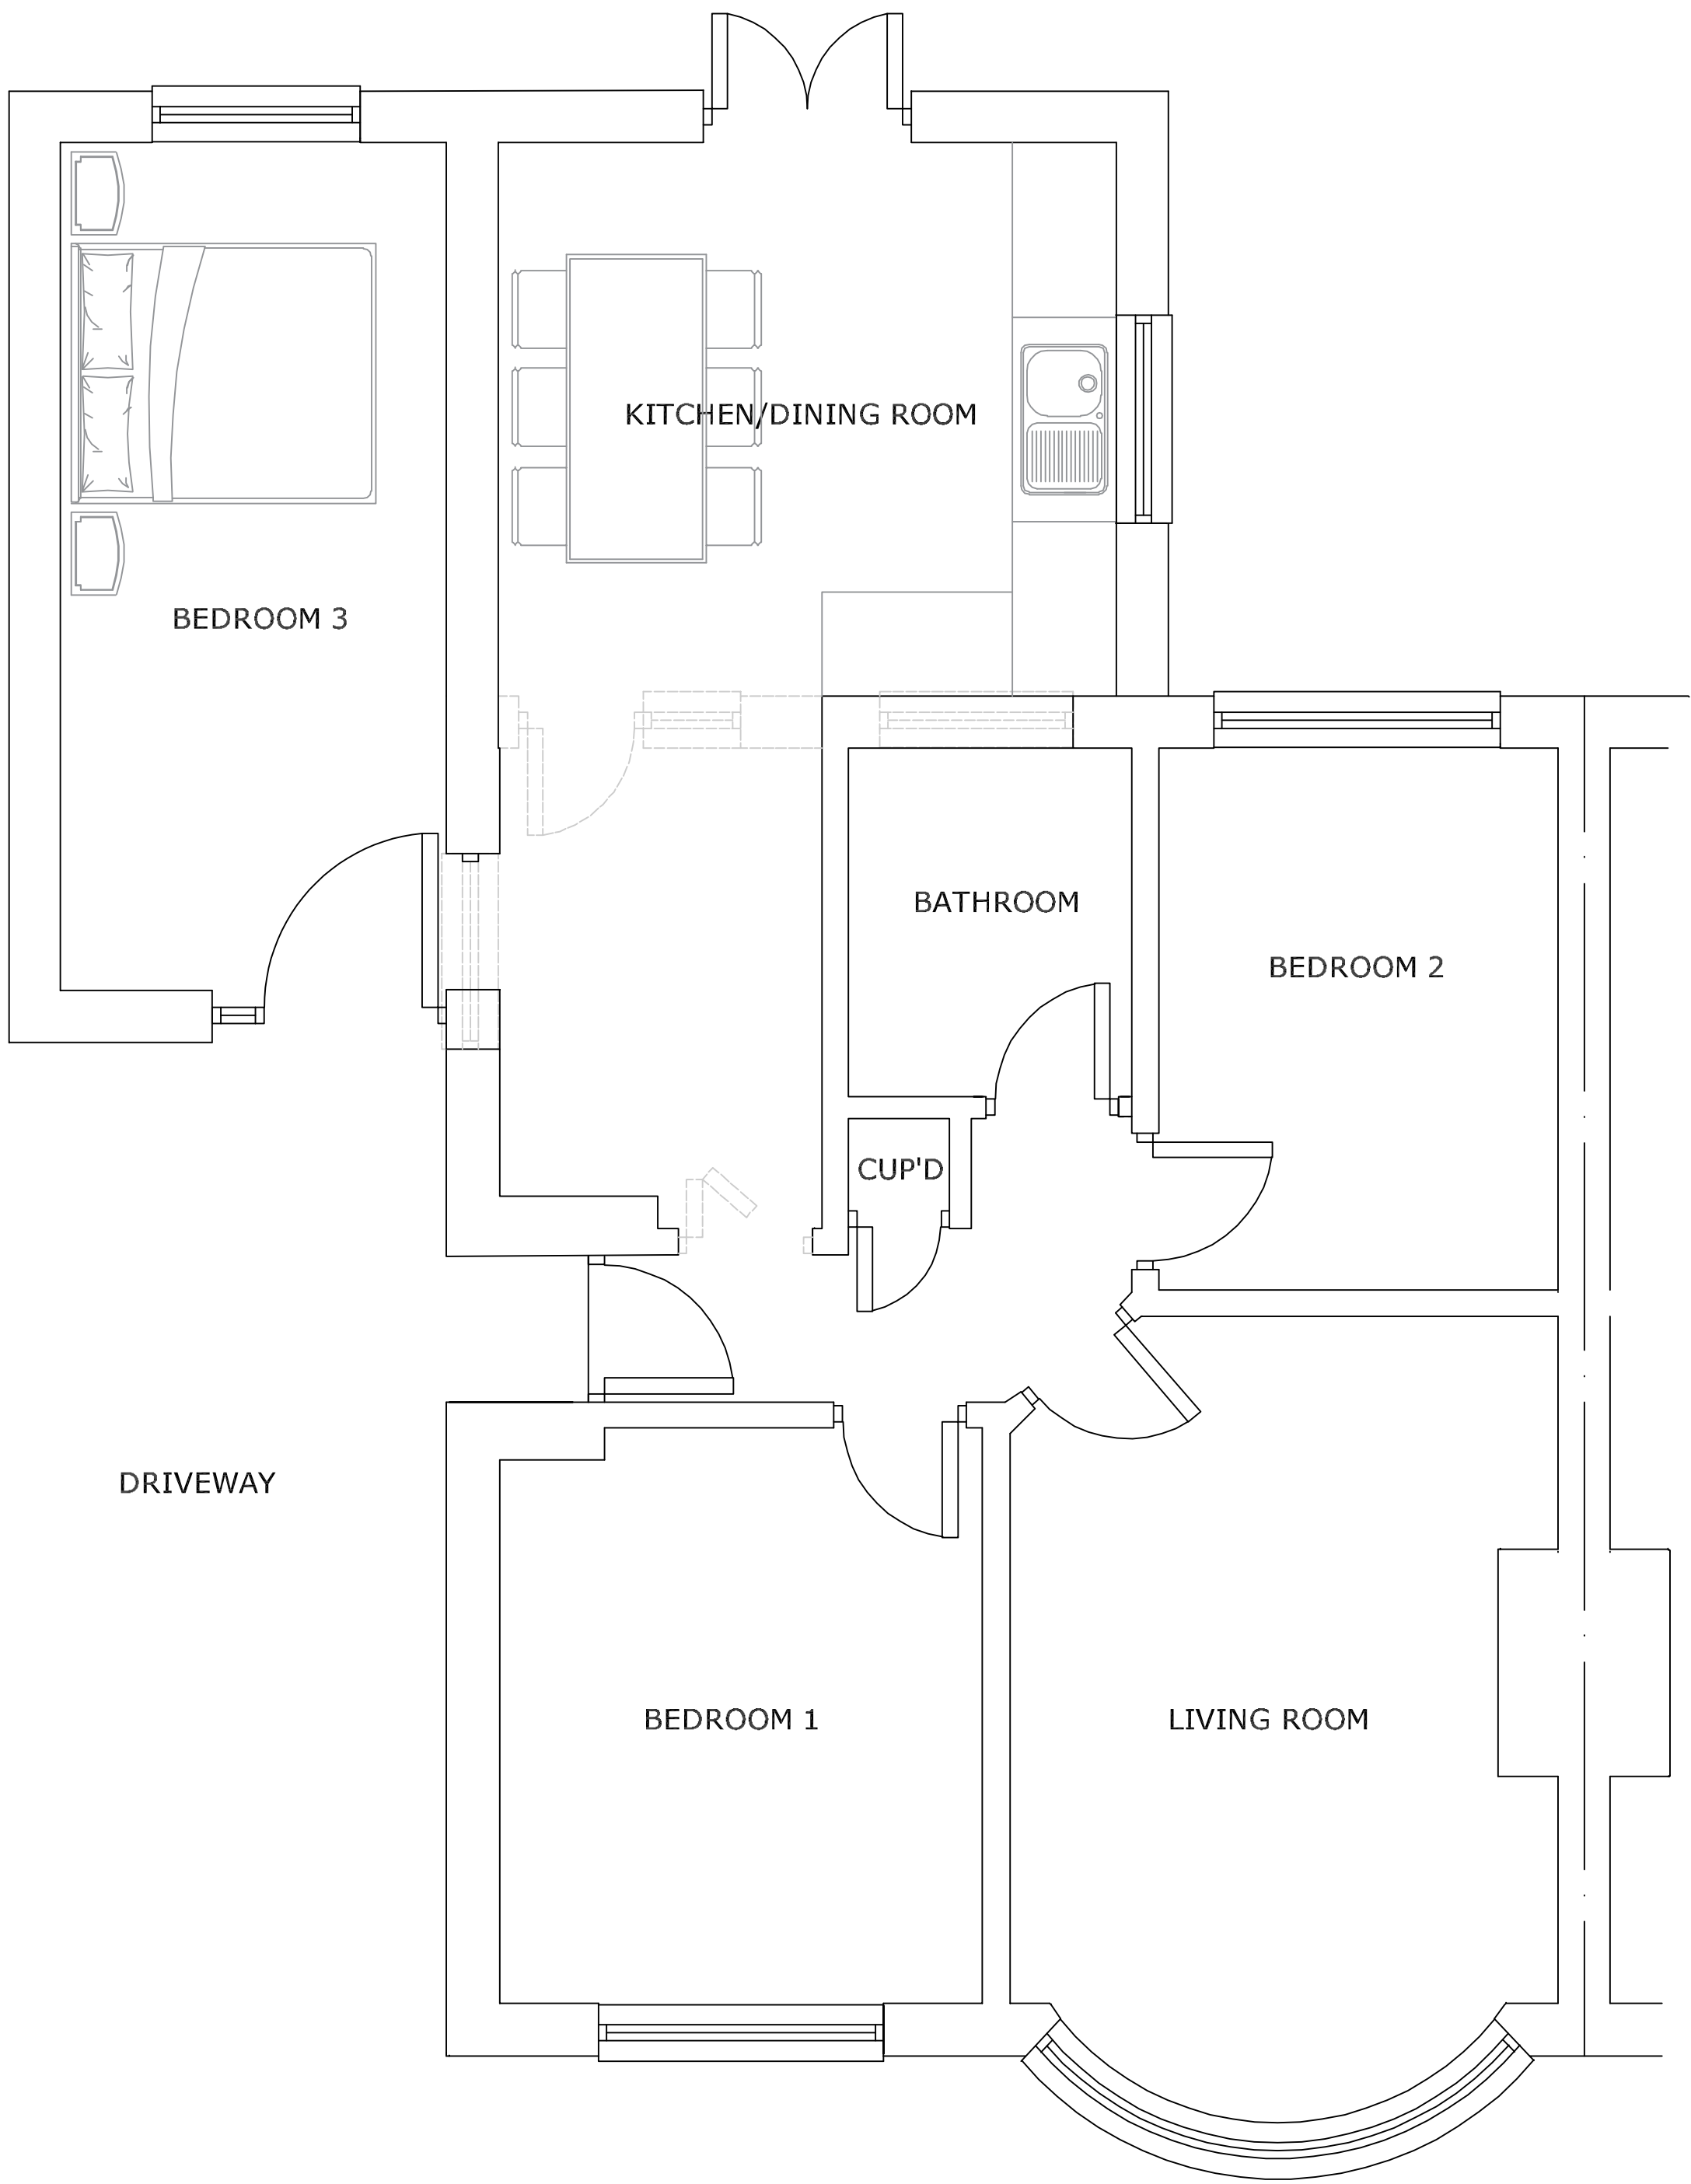

PROPOSED FLOOR PLAN

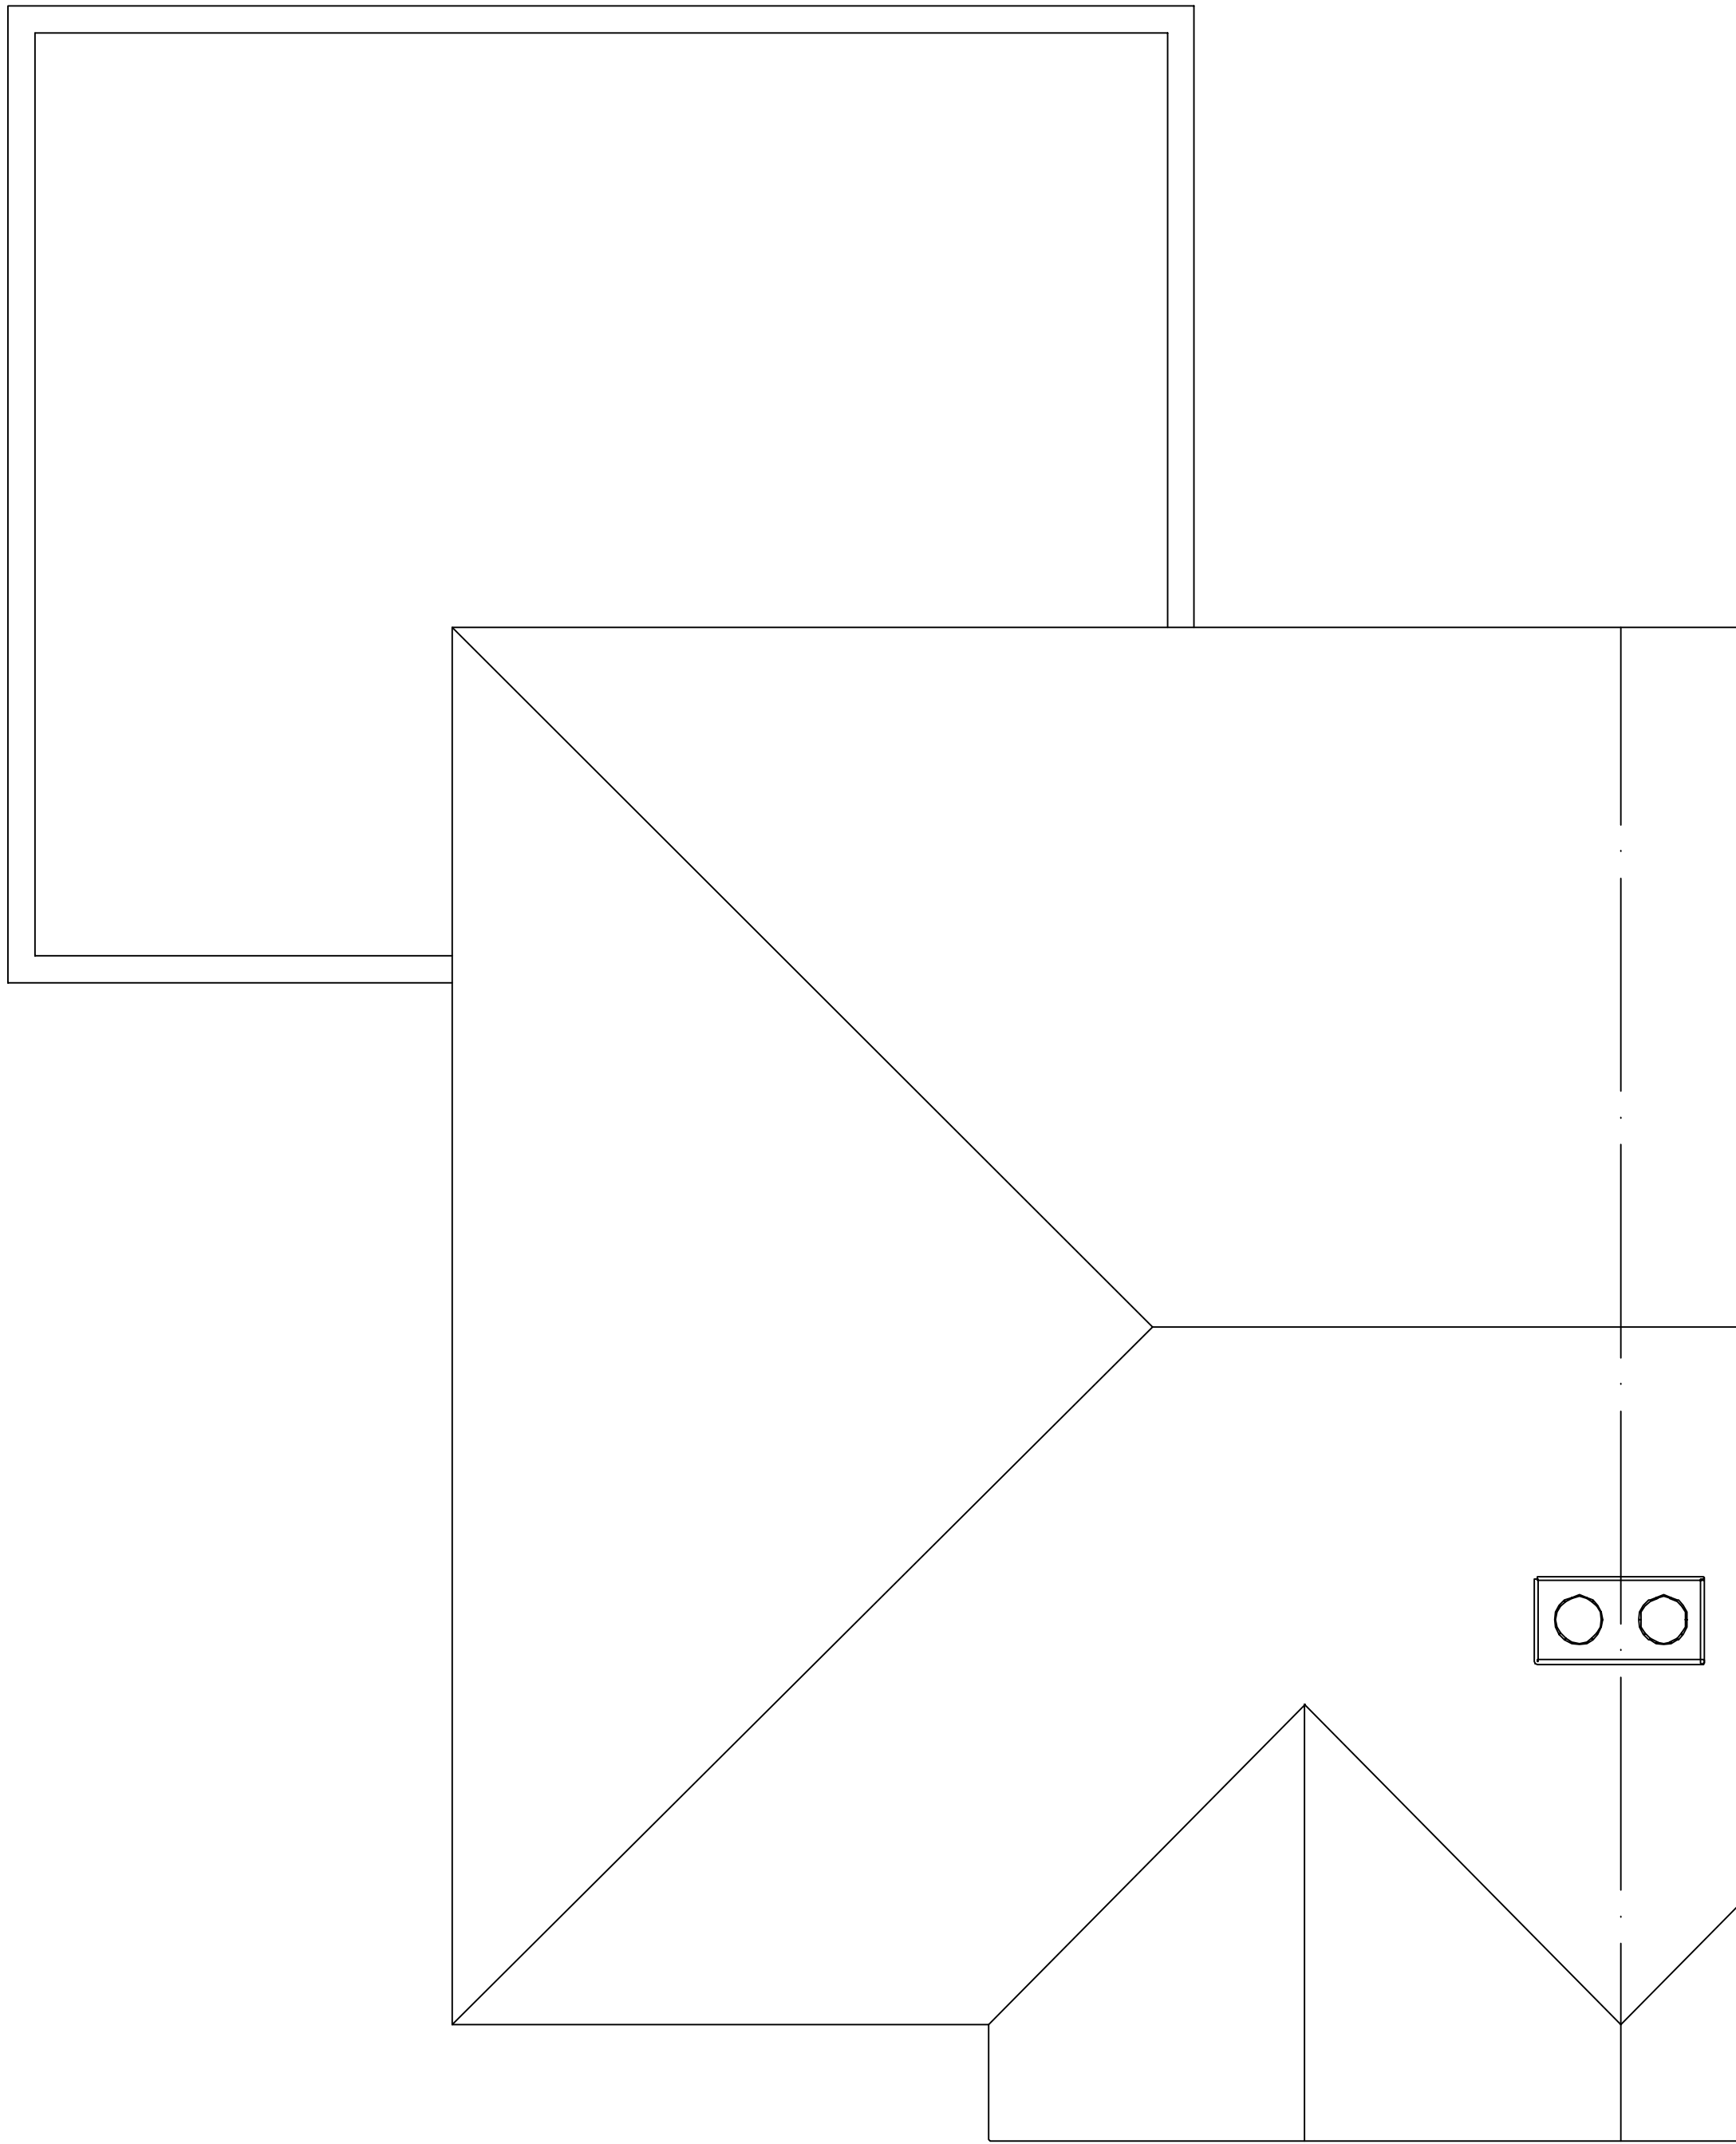

PROPOSED ROOF PLAN

B	06.07.26	As Built Update	AG							
A	16.03.20	Planning Submission	AG							
ISSUE	DATE	REMARKS	DR	CH	PE	MAINT	CE	PROD	MHG	
Mr Ryan Ellis 45 Mead Road, Southampton, So53 2FB Proposed Floor Plan & Roof Plan										
SCALE 1:100		DRAWING No. 103				ISSUE B				