


NOTES

1. The contents of this drawing are copyright of Watts Holt.
2. It may not be copied, reproduced or altered in anyway without the written authority.
3. Do not scale. Figured dimensions only to be used.
4. Check dimensions on site before work proceeds, report any discrepancies.
5. If in doubt please ask!

Reproduced from the Ordnance Survey map with the permission of The Controller of Her Majesty's Stationary Office
© Crown copyright reserved

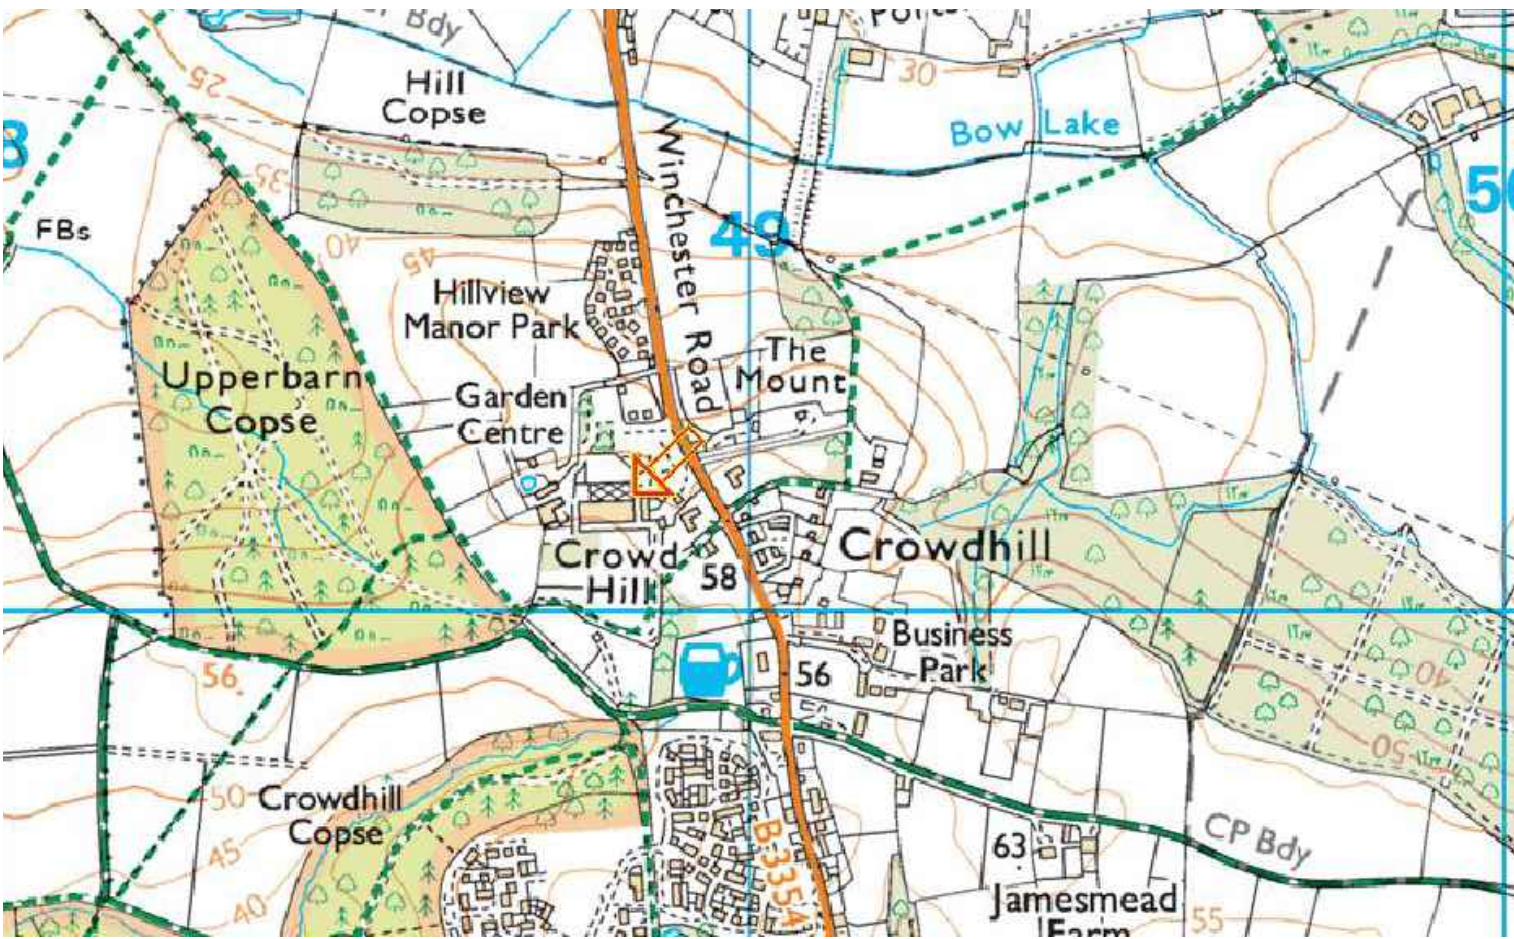

WATTS HOLT

THE YARD
LOCH ROAD, POOLE
DORSET, BH14 9EX
W: www.wattholt.com
T: 01202 461586
E: hello@wattholt.com


Scale 100mm @ A1			
A	lorry access updated - red line	18/06/26	VT
No.	Revision	Date	By

Project
In-Excess, Winchester Rd, Eastleigh

Client / Brand
In-Excess UK Ltd

Drawing Title
Location + Block Plan

scale @ A1 1:500/10 000	checked .
date Feb '26	drawn VT
19148 201A	A

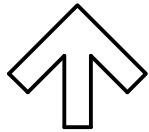

In-Excess UK Ltd
In-Excess, Winchester Rd, Eastleigh