


Disclaimer  
© This drawing is the copyright of Jeff Scoffham Architects Ltd and may not be reproduced or used except by written permission. This drawing may include information provided by third parties including civil and structural, M&E and other specialist consultants and subcontractors. Jeff Scoffham Architects Ltd relies on the specialist knowledge and expertise of these third parties and does not warrant the accuracy of this information and thus is to be treated as illustrative only.  
If you notice any discrepancies between drawings/information supplied by Jeff Scoffham Architects Ltd and drawings/information supplied by other consultants, specialist sub-contractors or discrepancies within Jeff Scoffham Architects Ltd's drawings/information, please notify Jeff Scoffham Architects Ltd immediately detailing the discrepancies which have been identified.  
Unless otherwise expressly agreed, Jeff Scoffham Architects Ltd design responsibility is limited to the design of the permanent works as finally constructed only in accordance with Jeff Scoffham Architects Ltd's design.  
Do not scale use given dimensions only.  
Read this drawing in conjunction with the specification.  
Check site dimensions prior to fabrication.  
Whether specifically stated or not, all work is to comply with:  
The Building Regulations  
The requirements of the NHBC/Zurich  
The clients general development brief.

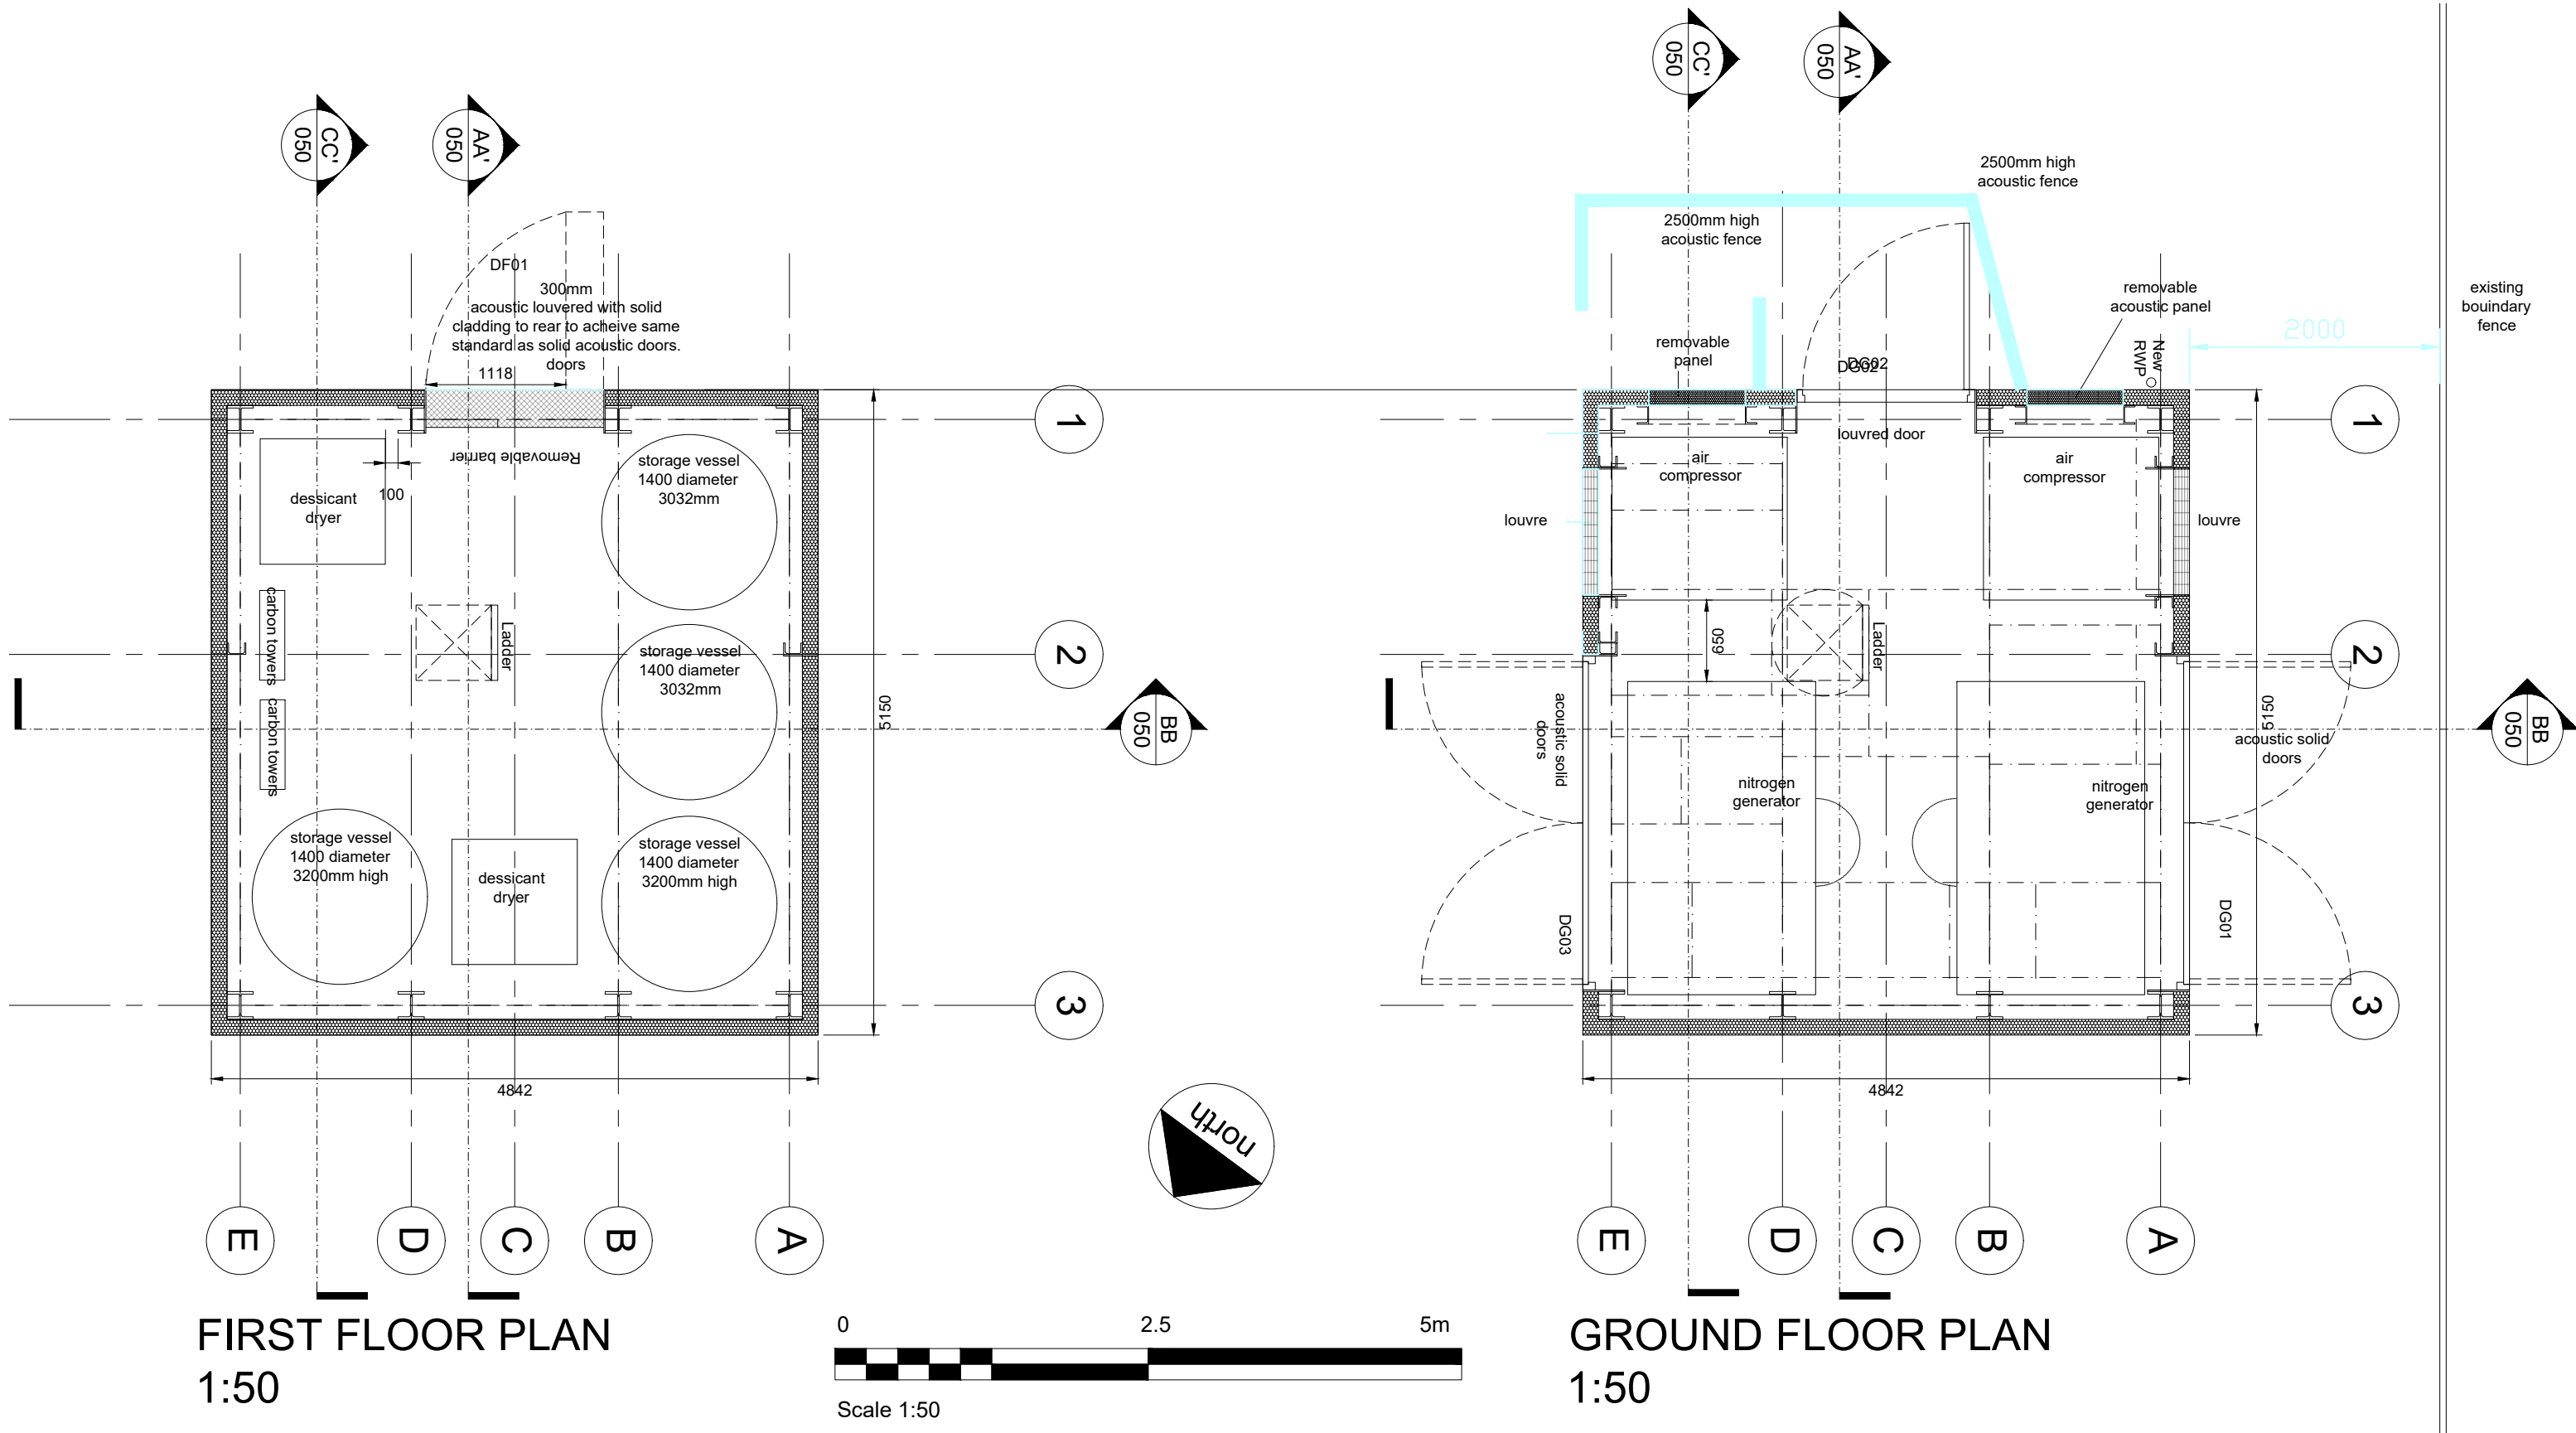

|     |     |                                                            |          |      |   |   |   |
|-----|-----|------------------------------------------------------------|----------|------|---|---|---|
| E   | JRS | AS BUILT FOR NEW PLANNING APPROVAL                         | 23 09 26 |      |   |   |   |
| D   | JRS | AS BUILT FOR NEW PLANNING APPLICATION                      | 18 06 26 |      |   |   |   |
| C   | JRS | draft FOR NEW PLANNING APPLICATION                         | 16 05    |      |   |   |   |
| g05 | JRS | ADJUST ACQUSTIC FENCE LAYOUT FOR PLANNING AND CONSTRUCTION | 18 05 26 |      |   |   |   |
| A   | JRS | UPDATRE LAYOUT FOR PLANNING AND CONSTRUCTION               | 12 05 26 |      |   |   |   |
| REV | BY  | CHK                                                        | DETAILS  | DATE | D | M | Y |

CLIENT

COOPER VISION  
Chandler's Ford,  
Eastleigh SO53  
4TF

PROJECT

NITROGEN GENERATION PLAN

2088 Cooper Vision  
Chandler's Ford,  
Eastleigh SO53 4TE



**J S Architects**  
also trading as Jeff Scoffham Architects Ltd  
50 Butt Lane Hincley LE10 1LD  
email: admin@js-architect.co.uk  
tel 01455 441961

DRAWING TITLE

**PLANNING DRAWING**

**PROPOSED GROUND & FIRST FLOOR  
PLANS,ELEVATIONS**

|                      |            |         |         |     |
|----------------------|------------|---------|---------|-----|
| DRAWING STATUS       | SCALE      | DATE    | DRAWN   | JRS |
| Preliminary          | 1:50 @ A1  | 05 2025 | CHECKED | SW  |
| For Approval         |            |         |         |     |
| Planning             |            |         |         |     |
| Building Regulations |            |         |         |     |
| Tender               |            |         |         |     |
| Construction         |            |         |         |     |
| Sketch               |            |         |         |     |
| As Built             |            |         |         |     |
| DRAWING NO.          | 2088 - 052 | REV     | E       |     |

