


This detailed site plan shows a large industrial or commercial facility. The plan includes numerous rooms and areas, each labeled with a number. Key features include:

- Rooms and Areas:** 001, 002, 003, 806, 8

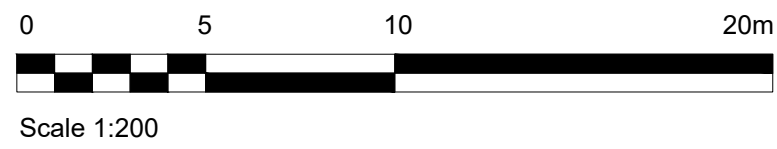

D	JRS	AS BUILT FOR PLANNING APPLICATION	18 05 26
C	JRS	ADJUST HEIGHT OF ACOUSTIC FENCE	18 05 26
B	JRS	ADD ACOUSTIC FENCE	12 05 26
A	JRS	ISSUE FOR CONSTRUCTION APPROVAL	15 05 25

REV	BY	CHK	DETAILS	DATE	D	M	Y
-----	----	-----	---------	------	---	---	---

CLIENT

COOPER VISION
Chandler's Ford,
Eastleigh SO53
4TE

PROJECT

NEW MEZANINE FLOOR AND STAIRCASE
2088 Cooper Vision
Chandler's Ford,
Eastleigh
SO53 4TE



also trading as Jeff Scoffham Architects Ltd
50 Butt Lane Hinckley LE10 1LD
email: admin@js-architect.co.uk
tel 01455 441961

DRAWING TITLE

BUILDING REGULATIONS DRAWING NITROGEN GENERATION PROPOSED SITE PLAN

DRAWING STATUS		SCALE	DATE	DRAWN	JRS
Preliminary	☒	1:200	@ A1	05 2025	
For Approval	☐			CHECKED	SW
Planning	☐				
Building Regulations	☐				
Tender	☐				
Construction	☐	DRAWING NO.		REV	
Sketch	☐		2088 - 51	D	
As Built	☐				