



PLEASE NOTE:-
Figured dimensions to take preference to scaled dimensions. The contractor is responsible for checking all figured dimensions against actual dimensions on site prior to starting any work. Any discrepancies are to be reported prior to work being carried out.

COPYRIGHT
This drawing is the Copyright of the Architect Jon Tyrrell and must not be reproduced without the Architects permission.


CONSTRUCTION STANDARDS
All work shown on this drawing must be carried out to conform with the relevant British Standards of Codes of Practice or any National or International standards applicable, then the higher standard shall apply.

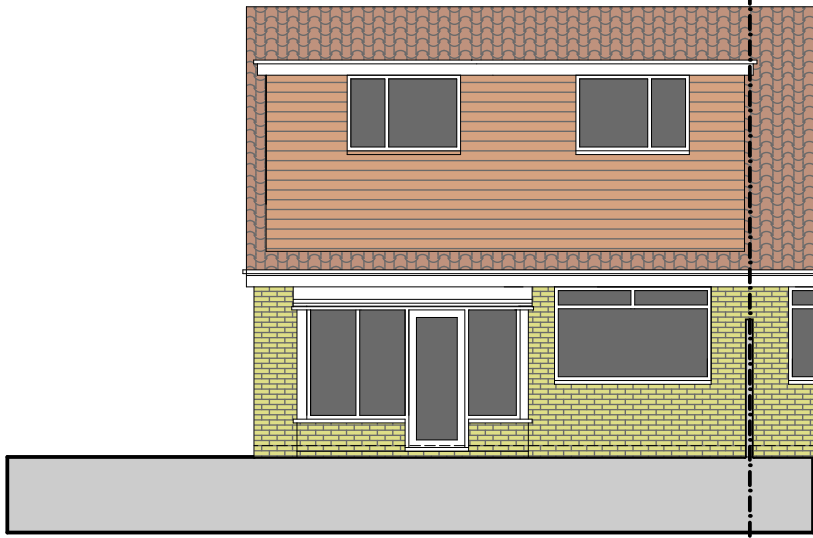


**Existing Rear Elevation
1:100**

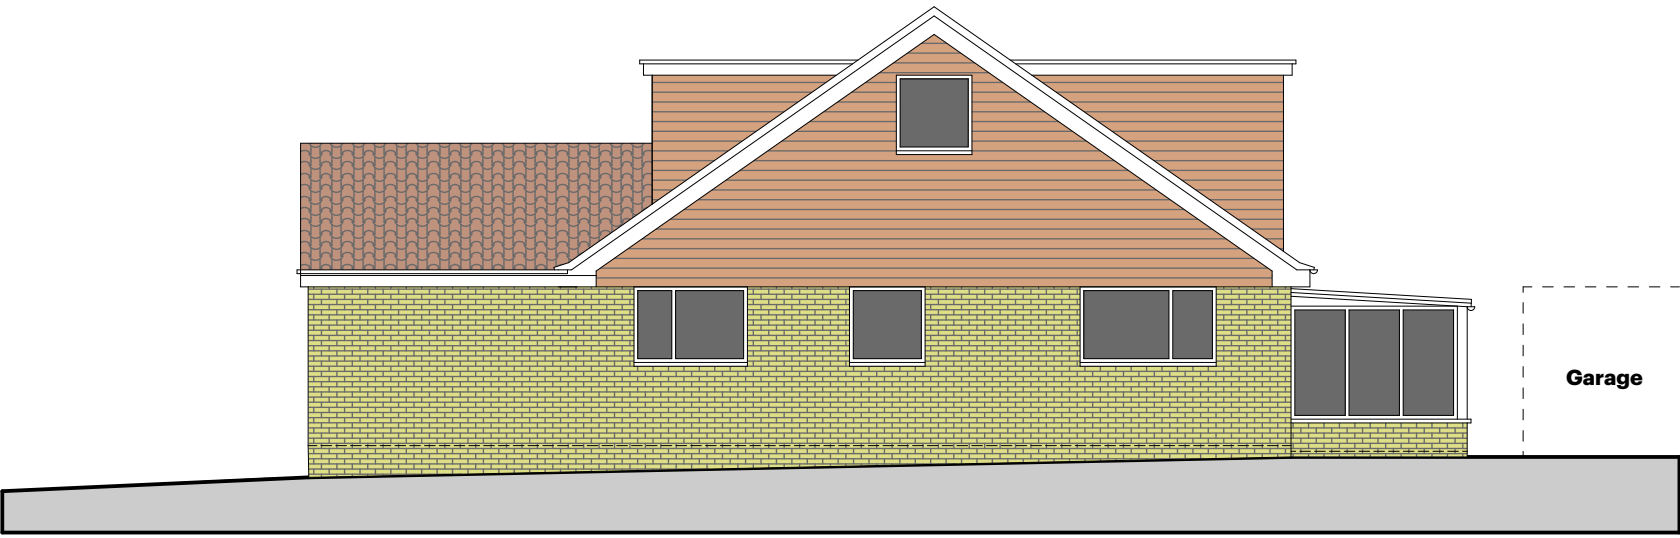

**Existing Side Elevation
1:100**

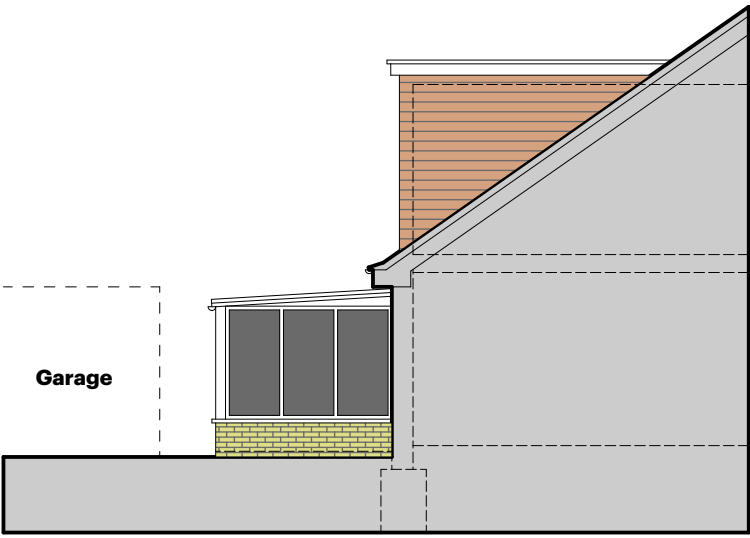


**Existing Section & Side
Elevation 1:100**

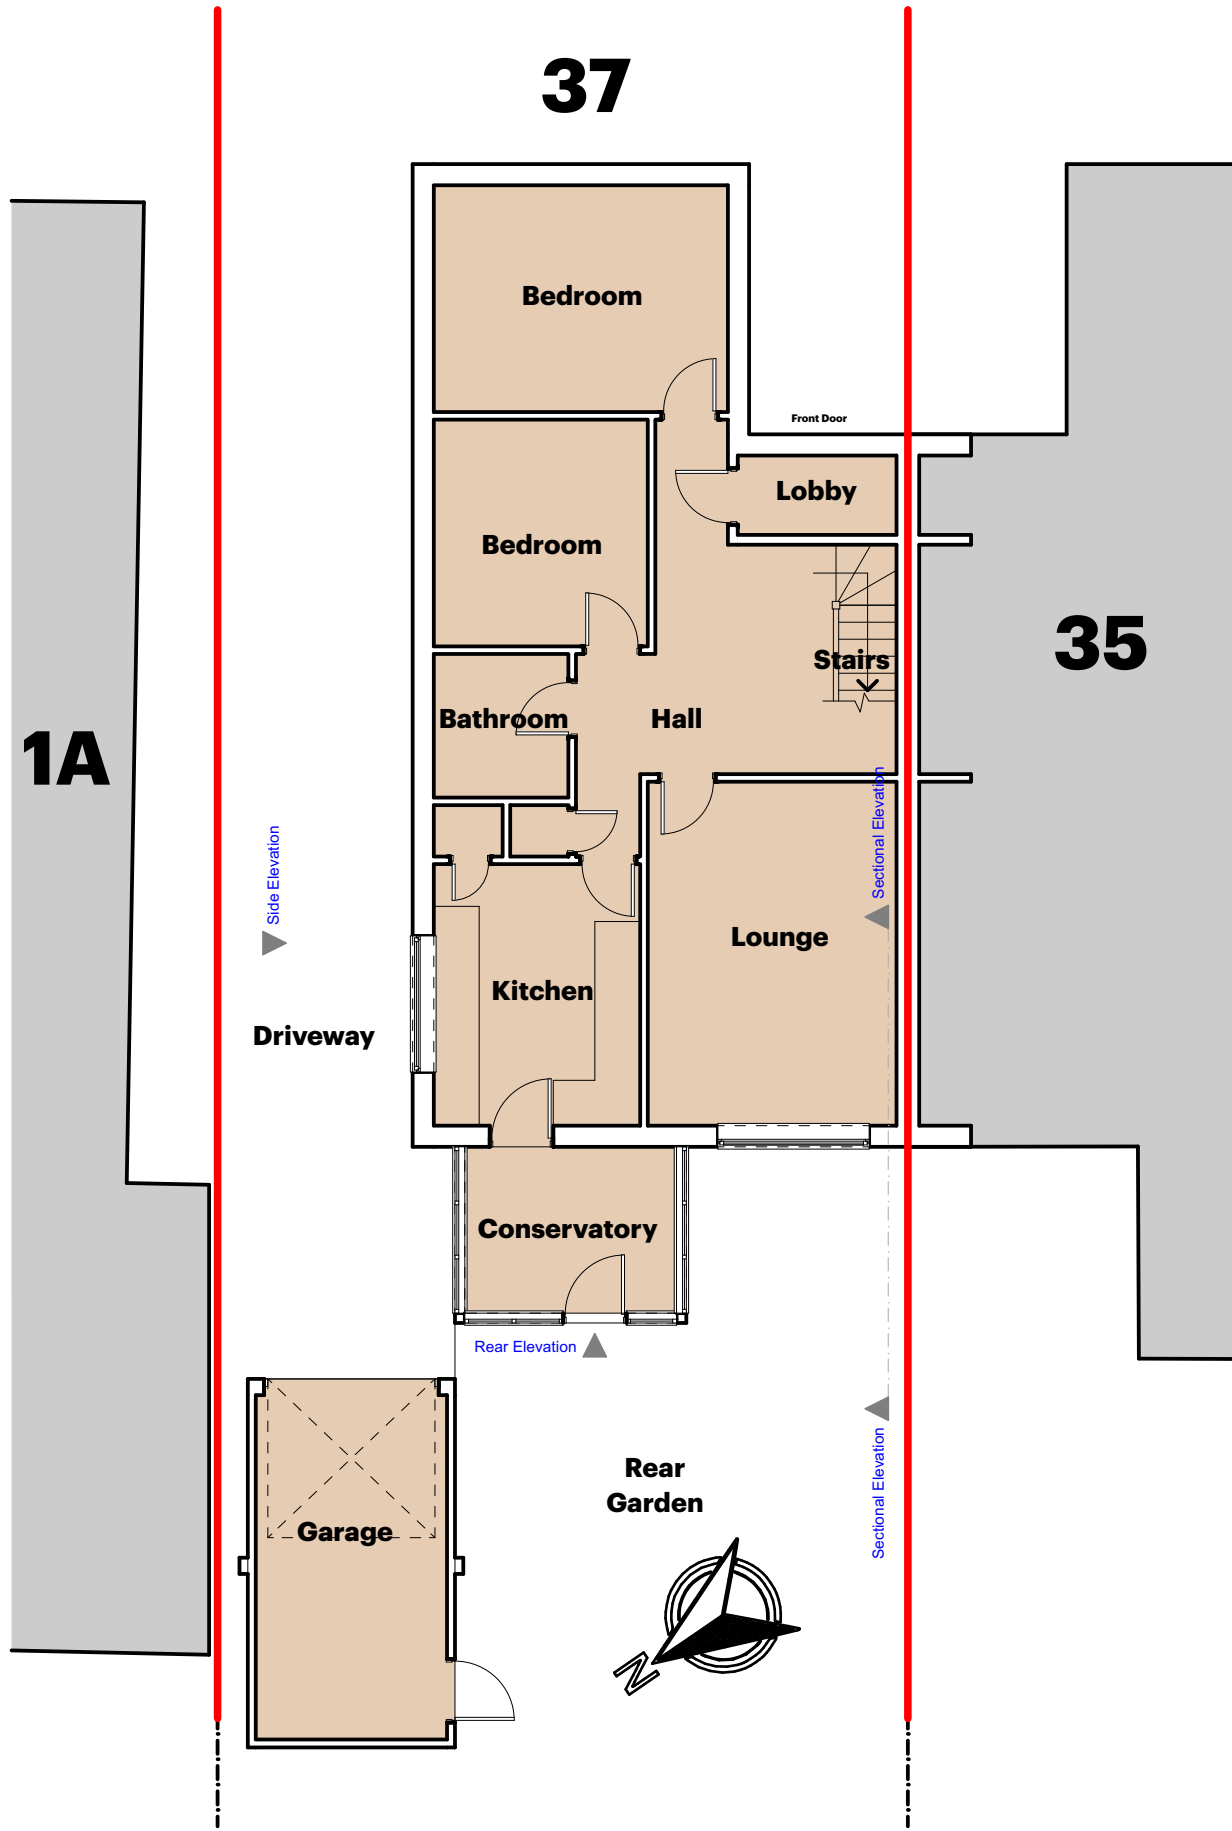

Ground Floor Plan as Existing 1:50



Block Plan 1:500

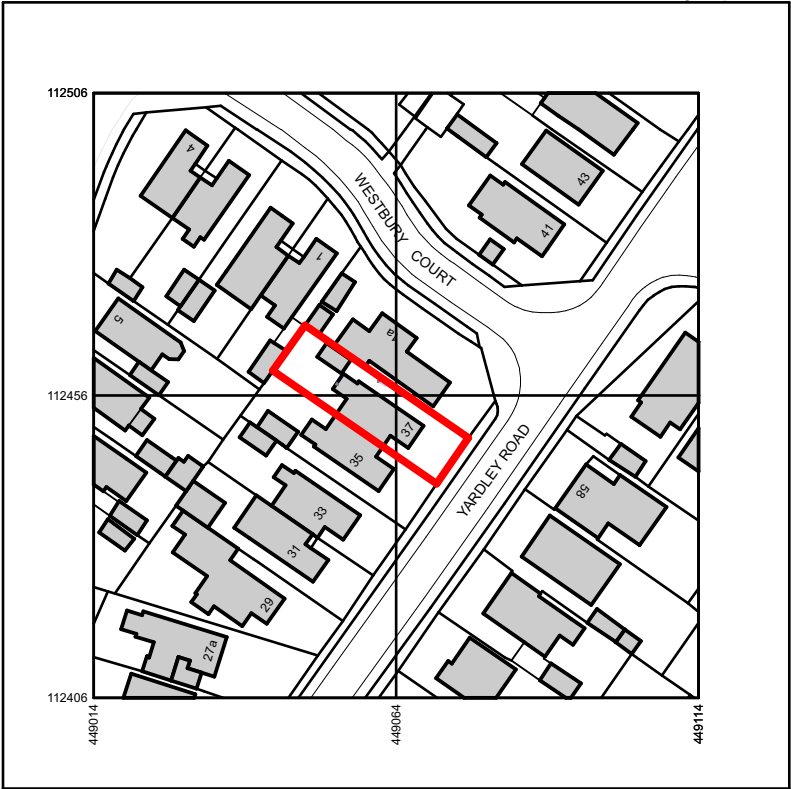

Produced on 05 February 2024 from the Ordnance Survey National Geographic Database and incorporating surveyed revision available at this date.
This map shows the area bounded by 449014 112406, 449114 112406, 449114 112506, 449014 112506, 449014 112406
Crown copyright and database rights 2024 OS 100054135. Supplied by copla ltd trading as UKPlanningMaps.com a licensed Ordnance Survey partner (OS 100)
Data licence expires 05 February 2025. Unique plan reference: v1e110548021420639



Location Plan 1:1250



**Architect
& Artist**

**Jon Tyrrell
Studio**

1a Admiralty Cottages Fort Road Gosport Hampshire
PO12 2AP
Tel: 07501 831831 Email: jon@jontyrrellstudio.co.uk
Website: www.jontyrrellstudio.co.uk

Project Details	
Proposed rear extension at 37 Yardley Road Hedge End Southampton SO30 OHP	
Drawing Description	
Survey as Existing	
Drawing Type	
Record Drawing	
Prepared by	Date
JMT	Feb 2024
Drawing Scale	
As Shown @ A2 size	
Drawing Number	
JTS-149- S01	
Jon Tyrrell Studio Ltd Company Reg Number 14099191	