


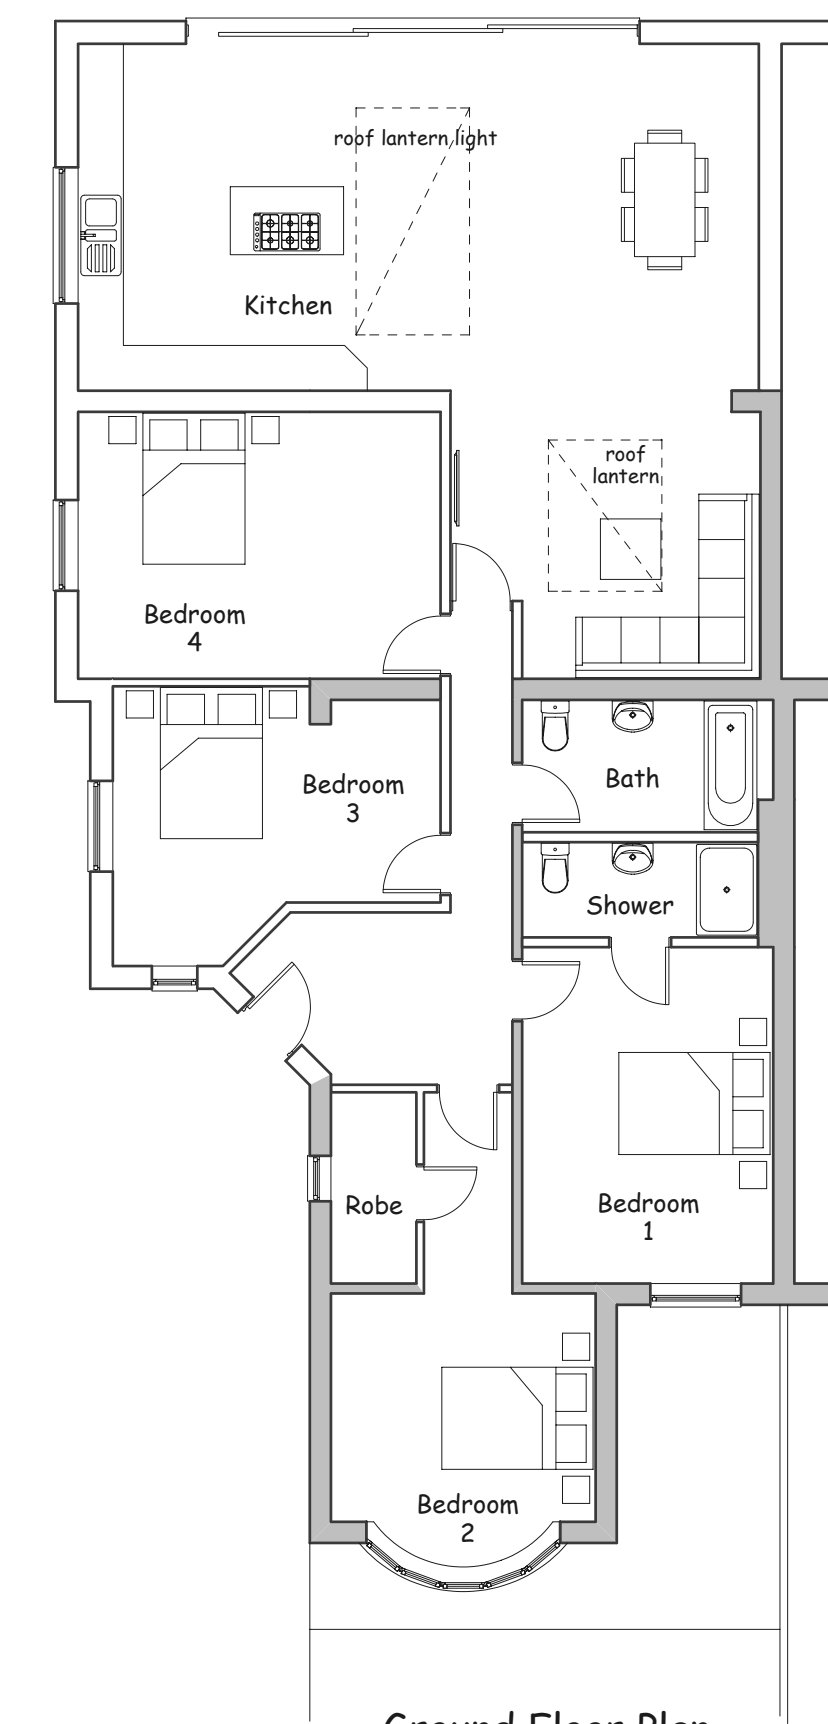


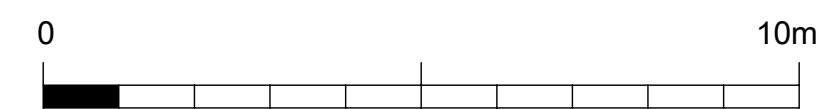

Ground Floor Plan

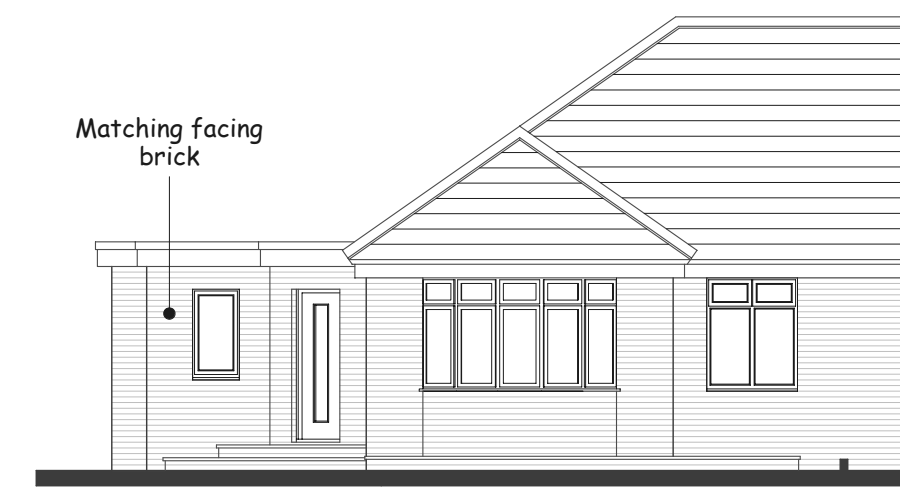


West Elevation

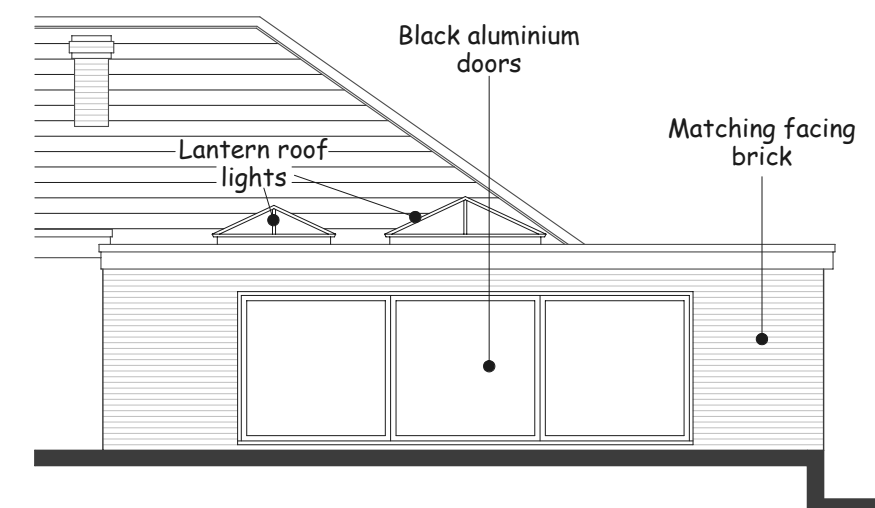


East Elevation





North Elevation

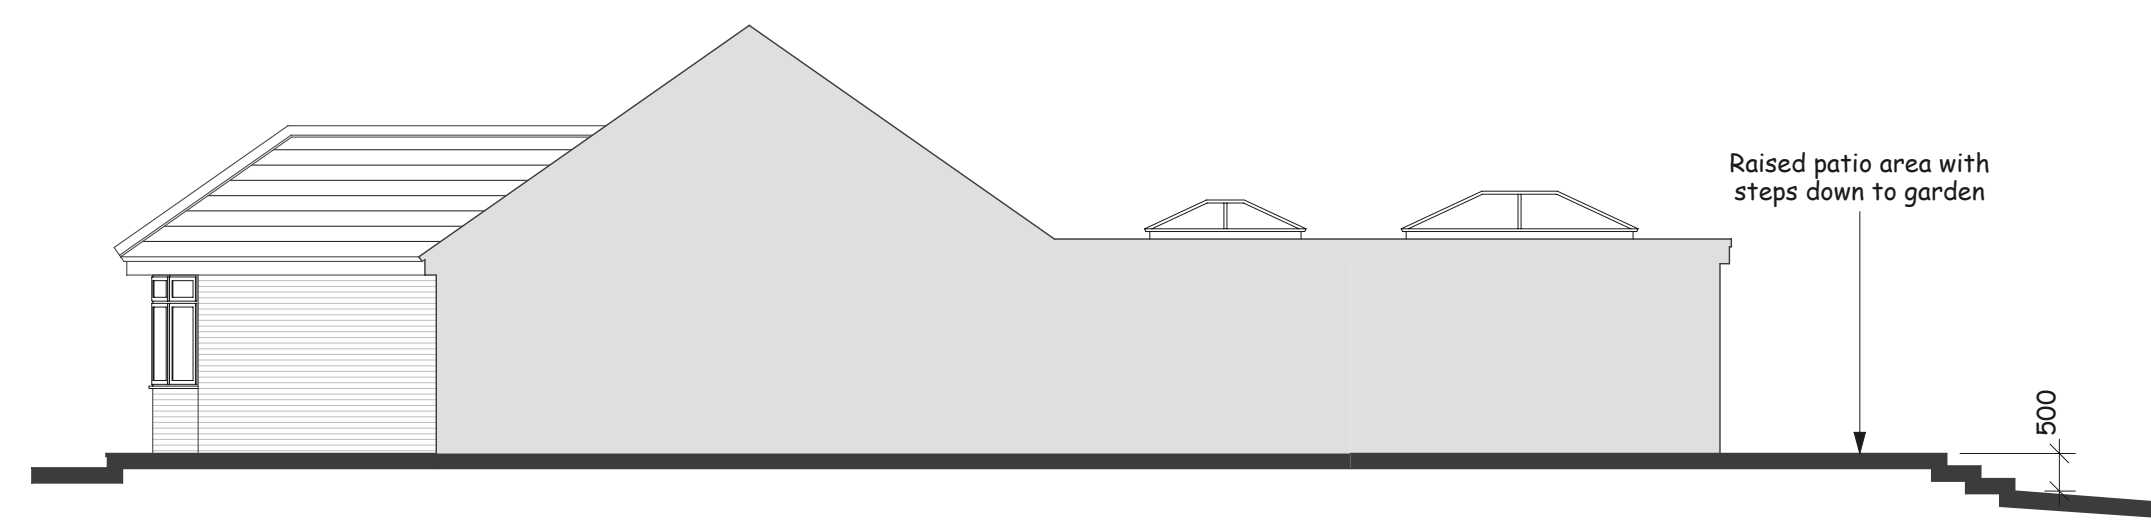


South Elevation

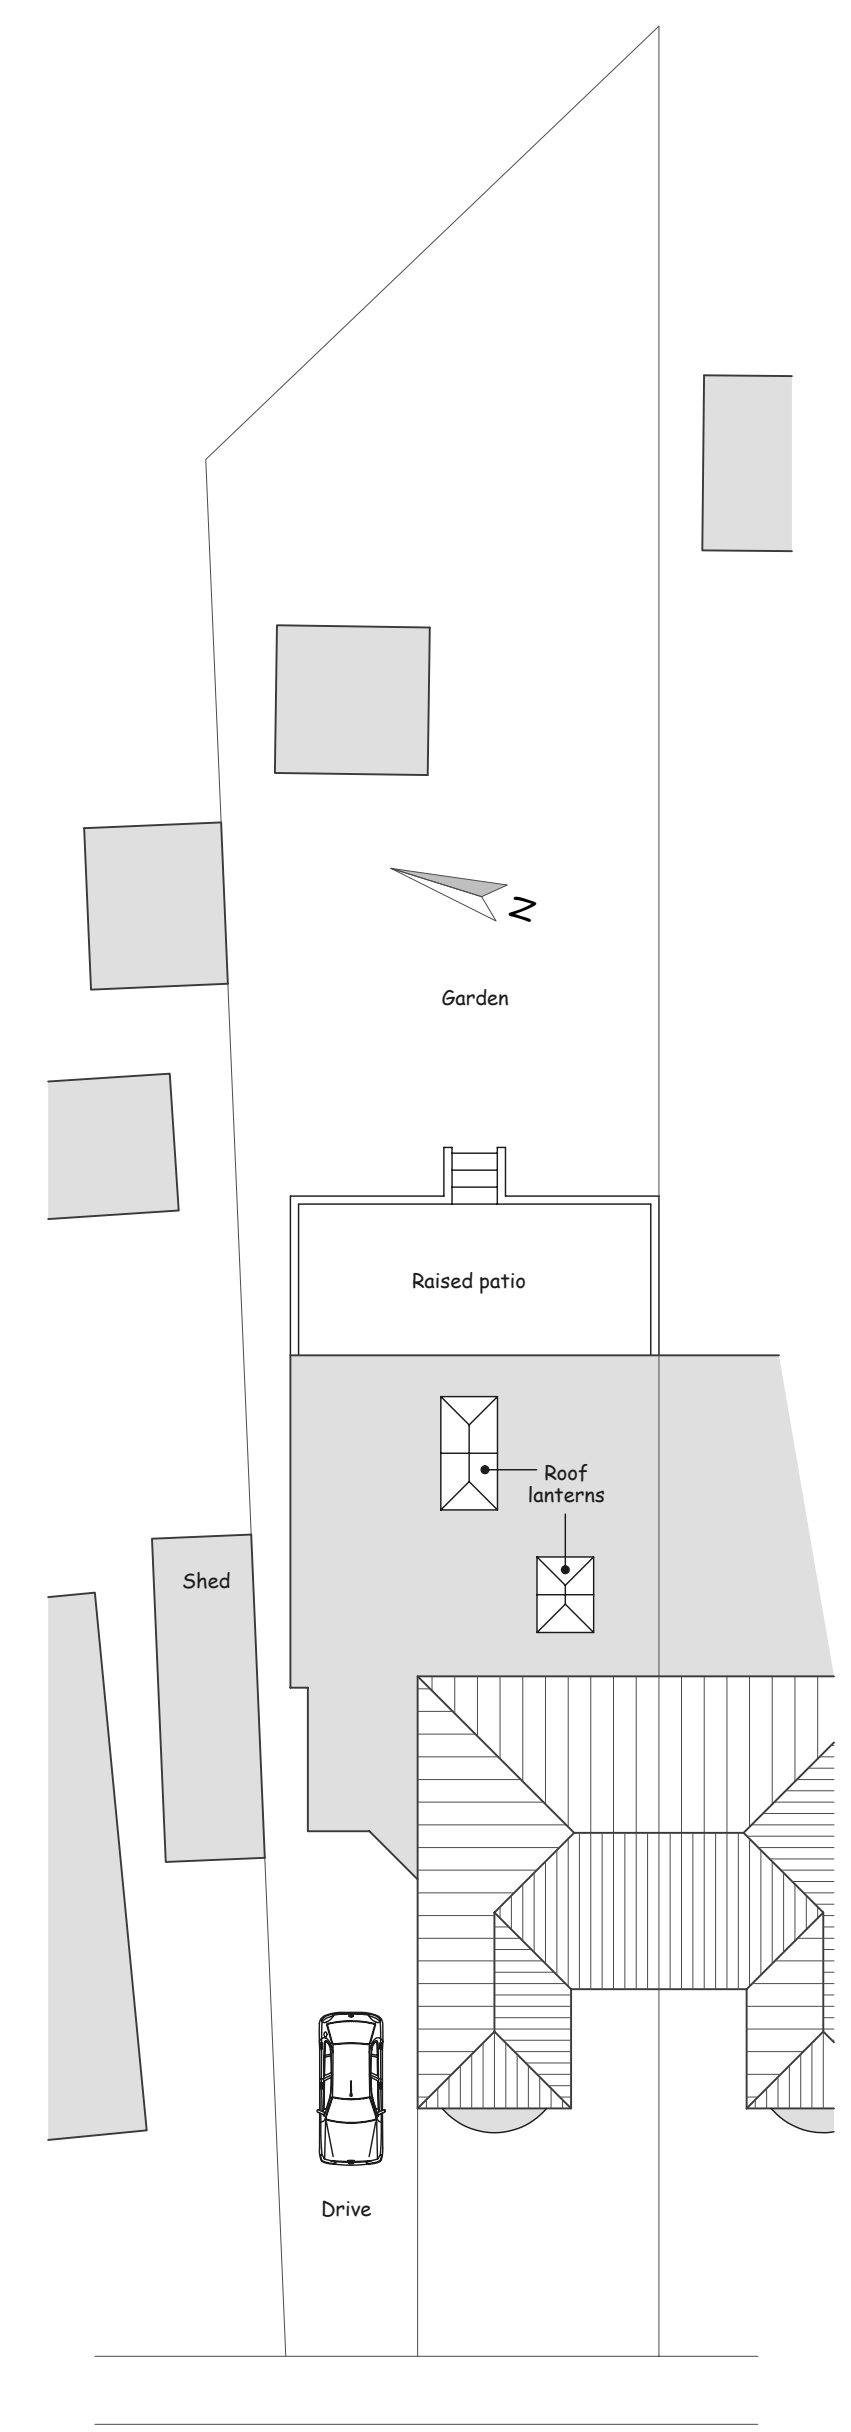

Site Plan Proposed
Scale 1:200

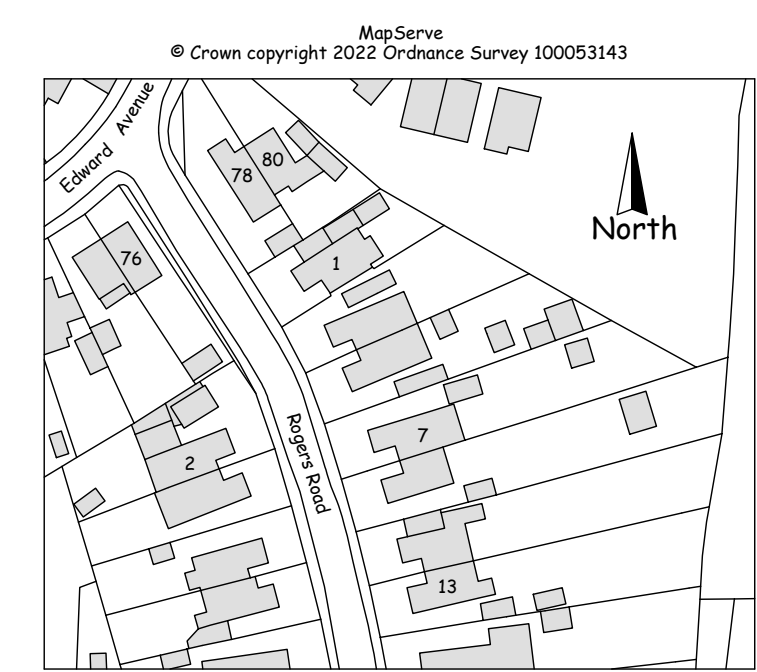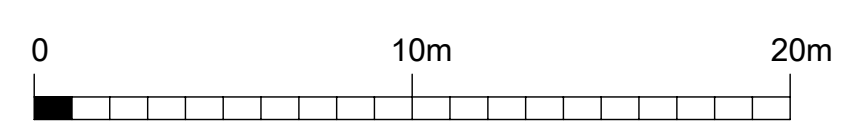

Location Plan Scale 1:1250

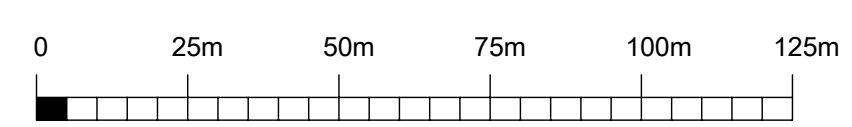

D Peter Oughtibridge
DPODESIGN.CO.UK
p.oughtibridge@btinternet.com
07748801306

Proposed side and rear extensions
& demolition of existing garage at:-
7 Rogers Road, Bishopstoke, Eastleigh,
Hampshire SO50 6DZ.
for - Mr & Mrs D Page.

Drawing:
As Built.
Scale:
1:100, 1:200, 1:1250 @ A2.
Date:
April 2024.
Drawing Number:
7RW - AB - 02.