


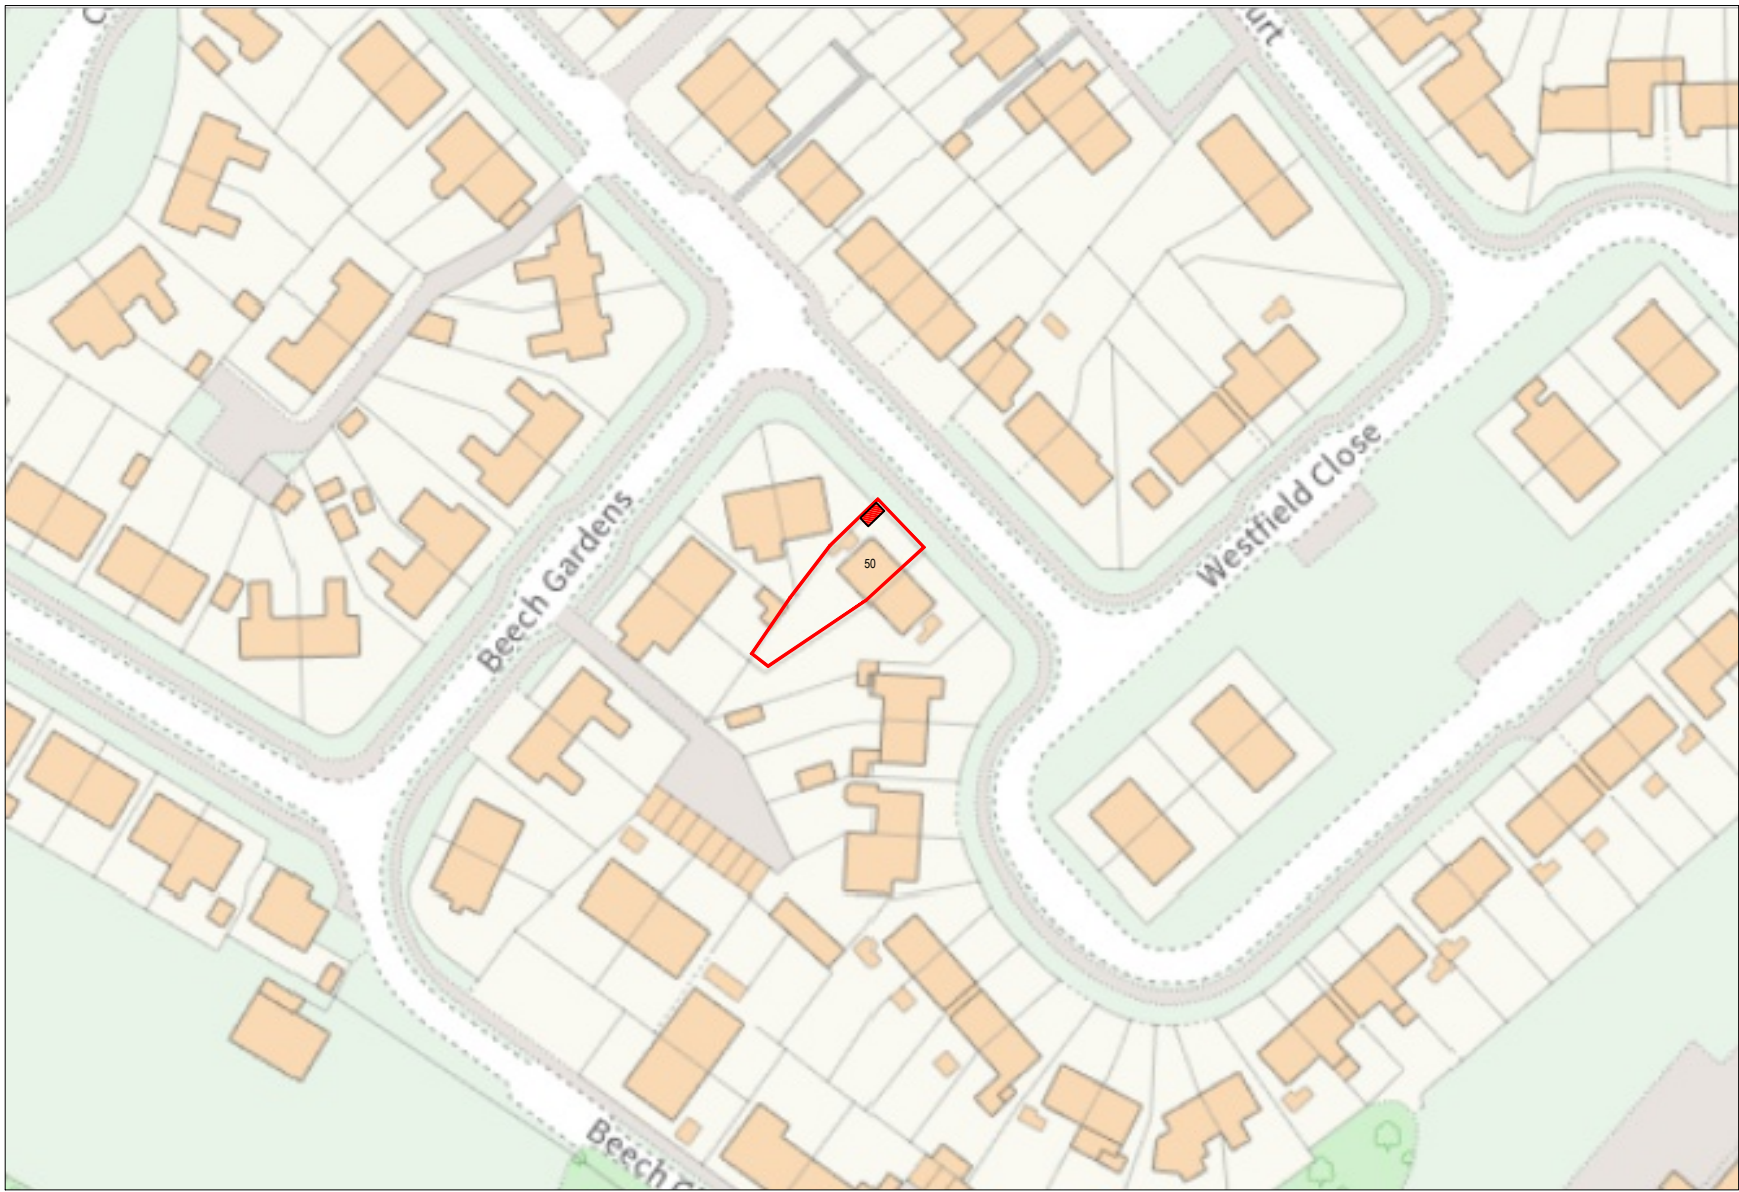

Project Title:			50 WESTFIELD CLOSE, S031 4LG		
Drawing Title:			LOCATION PLAN		
Status:		Scale:			
AS-BUILT		1:1250 @ A3			
Drawn by:	Checked by:	Date:			
CW	AD	07-01-2025			