



PLANNING

AS-BUILD / PROPOSED DRAWINGS


ELEVATIONS

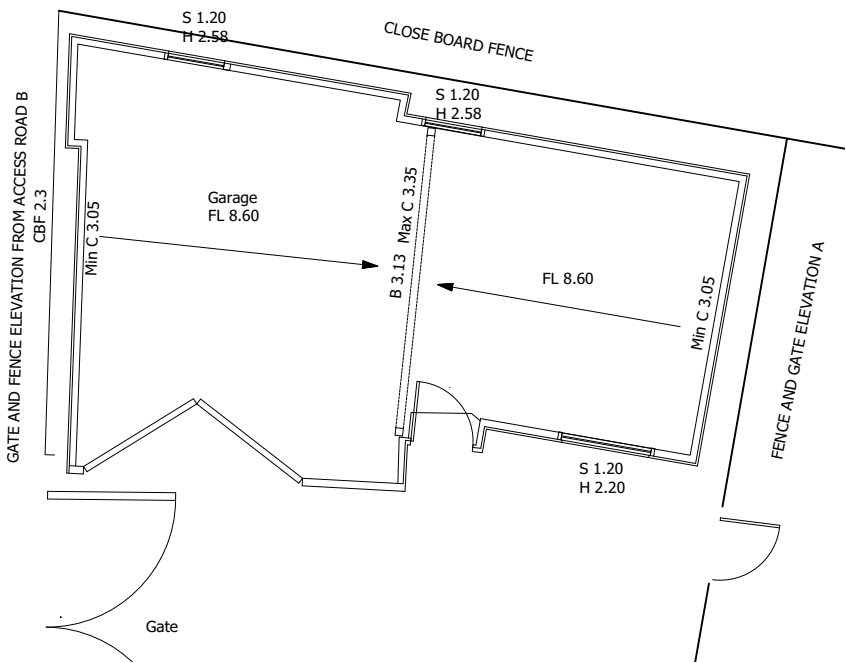


1 AS-BUILT / PROPOSED PLAN
Scale: 1:100

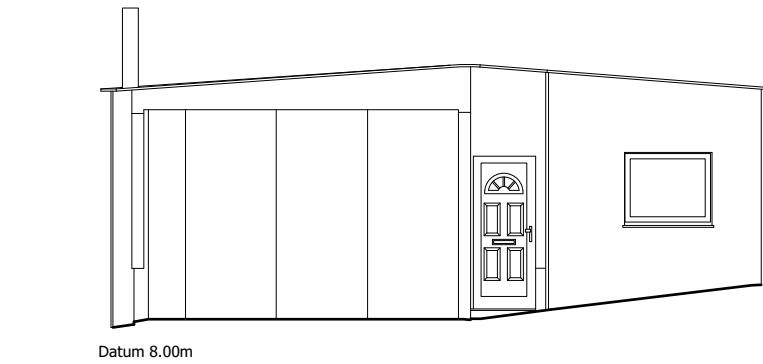


NORTH ELEVATION 1

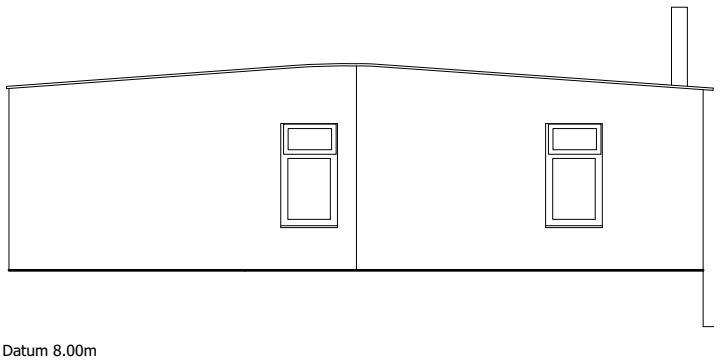


SOUTH ELEVATION 3

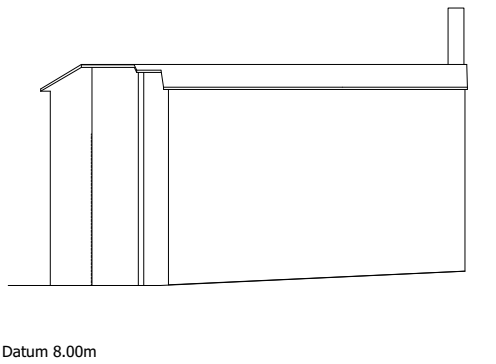

WEST ELEVATION 2

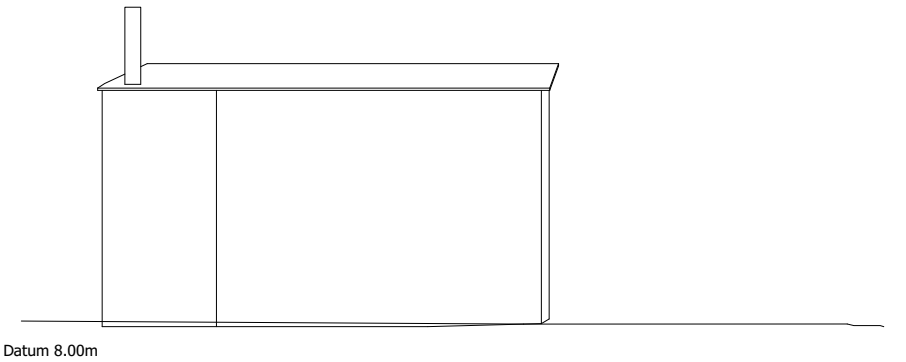

ELEVATION 4

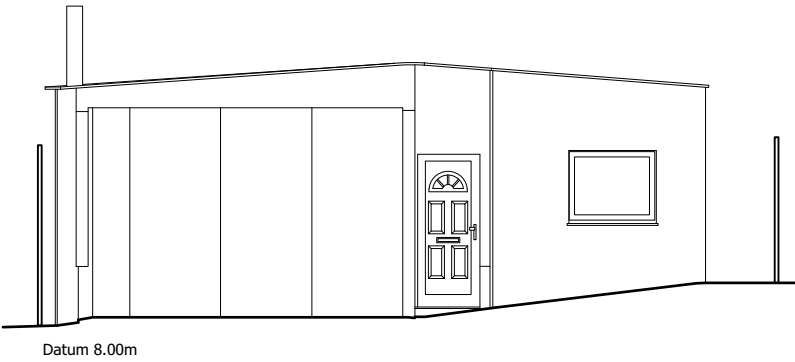

SITE SECTION


2 AS-BUILT / PROPOSED ELEVATIONS
Scale: 1:100



3 AS-BUILT / PROPOSED SITE PHOTOGRAPHS

4 AS-BUILT / PROPOSED SECTION
Scale: 1:100

SCALE BAR
1:100 @ A3

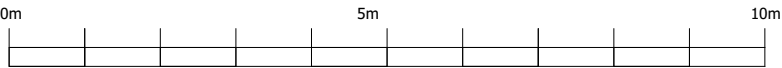

PROJECT
No. 6 Linnet Square

DRAWING TILE
AS-BUILT/PROPOSED
SHED ELEVATIONS

DRAWING NUMBER
P2501-104

SCALE
1:100 @ A3

REVISION
REV B

NOTES

Do not scale from this drawing for construction purposes.

All dimensions must be checked by the contractor before commencing work on site.

Unless otherwise noted, boundaries have not been surveyed. The recipient of this drawing should satisfy themselves of their precise location before commencing work on site. Drawing for Planning Purposes.