
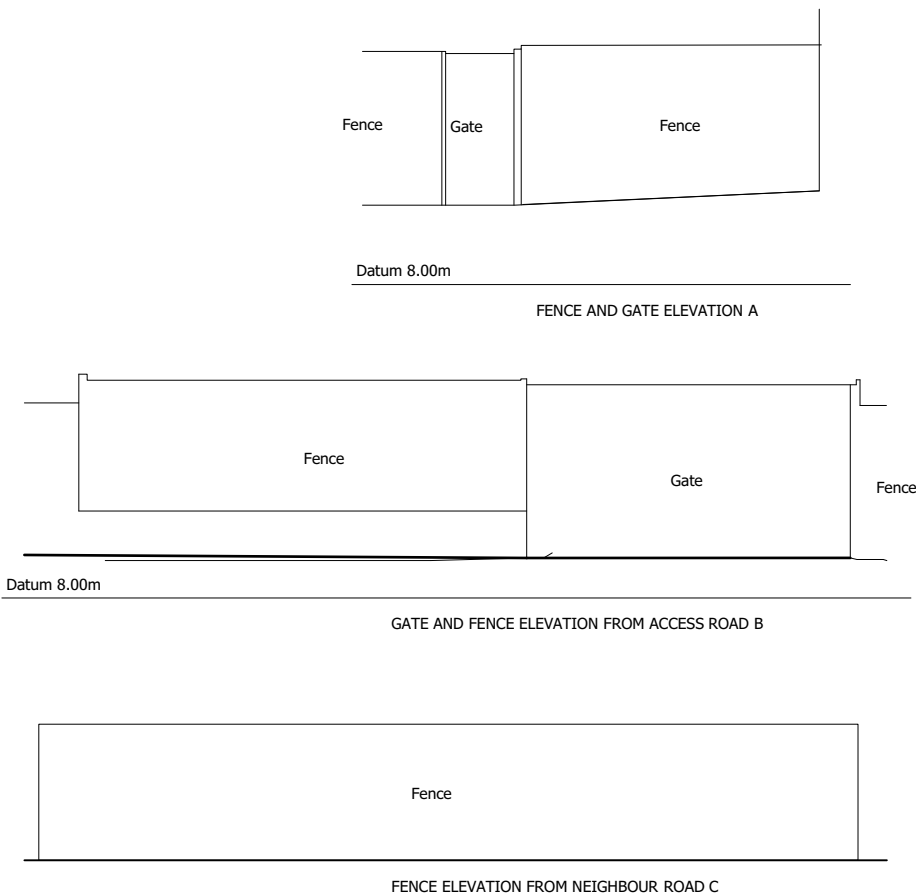


PLANNING

AS-BUILD / PROPOSED DRAWINGS

ELEVATIONS

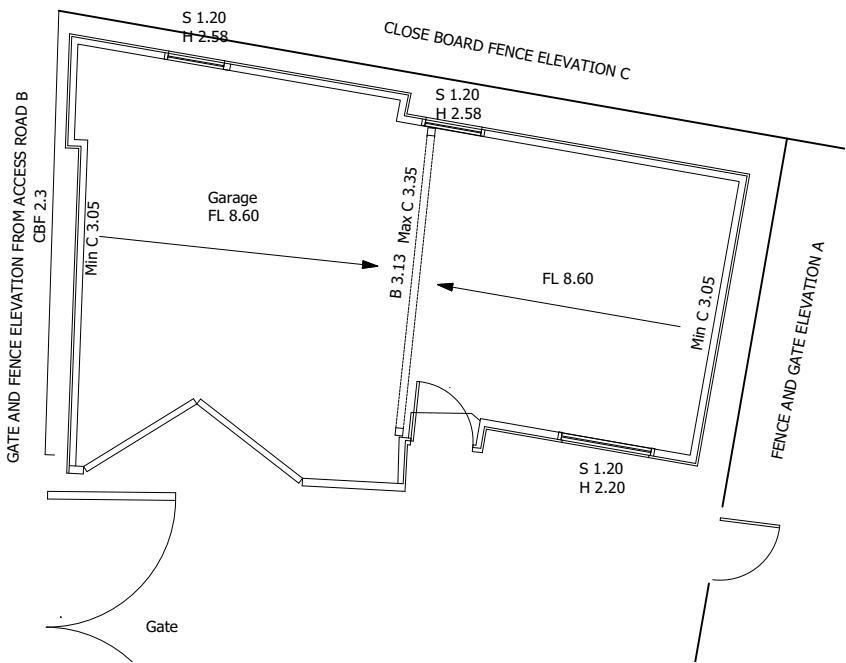


3 AS-BUILT / PROPOSED SITE PHOTOGRPAH
Scale: 1:100



3 AS-BUILT / PROPOSED SITE PHOTOGRAPHS

SCALE BAR
1:100 @ A3

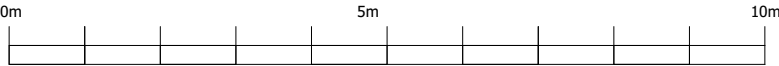

PROJECT
No. 6 Linnet Square

SCALE
1:100 @ A3

NOTES

Do not scale from this drawing for construction purposes.

All dimensions must be checked by the contractor before commencing work on site.

Unless otherwise noted, boundaries have not been surveyed. The recipient of this drawing should satisfy themselves of their precise location before commencing work on site. Drawing for Planning Purposes.

DRAWING TILE
AS-BUILT/PROPOSED
FENCE GATE ELEVATIONS

REVISION
REV

DRAWING NUMBER
P2501-106