




LINEAR SCALE 1:100
A4 @ 1:100


Boundary Wall Details

This drawing is the copyright of ADP Architects Ltd. It may not be altered or reproduced in any form, or passed onto Third Parties without the written consent of ADP Architects Ltd.


Note:
Leaning brick boundary wall has been carefully removed & rebuilt in accordance with planning permission H/22/93352 & listed consent L/22/93401

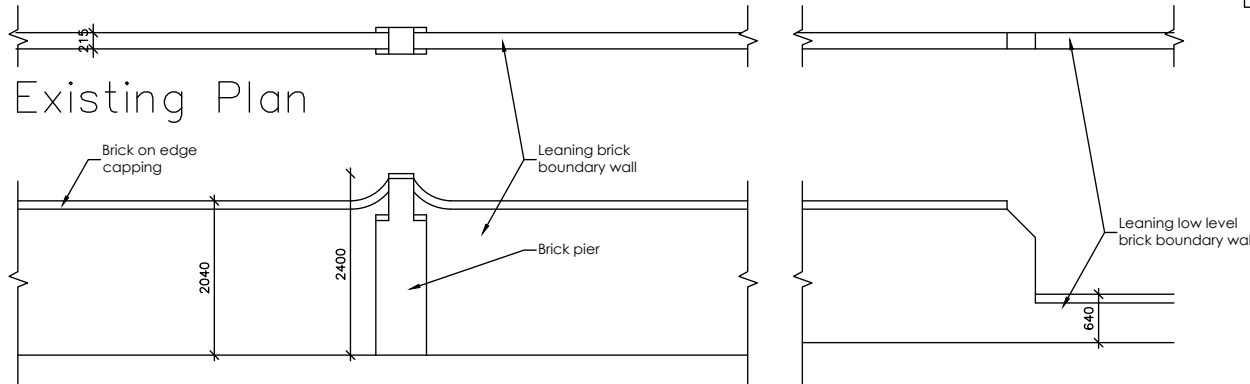

Existing Elevation & Section – Boundary Wall

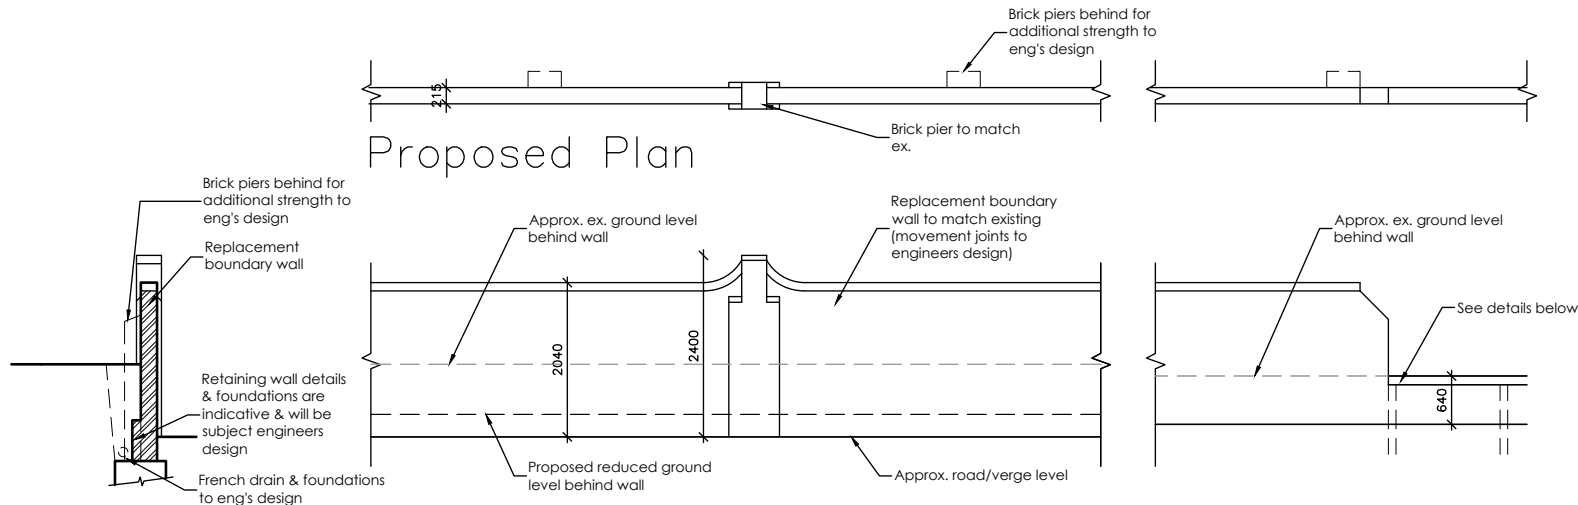

Proposed Elevation & Section – Boundary Wall

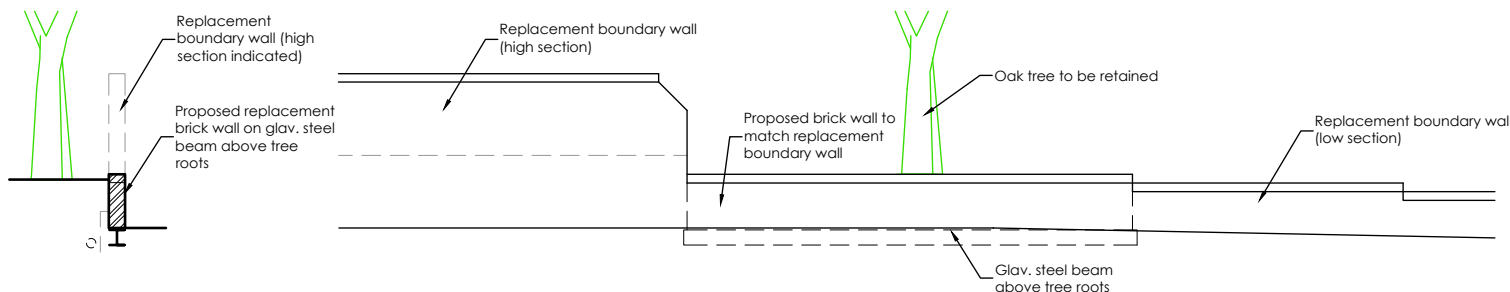

Proposed Elevation & Section – Retaining Wall Fronting Oak

B 12.02.25 Tree wall section updated (as built)

A 4.03.24 Planning issue

rev: date: note:

architects & urban designers

Tel: 0845 365 1475
Email: mail@adp-ltd.co.uk
www.adparchitectsLtd.co.uk
Richmond Court, 94 Botley Road, Park Gate, Southampton, SO31 1BA

project name/address:

Replacement Wall
Greywell
High Street
Bursledon
SO31 8DL

client:

Mr & Mrs Wiegman

drawing title:

Boundary Wall Details

job number:

2001

drawing number:

05

revision:

B

drawing scale/size:

1:100 (A4)

date:

Nov 23

drawn: