



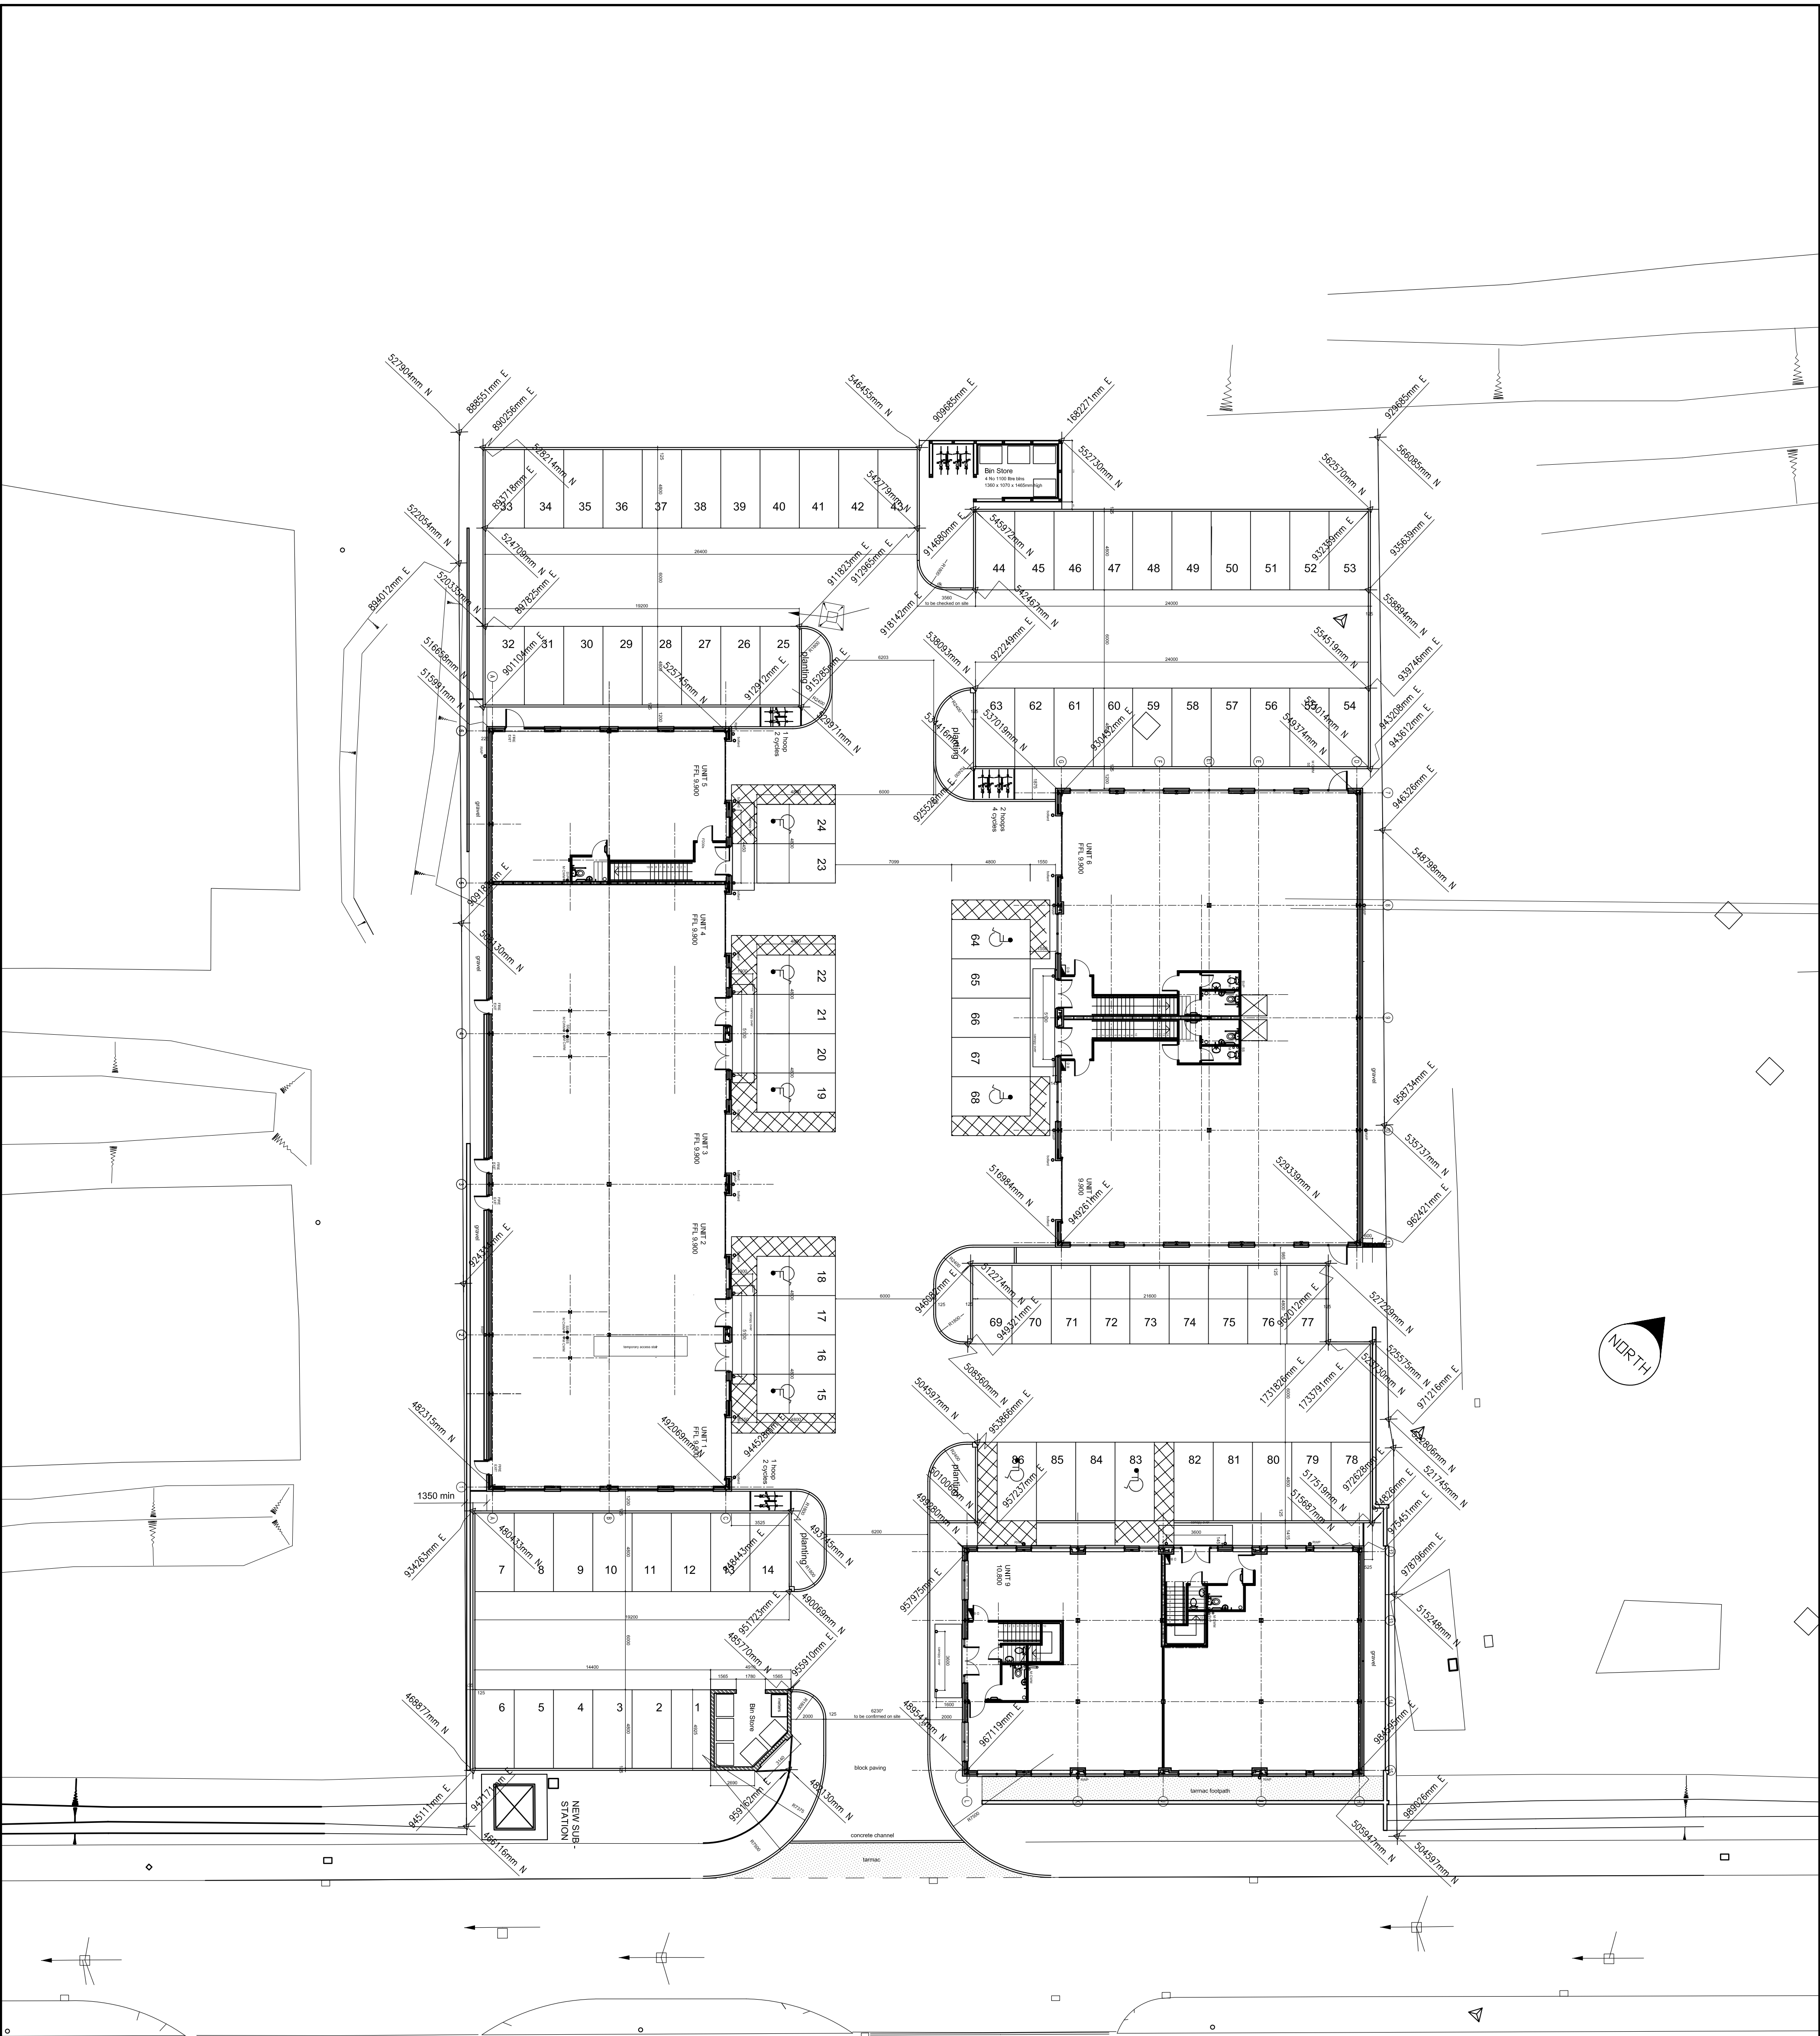

RECORD DRAWING

- F. Minor amendments. Nothing shall be added. J2 20/05/06
- E. Corrections allowed on request by Client. J2 21/04/06
- D. Our post layout drawings shall be a general guide only. J2 09/04/06
- C. Details shall be added to our post layout drawings. J2 14/03/02
- B. Building & or post construction & installation shall be. J2 09/04/06
- A. Final layout & or installation shall. J2 09/04/06

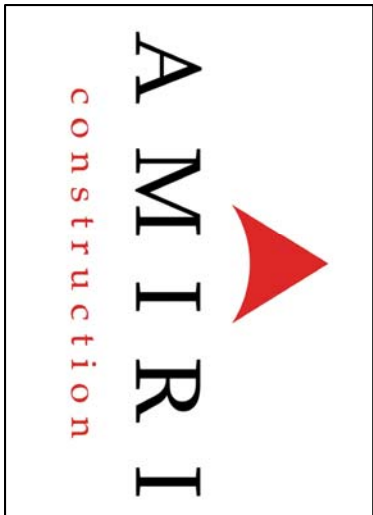

tki
architects

Richard House, Main Road, Chesham
Bucks HP8 4JF
Tel: 01962 714 007 Fax: 01962 714 170
www.tki.co.uk email: architects@tki.co.uk

CLIENT
Amiri Construction Limited

PROJECT TITLE
Proposed Industrial Units,
South Point, Ensign Way,
Hamble

DRAWING TITLE
Site Plan

DRAWN BY
Jg

CHECKED BY
DATE
Aug 07

PROJECT No
070724

SCALE
1:200@A1

DRAWING No
005

REVISION
F

AMIRI CONSTRUCTION LTD. IS NOT RESPONSIBLE FOR THE ACCURACY OF THE INFORMATION PROVIDED BY THE CLIENT. THE CLIENT IS RESPONSIBLE FOR THE ACCURACY OF THE INFORMATION PROVIDED BY THE CLIENT. THE CLIENT IS RESPONSIBLE FOR THE ACCURACY OF THE INFORMATION PROVIDED BY THE CLIENT.