

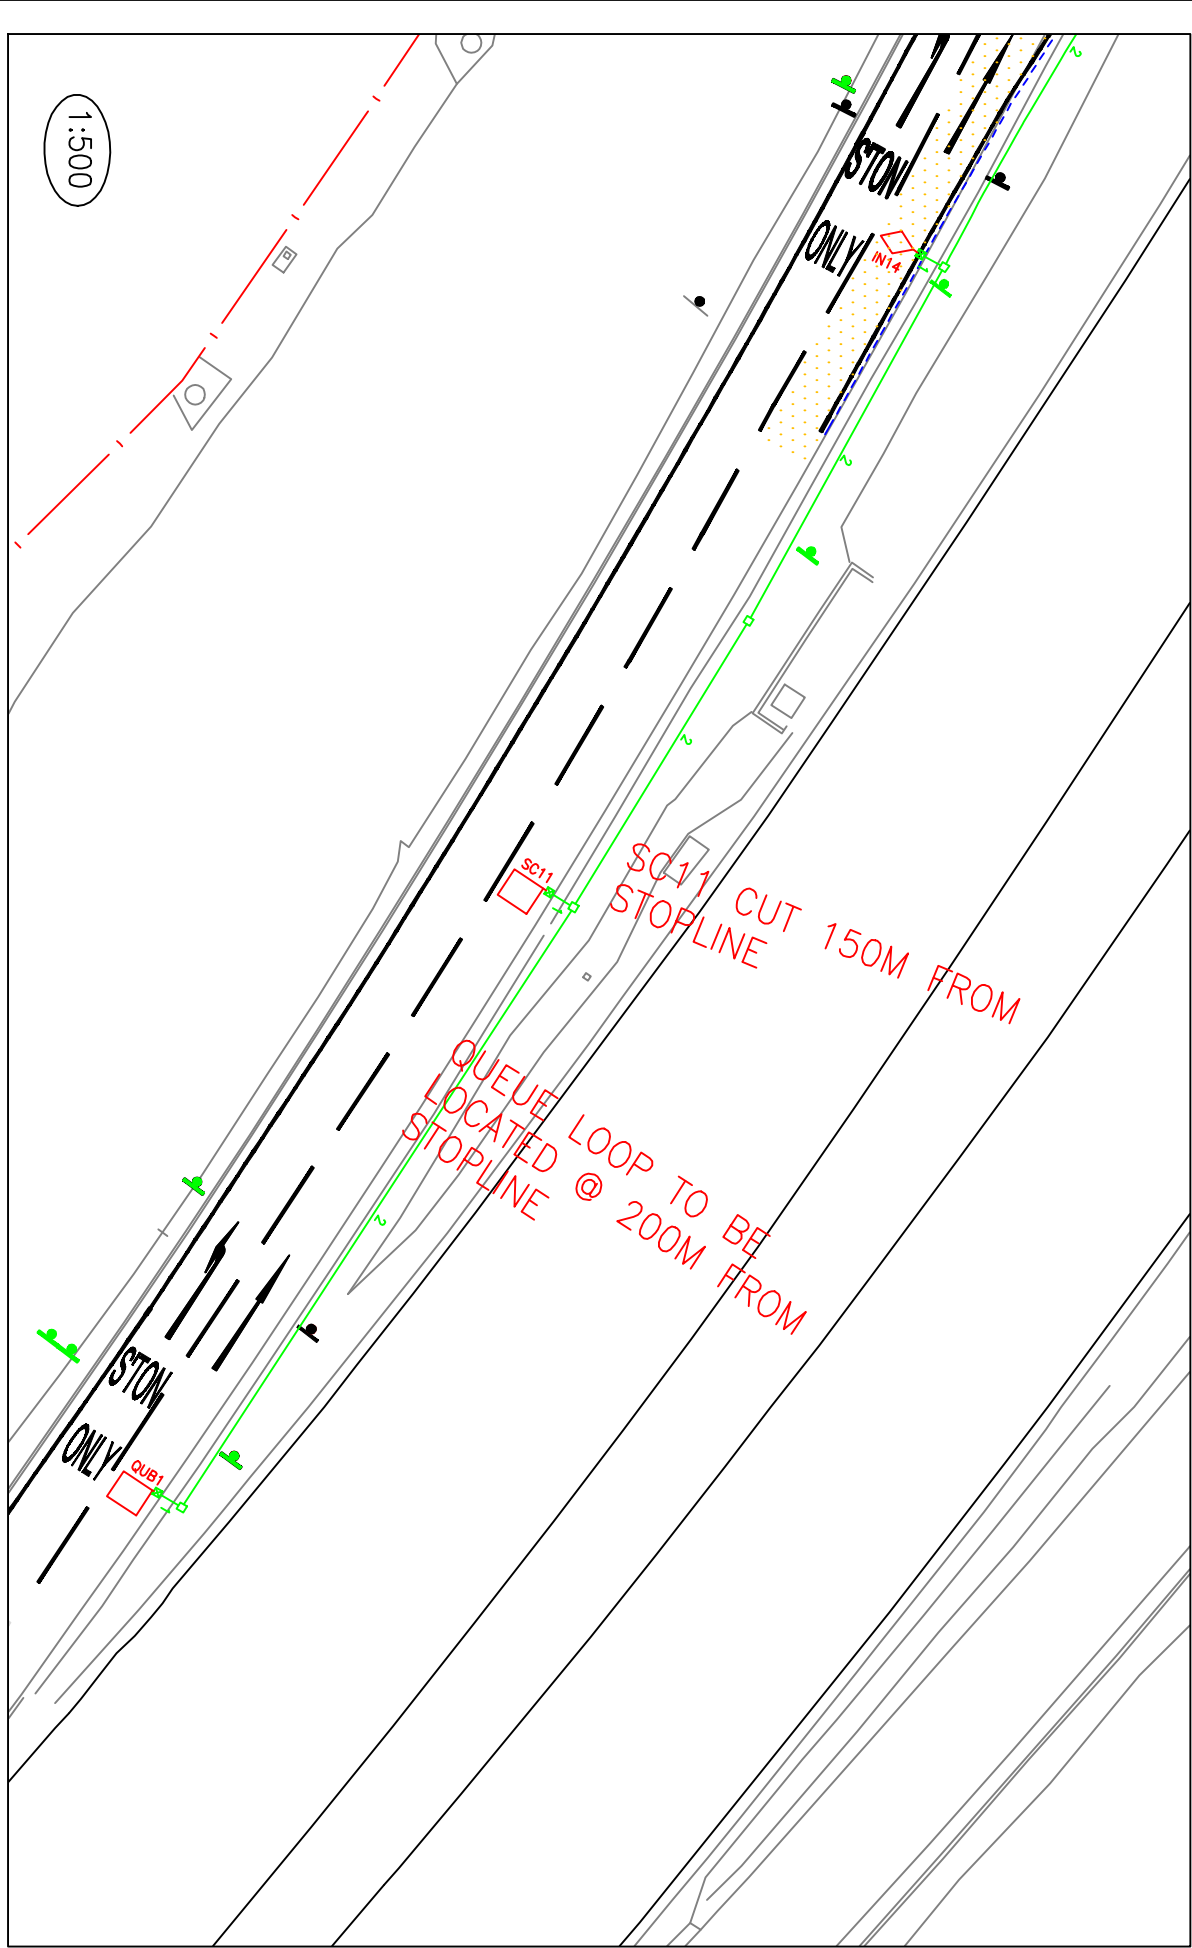
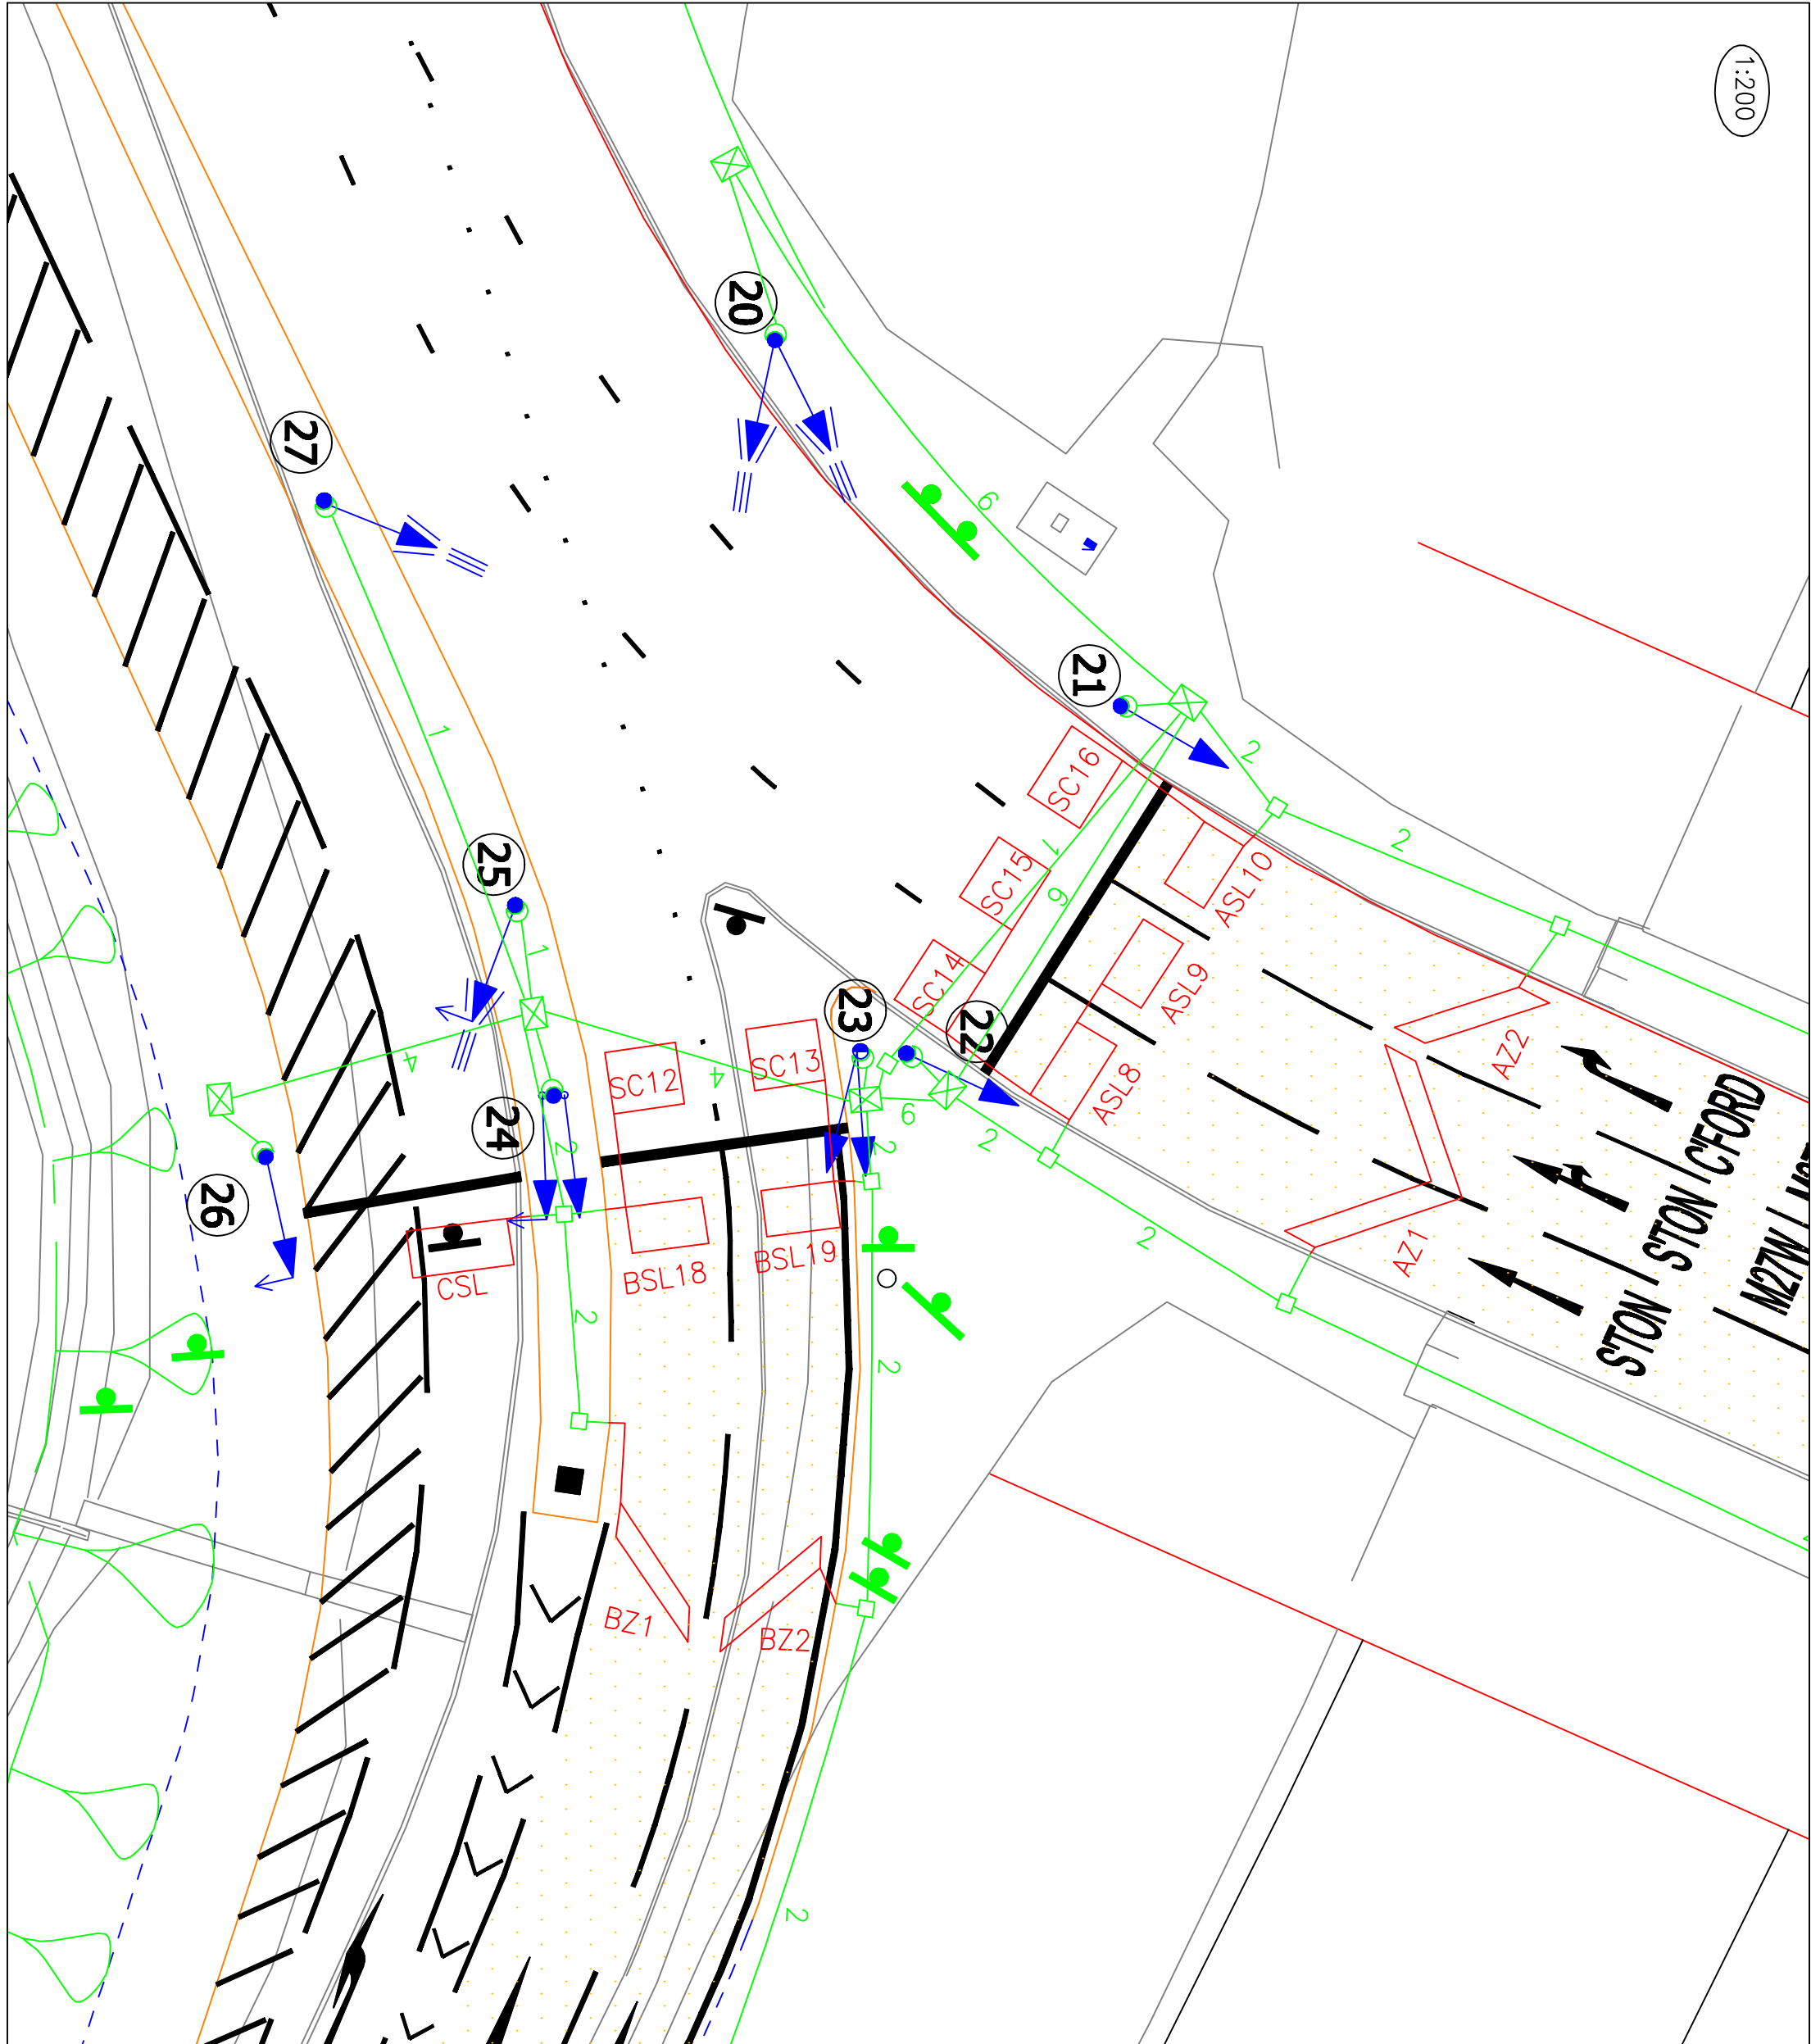


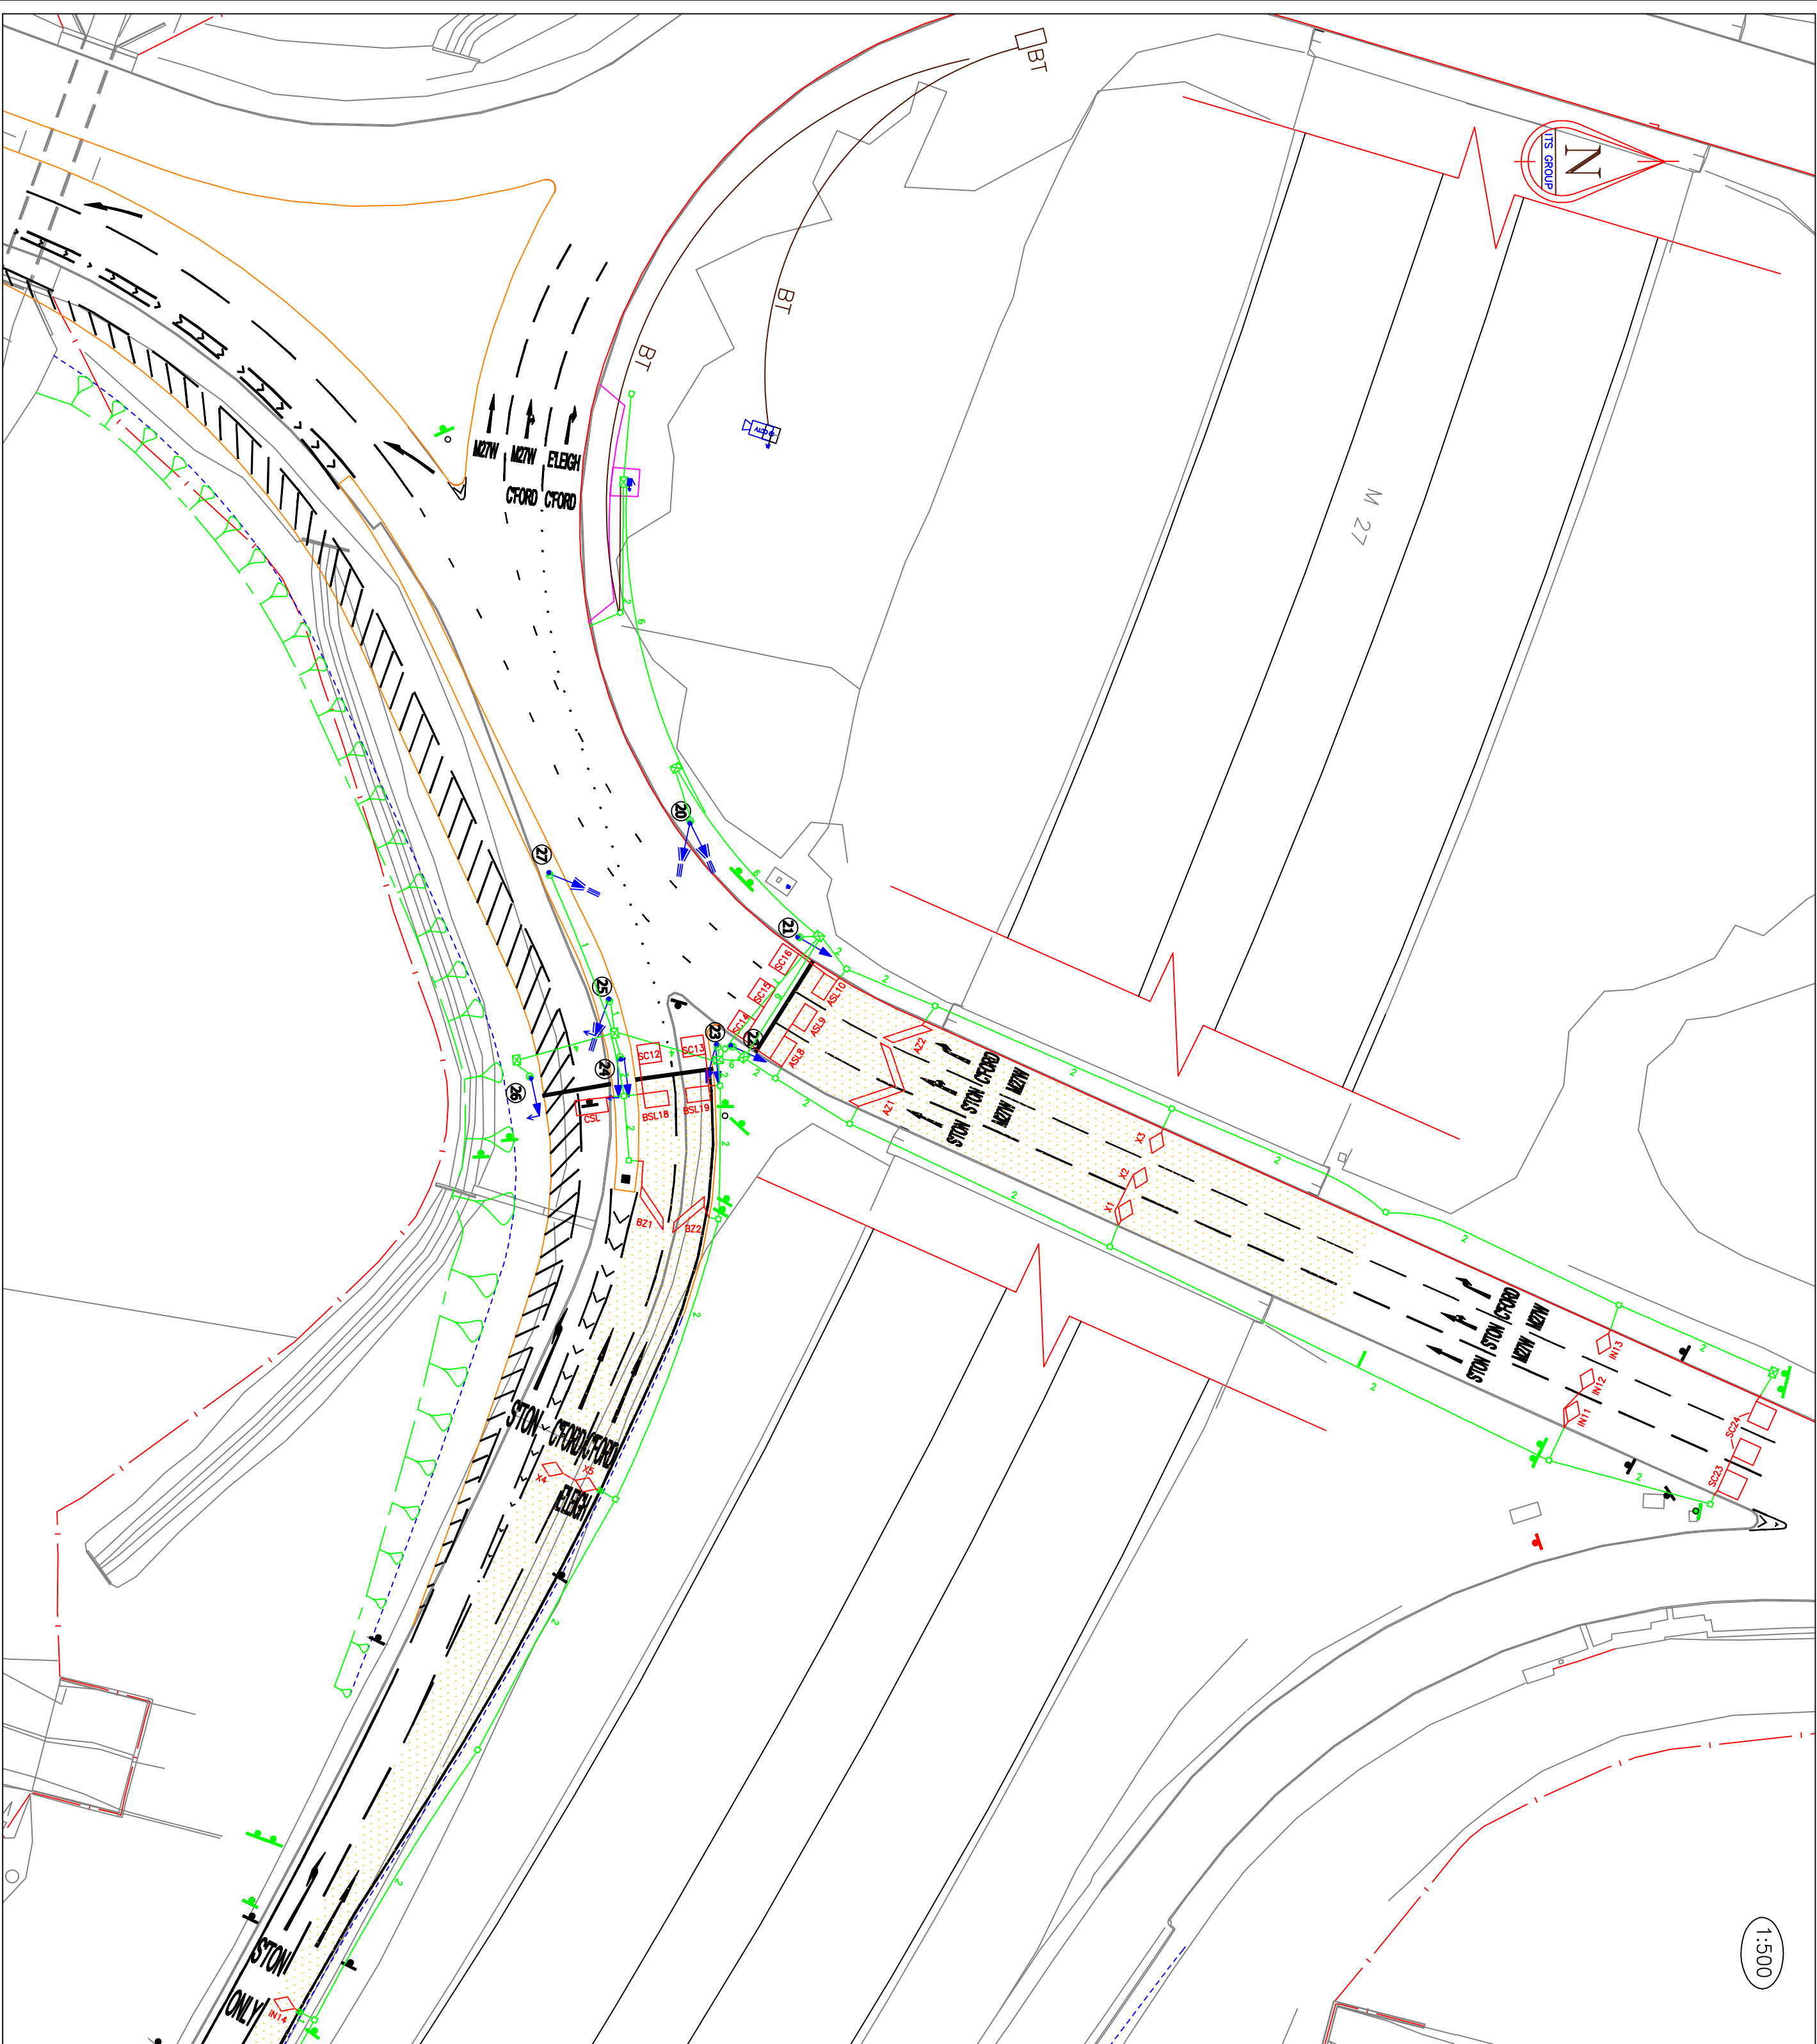

SIGNAL HEAD TYPE SCHEDULE	
1	2
3	4
5	6
7	8
9	10
11	12
13	14
15	16
17	18
19	20
21	22

LEGEND	
PRIMARY SIGNAL WITH POLE	PRIMARY SIGNAL WITH POLE
SECONDARY SIGNAL WITH POLE	SECONDARY SIGNAL WITH POLE
PRIMARY SIGNAL AND POLE WITH GREEN ROUNDEL REPLACED WITH LT ARROW	PRIMARY SIGNAL AND POLE WITH GREEN ROUNDEL REPLACED WITH LT ARROW
SECONDARY SIGNAL WITH ADJUSTABLE VERTICAL LOUVERS	SECONDARY SIGNAL WITH ADJUSTABLE VERTICAL LOUVERS
7 METRE TALL POLE	7 METRE TALL POLE
CONTROLLER	CONTROLLER
POWER SUPPLY FREEDOM PLANT	POWER SUPPLY FREEDOM PLANT
TYPE 2 DRAWNIT	TYPE 2 DRAWNIT
ONE WAY STOP SIGN	ONE WAY STOP SIGN
NAL RETENTION SOCKET	NAL RETENTION SOCKET
SLOT CUTTING	SLOT CUTTING
STOP LINE	STOP LINE
BLUF ANTISED COLOURED SURFACING	BLUF ANTISED COLOURED SURFACING
CCTV SITE	CCTV SITE

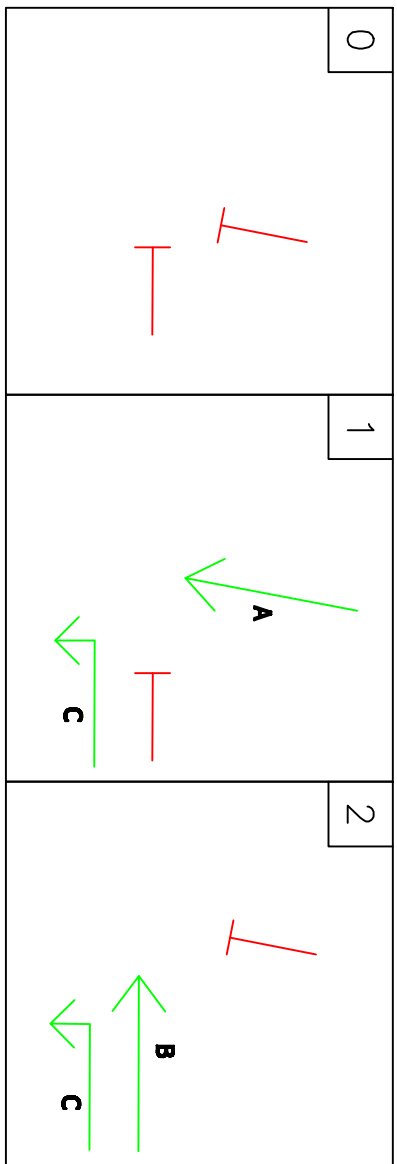

REV.	AMENDMENTS	DATE	DRAWN	CHECKD	APPD
Hampshire County Council					
ALISON QUANT BSc, MSc, MPhil, DIRECTOR OF ENVIRONMENT					
THE CASTLE, WINCHESTER.					
SCHEME					
M27 JUNCTION 5					
WESTBOUND OFFSLIP					
HAS009					
JOB No.					
DRAWING TITLE					
AS BUILT					
SCALE	DRAWN	CHECKED	SHEET No.		
AS SHOWN	SB	JAM			
DATE	TRACED/CAD	APPROVED			
24/6/10	EC	ARG			
DRG No	HAS009	REV	SUFFX		