
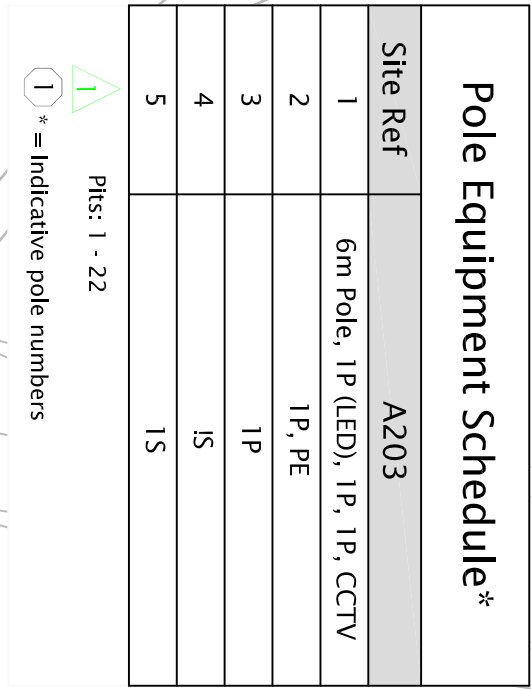


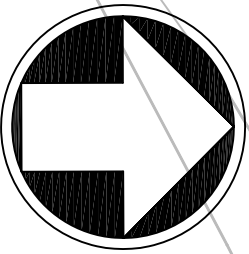

Pts: 1 - 17

 = Indicative pole numbers

FIGS. 1 - 22

1* = Indicative pole numbers

NOTES:-

1. SIGNAL HEADS ARE EITHER PRIMARY (→) OR SECONDARY (→), AS DEPICTED ON THE DRAWING.
2. ALL SIGNAL HEADS AND BOX SIGNS SHALL BE FITTED WITH APPROPRIATE HOODS AND BACKING BOARDS (AND LOUVRES WHERE SPECIFIED).

This document should not be relied on or used in circumstances other than those for which it was originally prepared and for which Mott MacDonald was commissioned. Mott MacDonald accepts no responsibility for this document to any party other than the person by whom it was commissioned.

<i>Safe Roads:</i>	
<i>Reliable Journeys:</i>	
<i>Informed Travellers:</i>	
Notes	

[illegible]

A6	29.08.08	JBS	As built		
Rev	Date	Drawn	Description	Chk'd	App'd

In association with

 Hampshire
County Council

 Scott
Wilson

HIGHWAYS
AGENCY

Federated House
London Road
Dorking RH4 1SZ

Title
M27 Junction 5 Site Reference A202-A203

Designed			Eng.Chk.	IR	
Drawn	JRS		Coordination		
Dwg.Chk.	BR		Approved	AC	
Scale	Project				Status
1:500 @ A1					ASB
Drawing No					Rev
A202-A203					AB