

Notes:

OTHER THAN FOR THE PURPOSES OF PLANNING, DO NOT SCALE THESE DRAWINGS.
USE WRITTEN DIMENSIONS ONLY. ALL DIMENSIONS TO BE CHECKED ON SITE PRIOR TO
CONSTRUCTION WORK.
THIS DRAWING IS THE PROPERTY OF SIMPSON HILDER ASSOCIATES LIMITED AND MAY NOT
BE REPRODUCED, COPIED OR ALTERED IN ANY WAY WITHOUT WRITTEN AUTHORITY

IT/MS CLOUD WITH A DASHED LINE
ARE TO BE CONFINED. SUBJECT TO
DETAIL DESIGN AND CAN BE EXPECTED
TO CHANGE.

REVISION CLOUD.

THE RECORD INFORMATION INDICATED ON THIS
DRAWING HAS BEEN PREPARED FROM INFORMATION
PROVIDED BY OTHERS AND SH/A ARE UNABLE TO
GUARANTEE THAT THIS DRAWING ACCURATELY
REFLECTS THE ON SITE CONSTRUCTION IN ALL
RESPECTS. IT IS STRONGLY RECOMMENDED THAT ALL
CONTRACTORS ETC UNDER TAKE THEIR OWN SITE
SURVEY AND CONSTRUCTION DETAILS AND DIMENSIONS PRIOR TO
UNDER TAKING ANY WORK THAT MIGHT BE RELIANT ON
INFORMATION INDICATED ON THESE DRAWINGS.

Rev	Date	Description	By	Check
Drawing Status				
RECORD DRAWING				

Client

Principal Contractor

Design Consultant




SIMPSON HILDER
ASSOCIATES LIMITED

67A HIGH STREET
LYNDHURST
S043 7SRNE
T: 023 80 283798
F: 023 80 283688
E: sh/a@simpsonhilder.co.uk

Project Title
**UNIT B7 MILLBROOK CLOSE
CHANDLERS FORD
EASTLEIGH, SO53 4BZ**

Drawing Title
BLOCK PLAN

Scale (@ A1 SIZE)		Sheet
1:100	1:100	1 of 1
Drawn	Date	Checked
CL	OCTOBER 2024	
Drawing No	10024-502	Revision

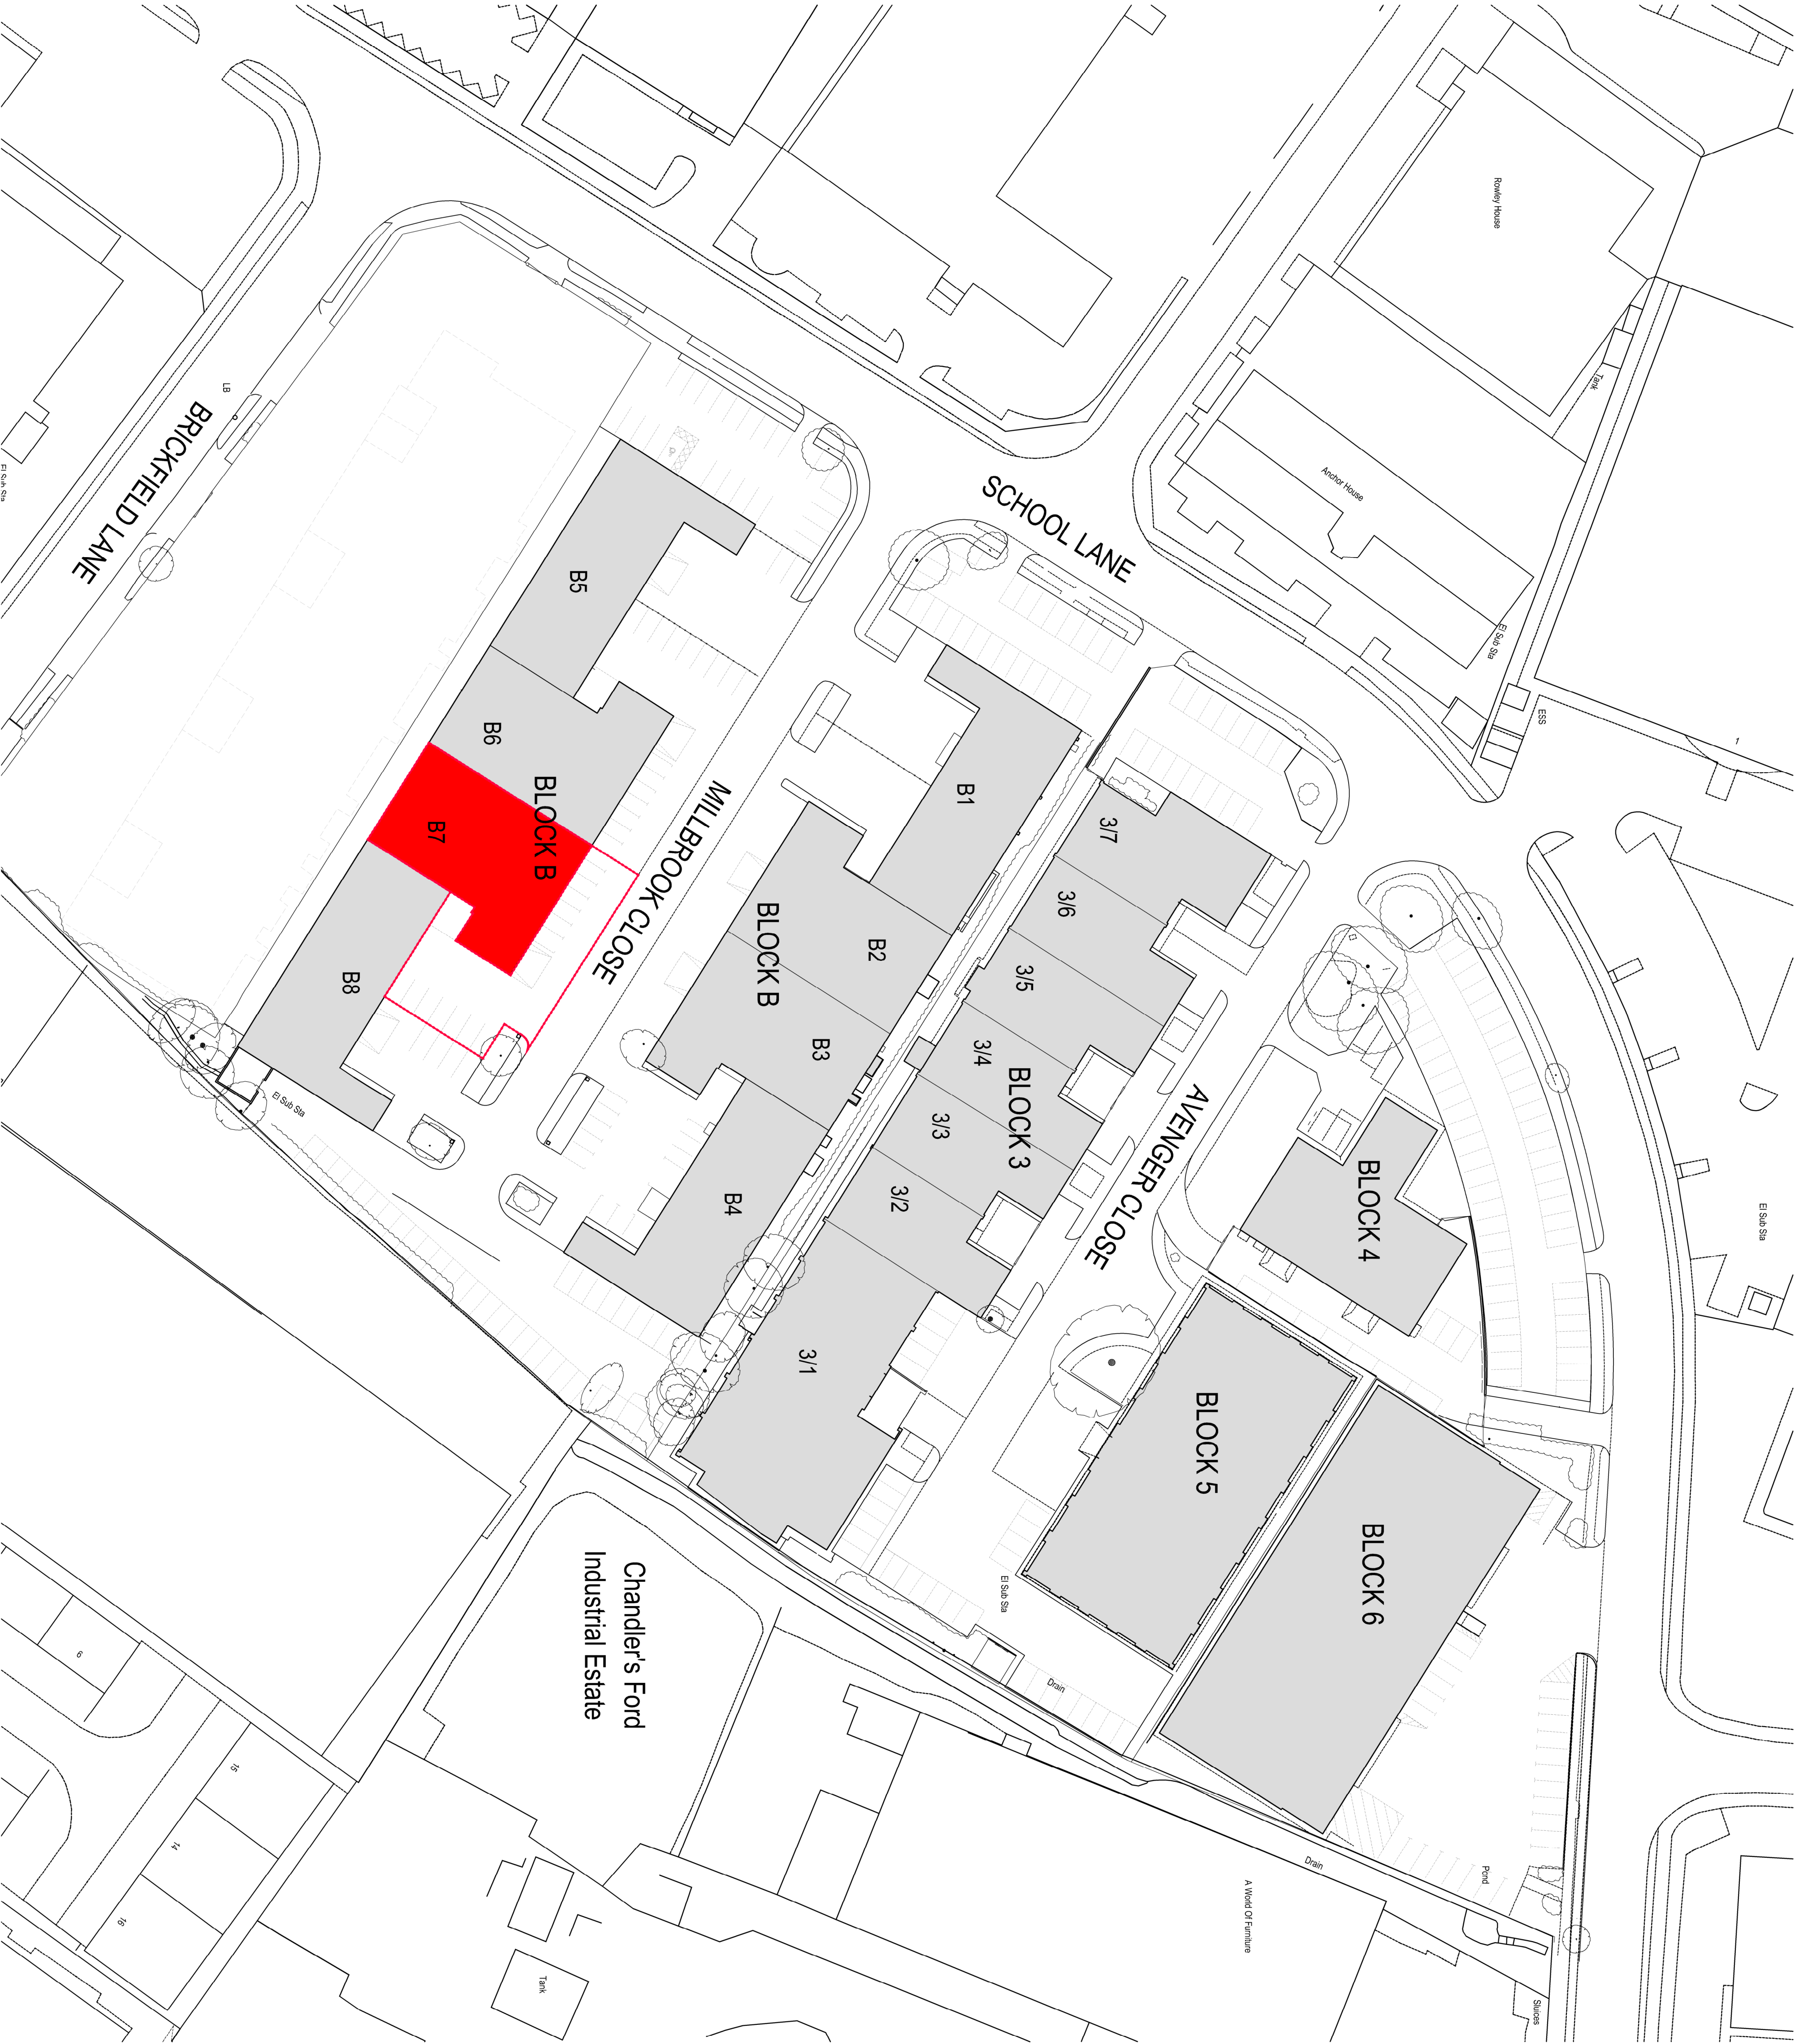

BLOCK PLAN

