


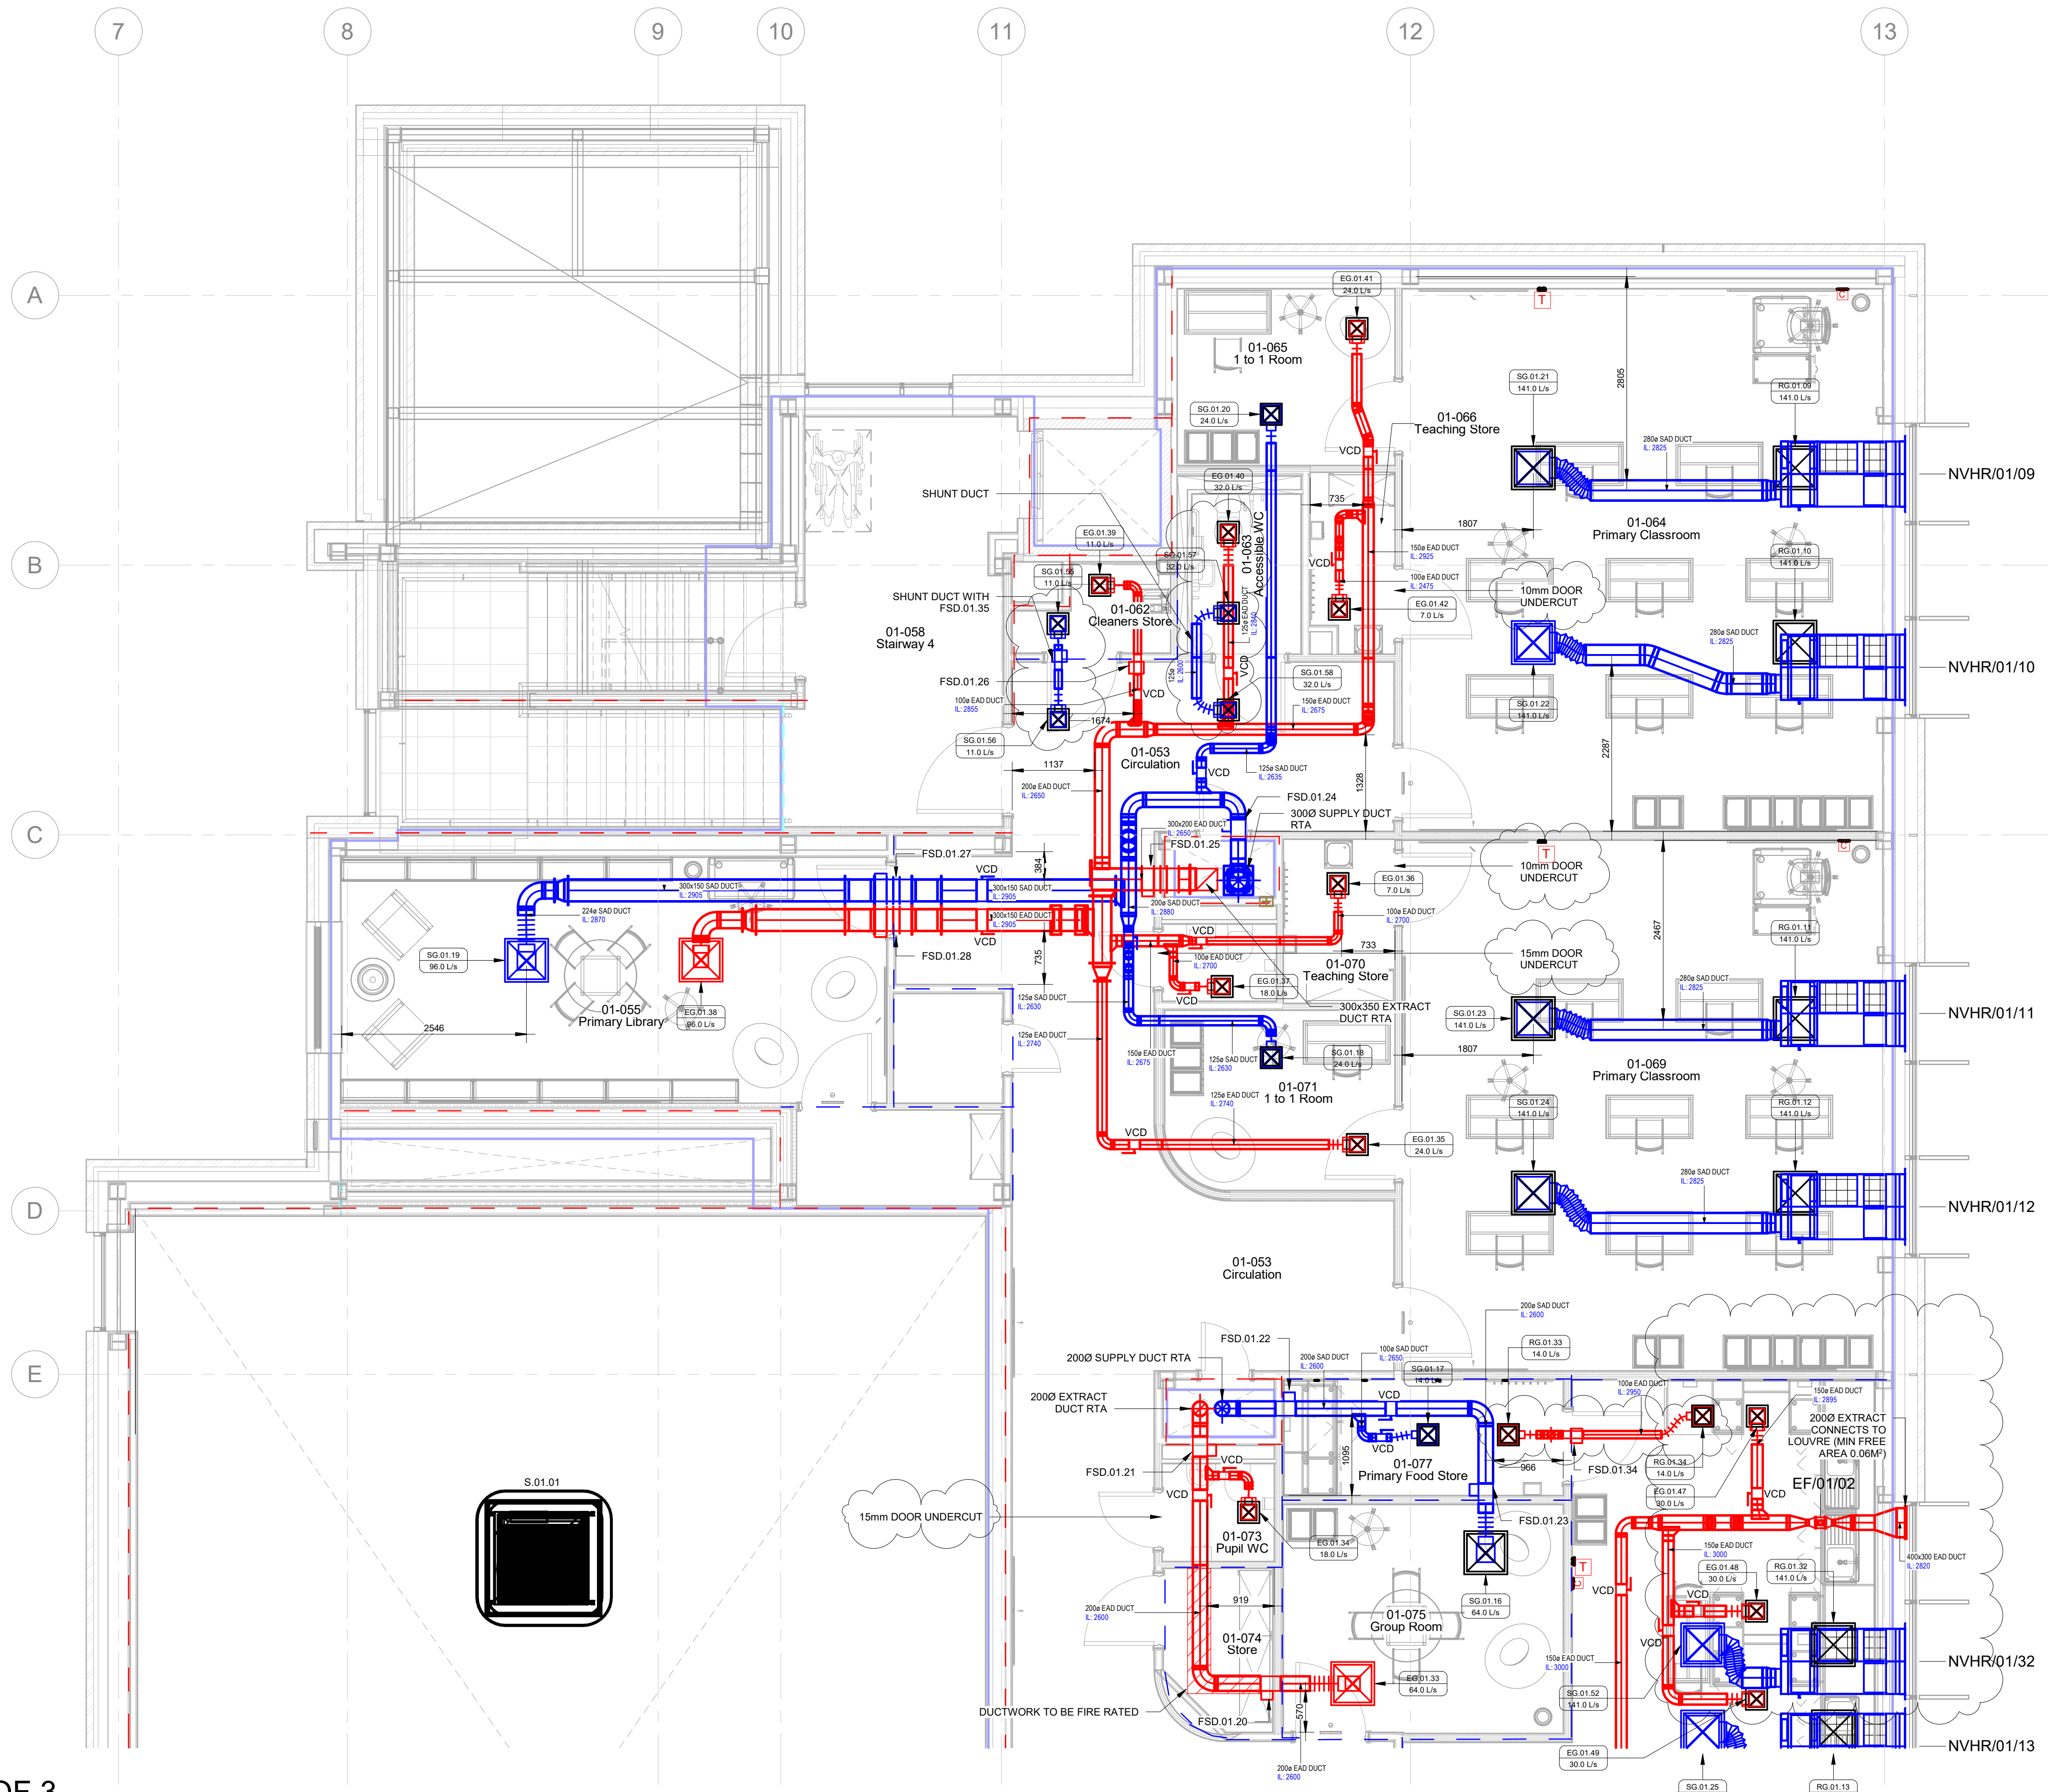

	FIRE STRATEGY 60min INTEGRITY
	FIRE STRATEGY 30min INTEGRITY
	EXTRACT DUCT
	SUPPLY DUCT
	TEMP/CO2 SENSOR
	NVHR CONTROLLER
	ODH CONTROLLER

1 : 50

- ALL FRONT OF HOUSE AREAS OF THE BUILDING WHERE THERE'S PUPIL ACCESS OUTLETS MUST BE FLUSH MOUNTED TO THE WALL.
- CABLE TO DROP IN THE WALLS TO FEED FLUSH MOUNTED OUTLETS.
- DISCLAIMER NOTES:
- THIS DOCUMENT IS COPYRIGHT OF THE ORIGINATOR AND MUST BE TREATED AS CONFIDENTIAL.
- THIS DOCUMENT MUST NOT BE ALTERED, REPRODUCED OR DISTRIBUTED WITHOUT PRIOR WRITTEN CONSENT OF THE ORIGINATOR.
- THIS DOCUMENT MUST NOT BE ALTERED - THE ORIGINATORS ACCEPT NO RESPONSIBILITY FOR ANY DISCREPANCIES ARISING AS A RESULT OF THE ORIGINATORS INFORMATION BEING ALTERED BY OTHERS.
- ANY DISCREPANCY MUST BE REPORTED TO THE ORIGINATOR.
- DO NOT SCALE THIS DOCUMENT-USE FIGURED DIMENSIONS ONLY.
- THIS DOCUMENT MUST BE READ IN CONJUNCTION WITH ALL SUPPORTING DOCUMENTS PRODUCED BY THE ORIGINATOR AND OTHER PROJECT DISCIPLINES.
- THE ORIGINATOR ACCEPTS NO RESPONSIBILITY FOR THE ACCURACY OF BACKGROUND INFORMATION PRODUCED BY THIRD PARTIES- THIS MUST BE TREATED AS INDICATIVE ONLY.
- THE DOCUMENT STATUS 'RECORD' OR 'AS BUILT' HAS BEEN PREPARED, IN PART BASED UPON INFORMATION FURNISHED BY OTHERS. WHILE THIS INFORMATION IS BELIEVED TO BE RELIABLE, THE ORIGINATOR ASSUMES NO RESPONSIBILITY FOR THE ACCURACY OF THIS 'RECORD' OR 'AS BUILT' DOCUMENT OR FOR ANY REASON OF INCORRECT INFORMATION PROVIDED TO THE ORIGINATOR. THOSE RELYING ON THE 'RECORD' OR 'AS BUILT' DOCUMENTS DO SO AT THEIR OWN RISK.

[illegible]

SCALE	DATE	DRAWN	CHECKED	DRAWING NO.	REVISION
As indicated @ A1	06.05.25	H.T	J.D	P13332-REN-ZZ-01-D-M-0312	CO3