


N.B Red line indicates
outline of front
elevation approved
under application
F/12/70879




West (Front) Elevation - As Proposed




West (Front) Elevation - As Proposed

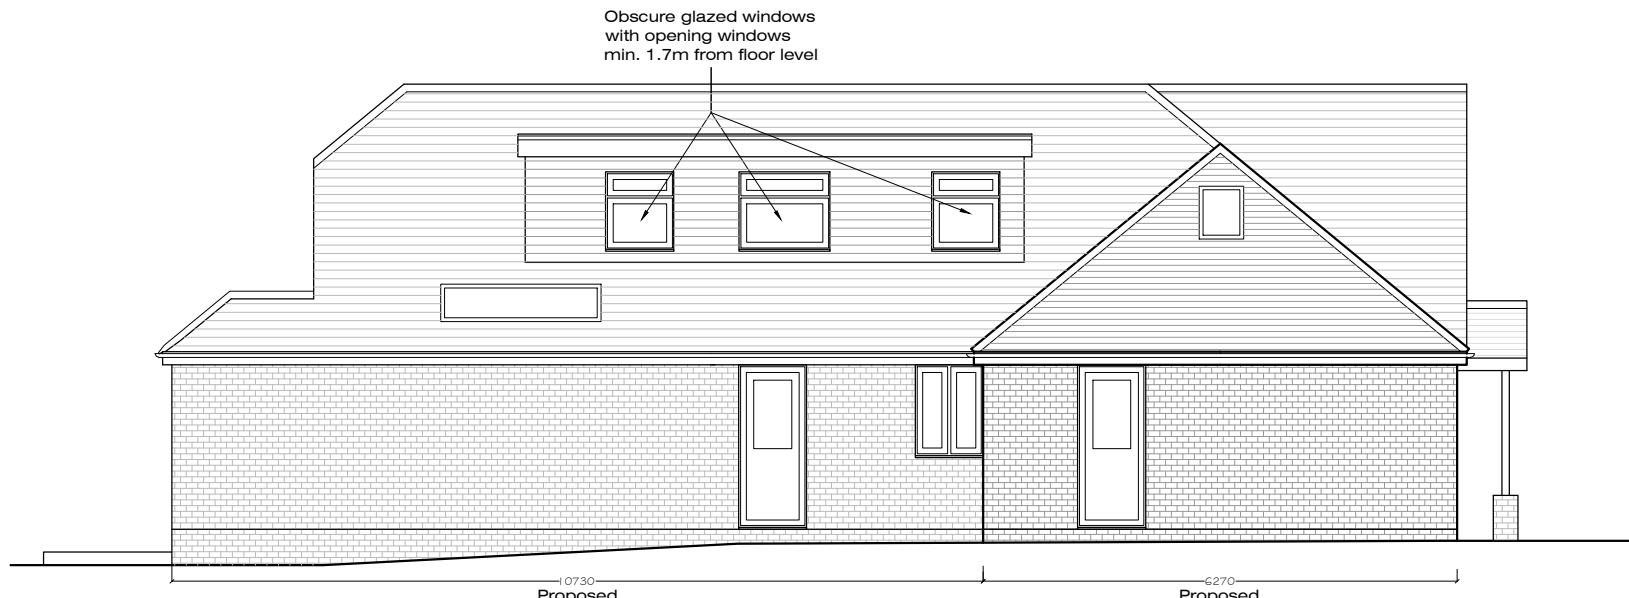


North (Side) Elevation - As Proposed

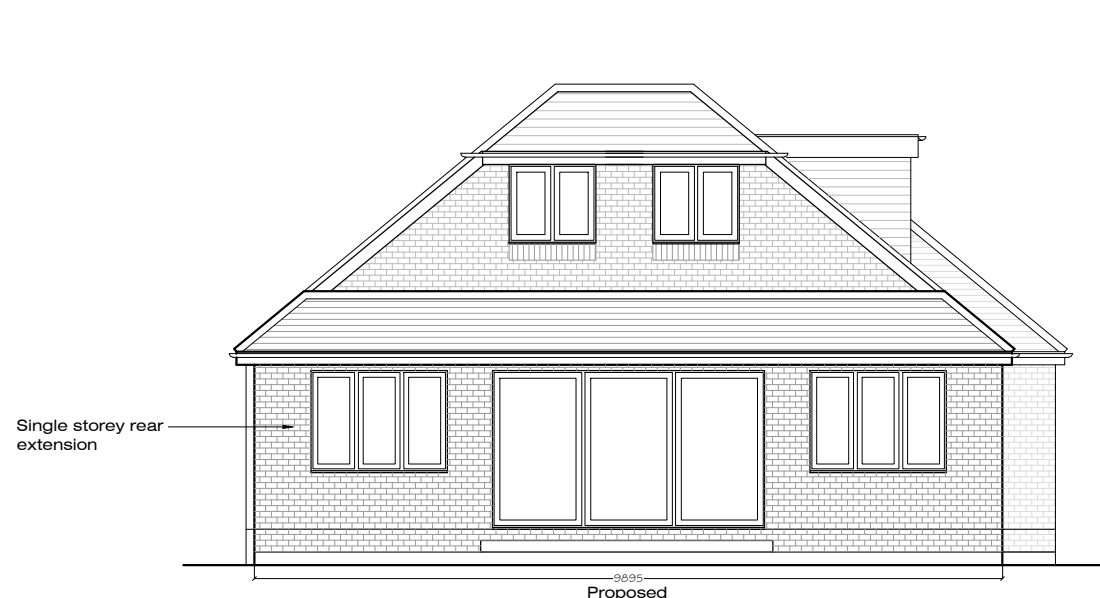



East (Rear) Elevation - As Proposed

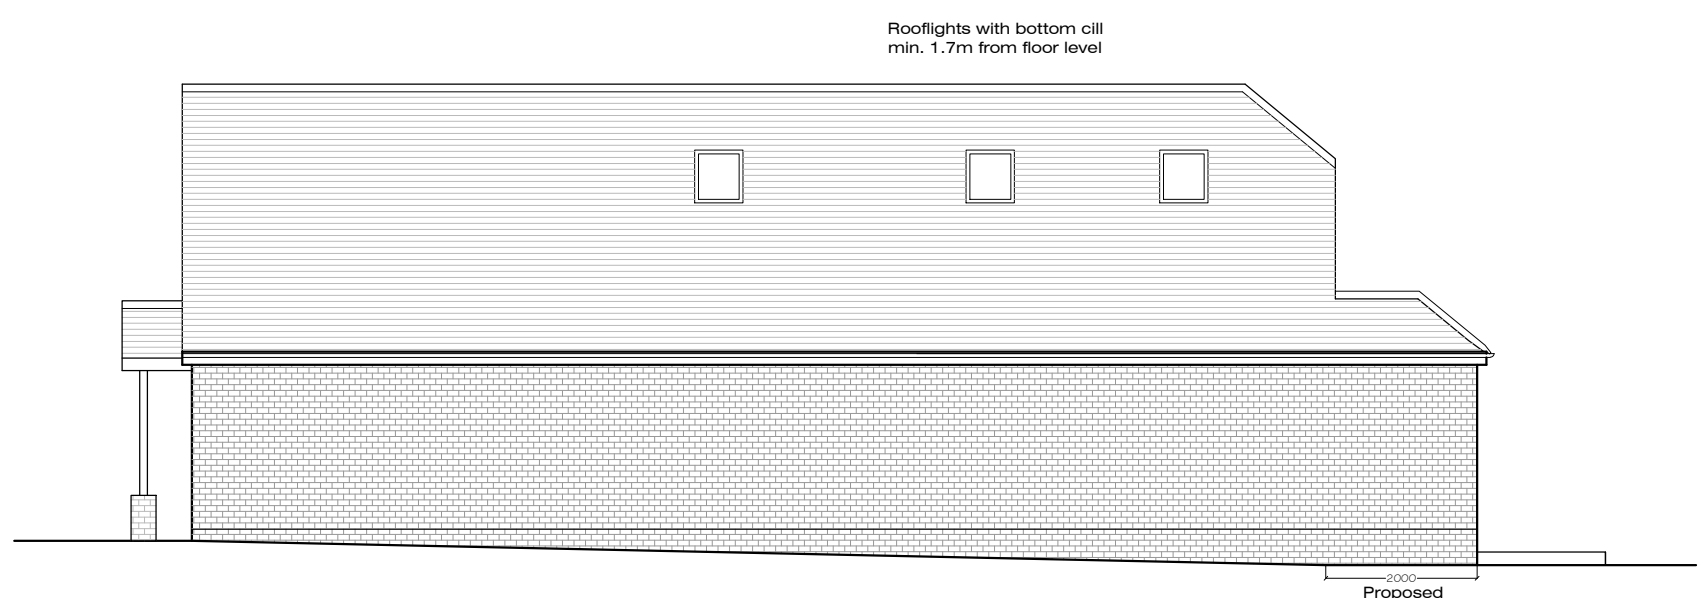


South (Side) Elevation - As Proposed

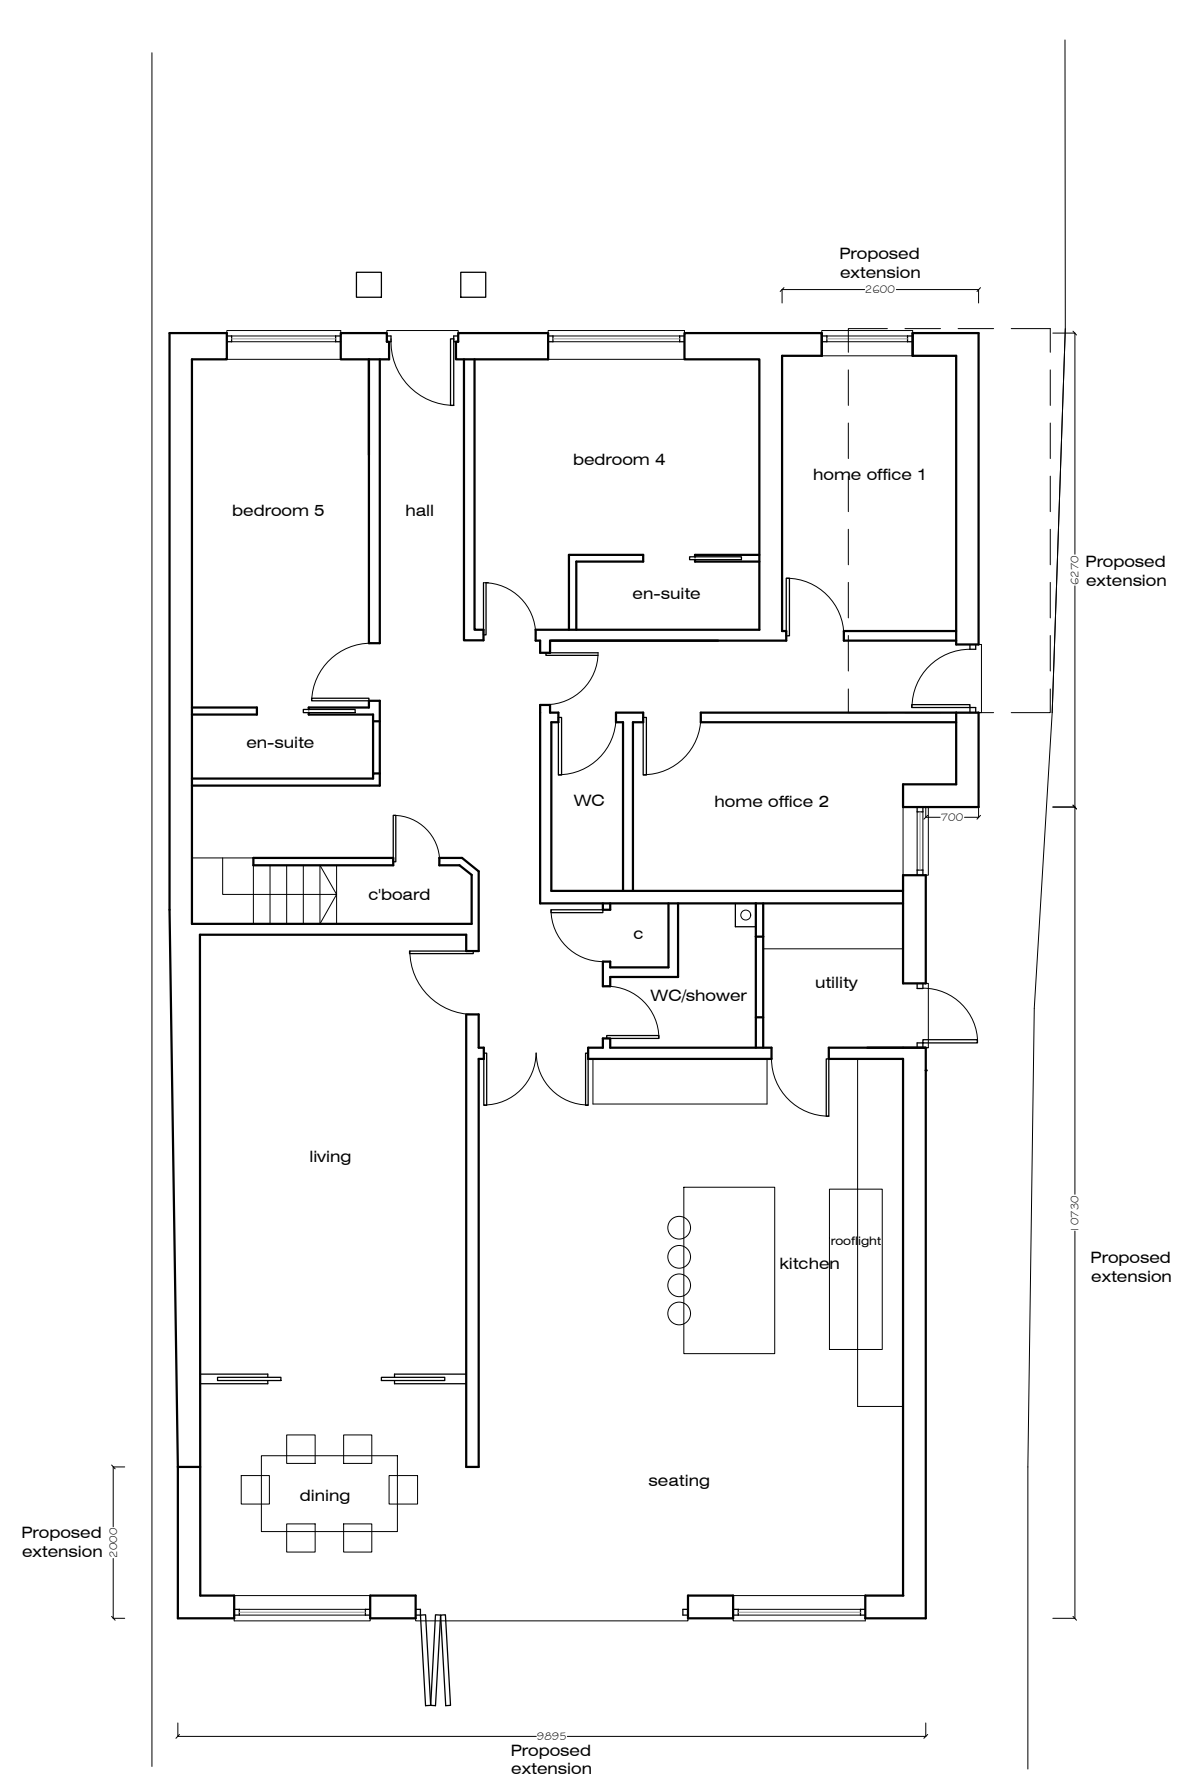

Ground Floor Plan - As Proposed

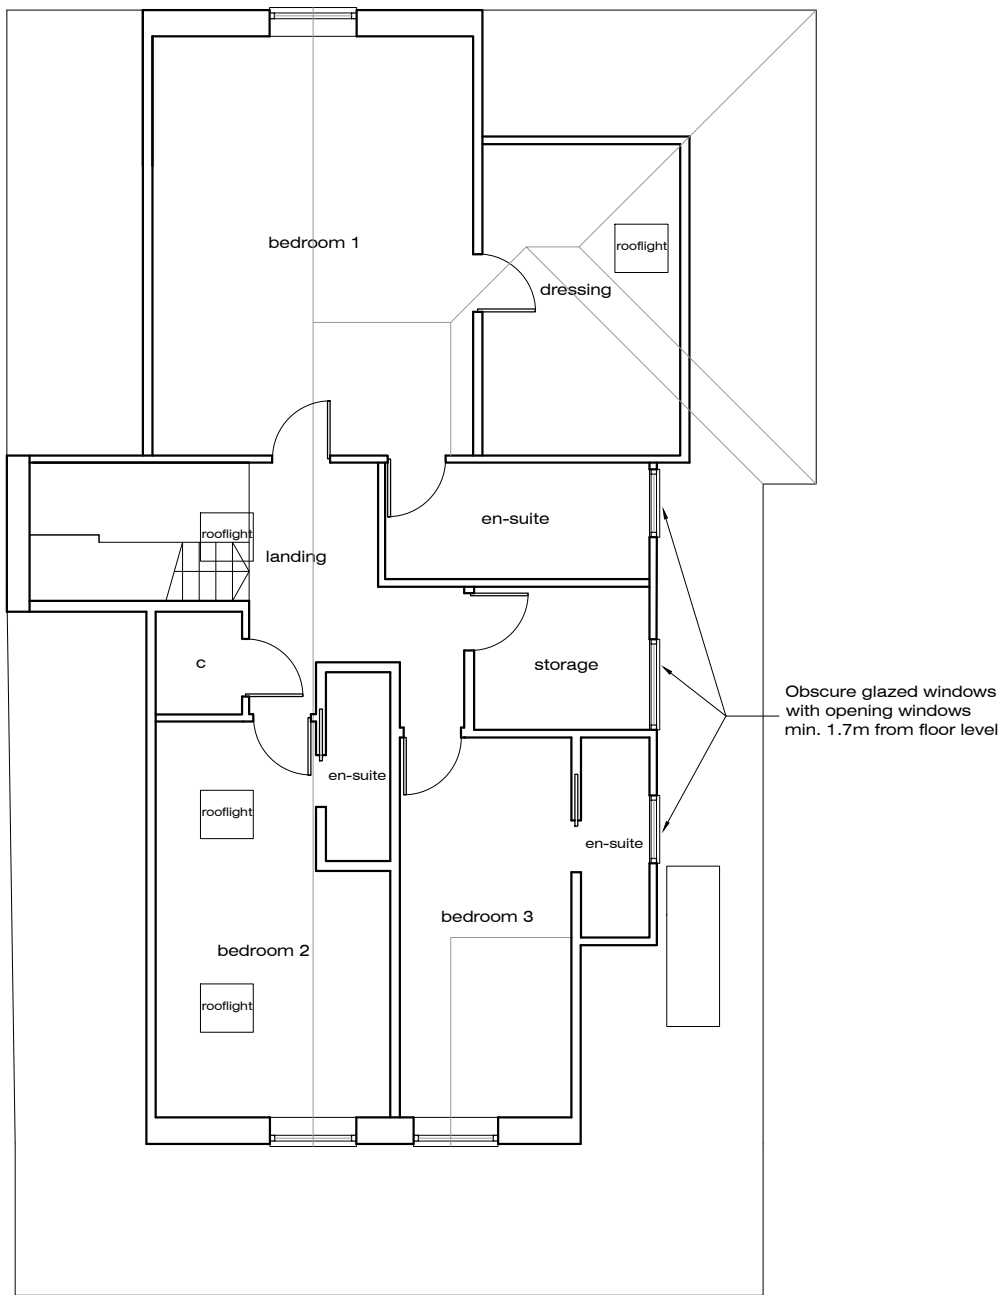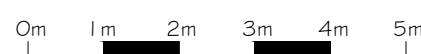

First Floor Plan - As Proposed

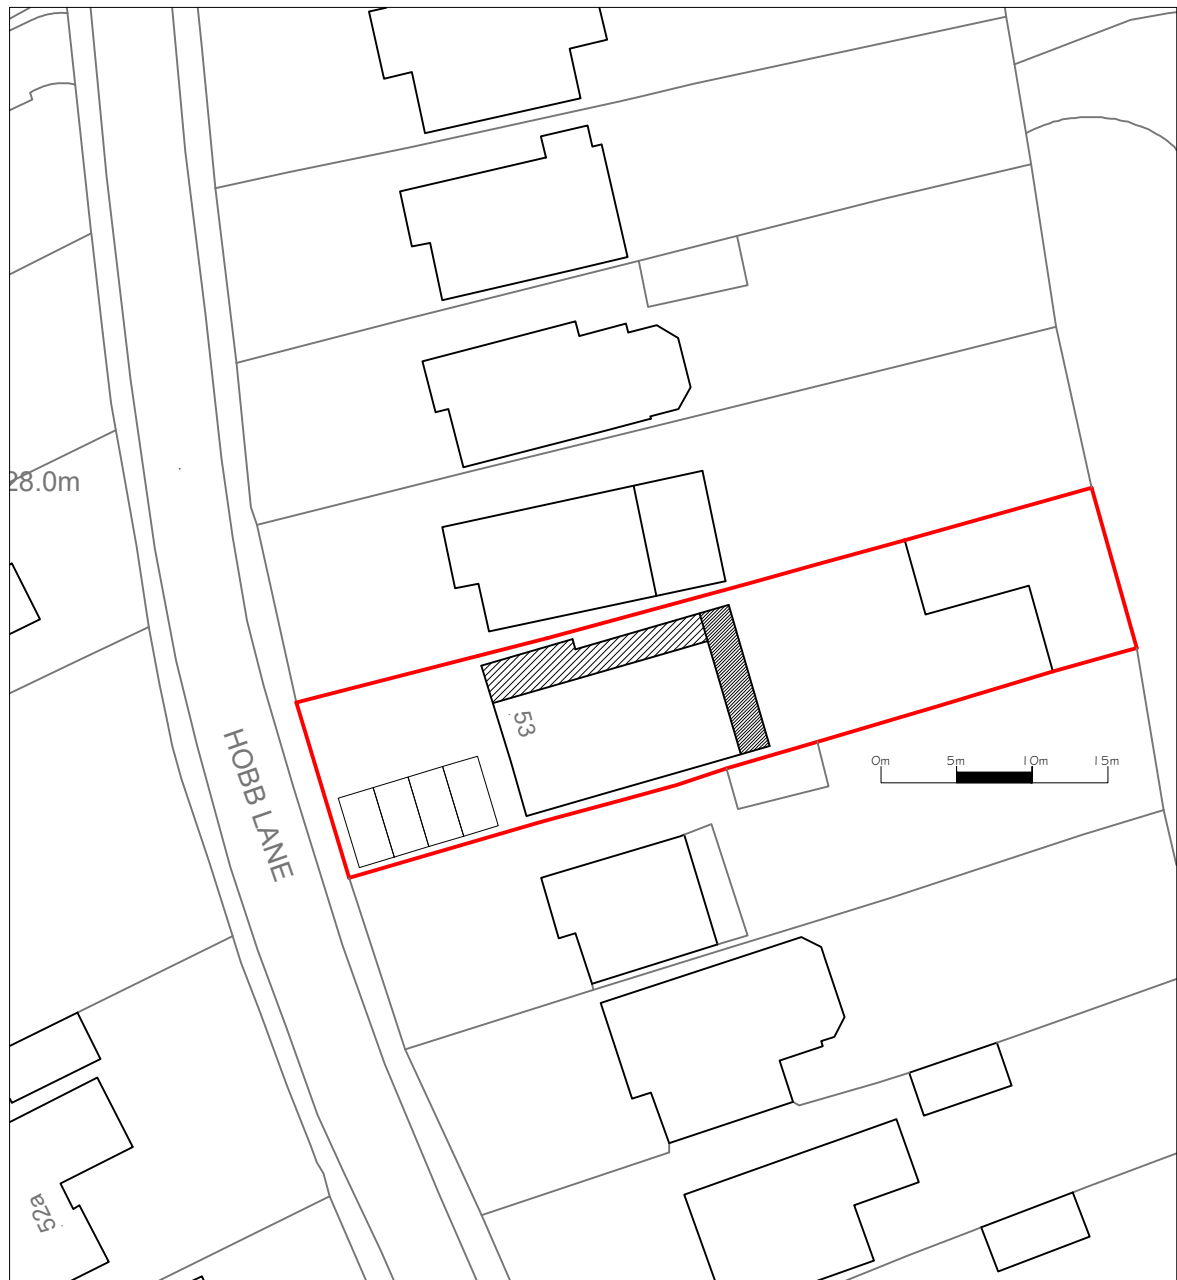

Block Plan - As Proposed 1:500

-	Issued for Planning Application	NJ	22-01-26
Rev.		By	Date

Wildern Architecture Ltd
The Hawthorns, 105 Dibles Road,
Warsash, Southampton, SO31 9JL
07920 260758

Project
53 Hobb Lane, Hedge End,
Southampton, SO30 0GG

Client
Mr and Mrs A Akpan

Title Plans & Elevations - As Proposed			
Date	May 24	Drawn By	NJ
Job No.	Drawing No.	Scale	Revision
W23-028	101	1:100 /500@A1	-