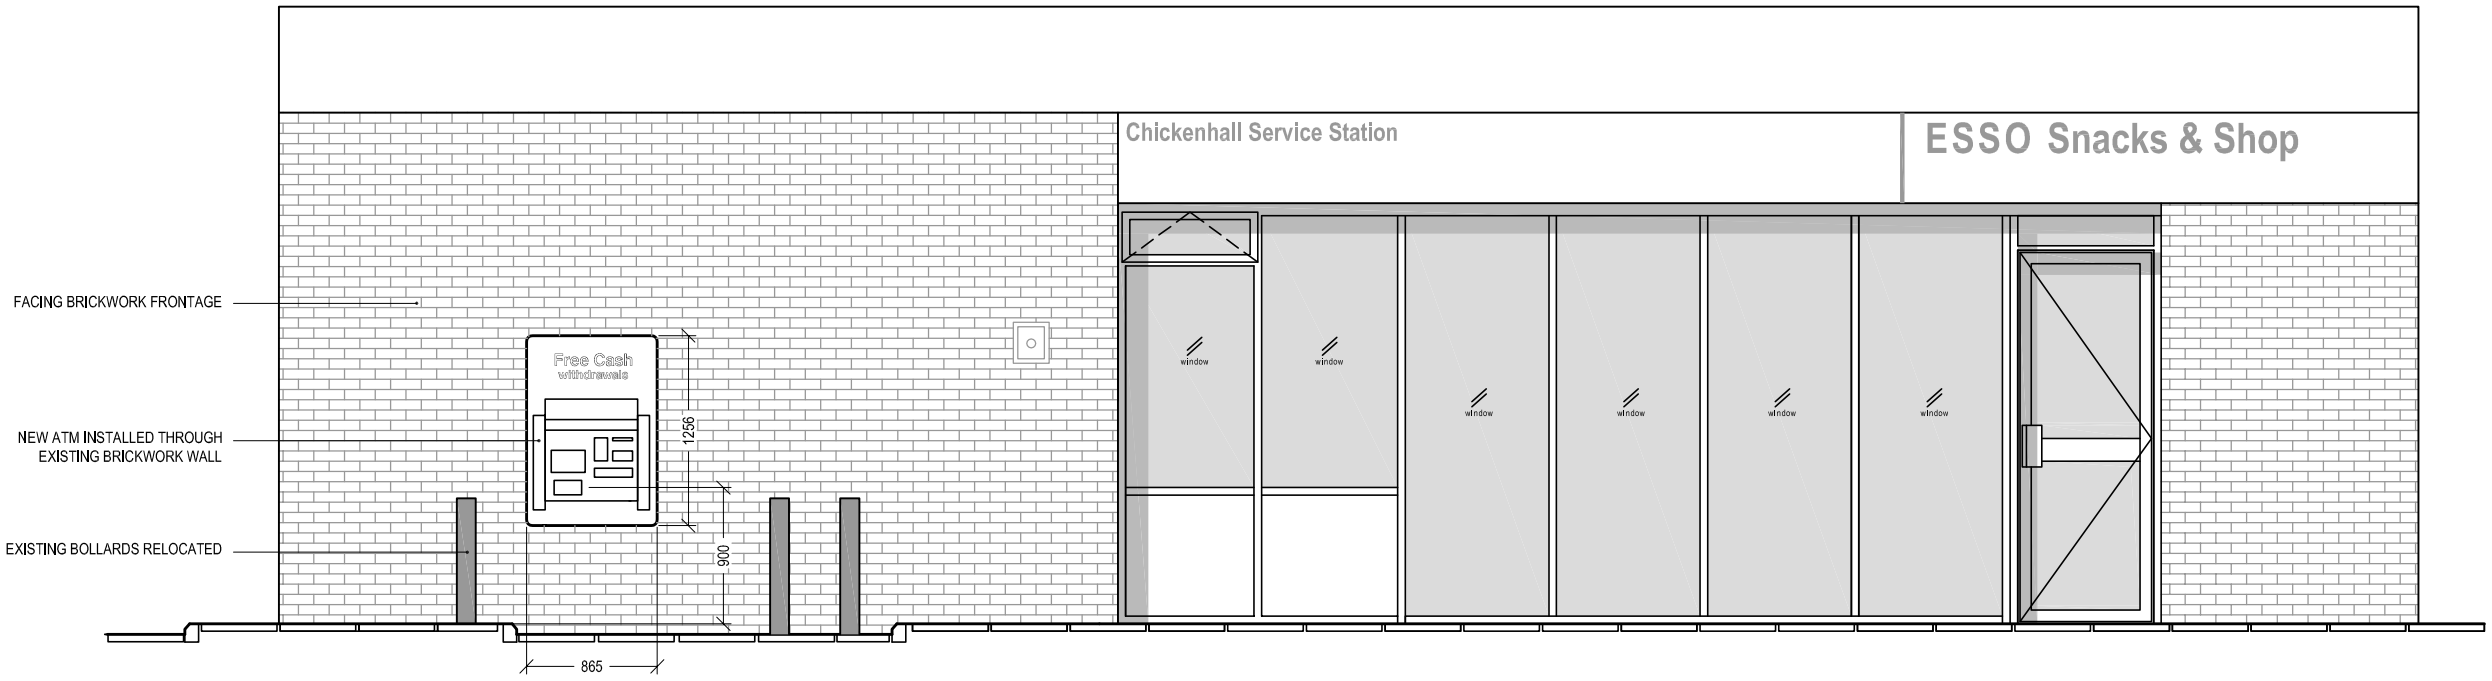

AS INSTALLED FRONT ELEVATION
Scale 1:50

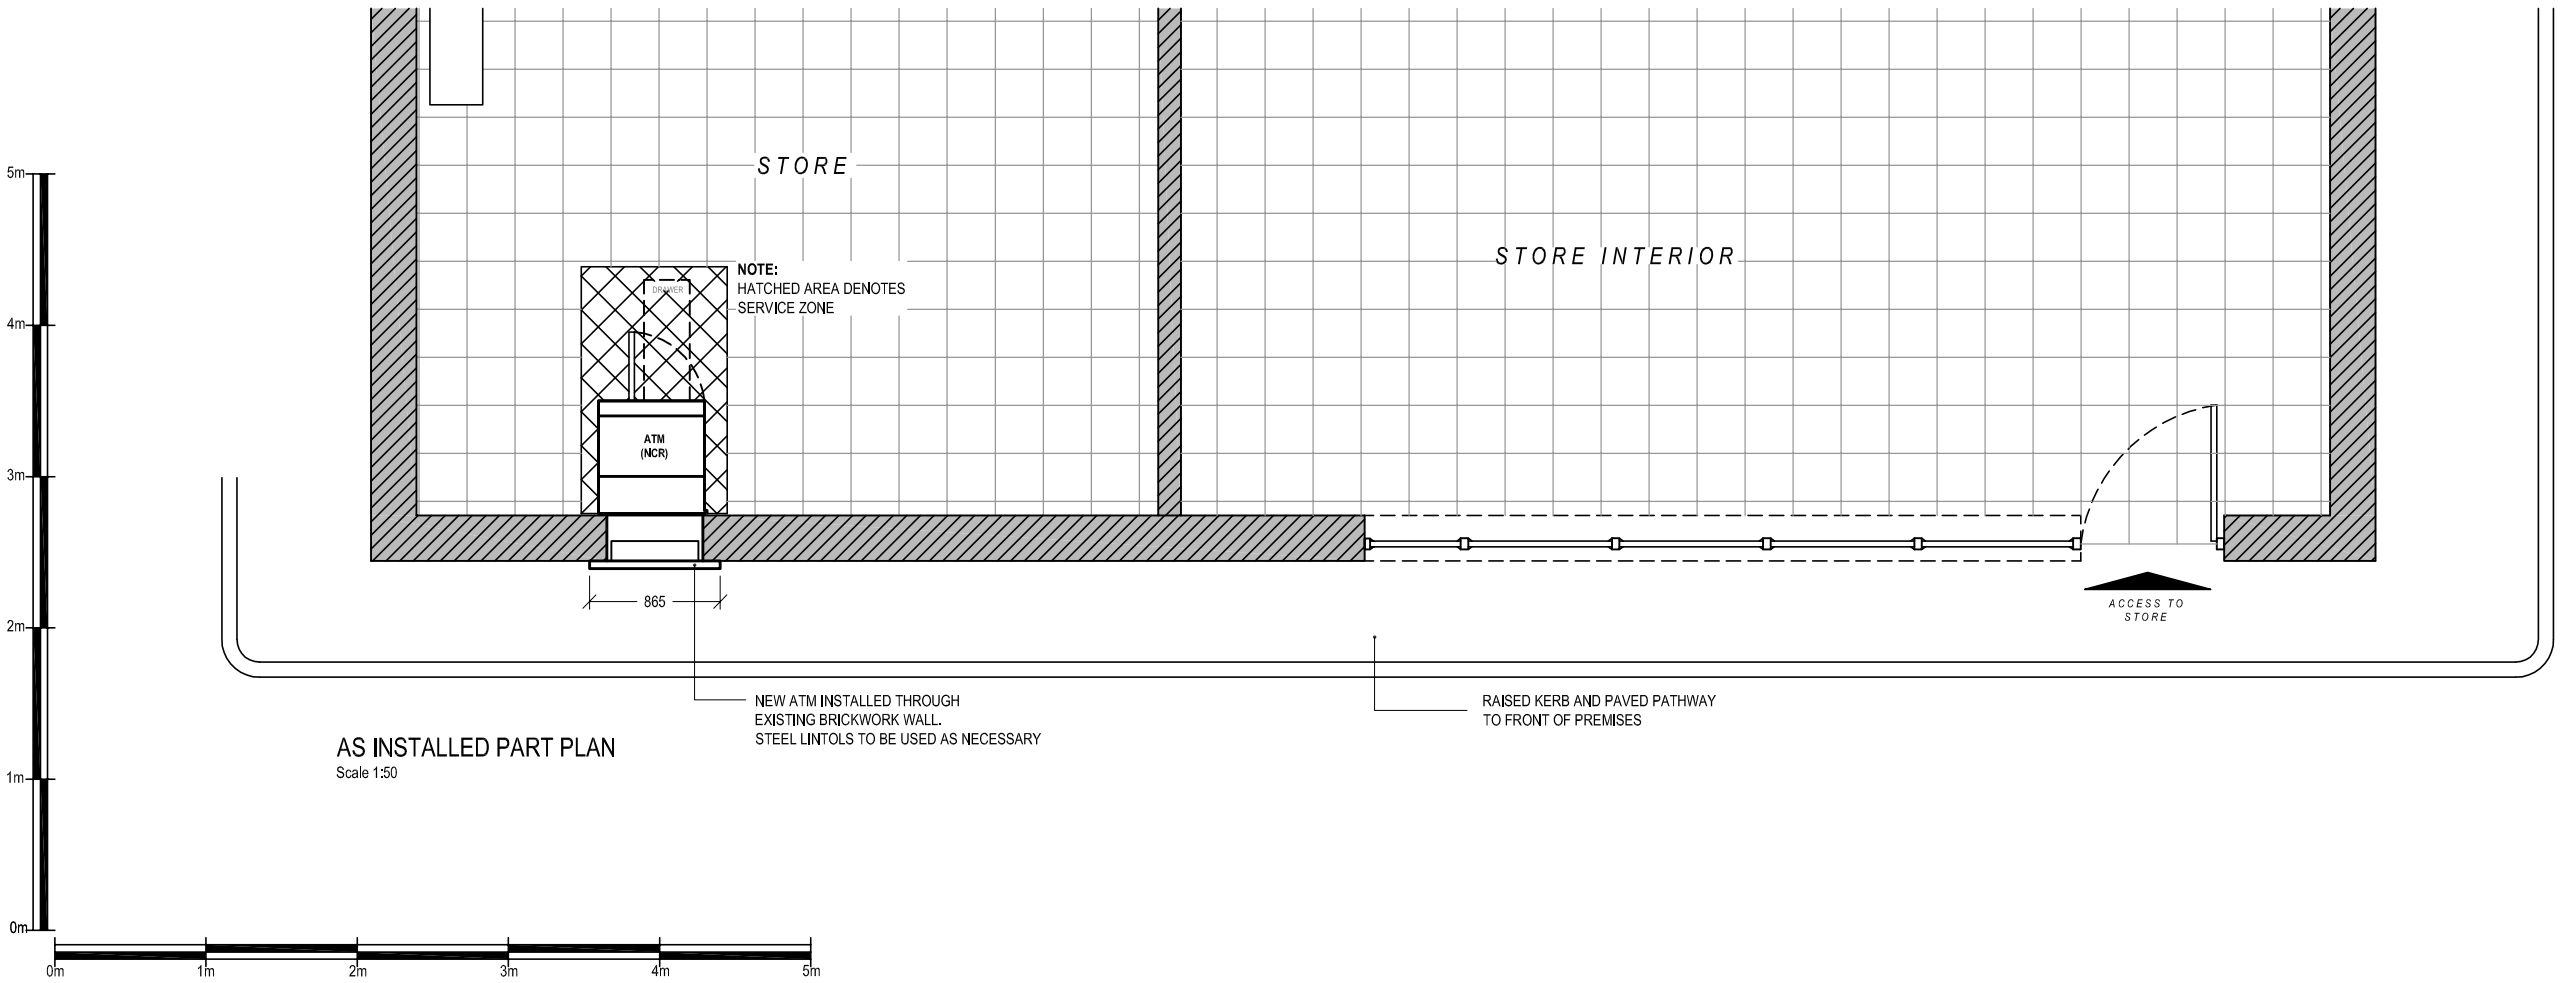

AS INSTALLED PART PLAN
Scale 1:50

NOTE MACHINE

Date:	Comments:	By:

GENERAL NOTES:

1) All dimensions in millimeters unless otherwise stated.

Site:
EURO GARAGE - CHICKENHALL

Bishopstoke Road
Eastleigh
Hampshire
SO50 6AF

Drawing Title:
As Installed Elevations and Plans

Ref:	Date:	Rev:
NM-05-2016-26-2	11-05-2016	
Scale: 1:50	**Paper:** A3	**Date Rev:**