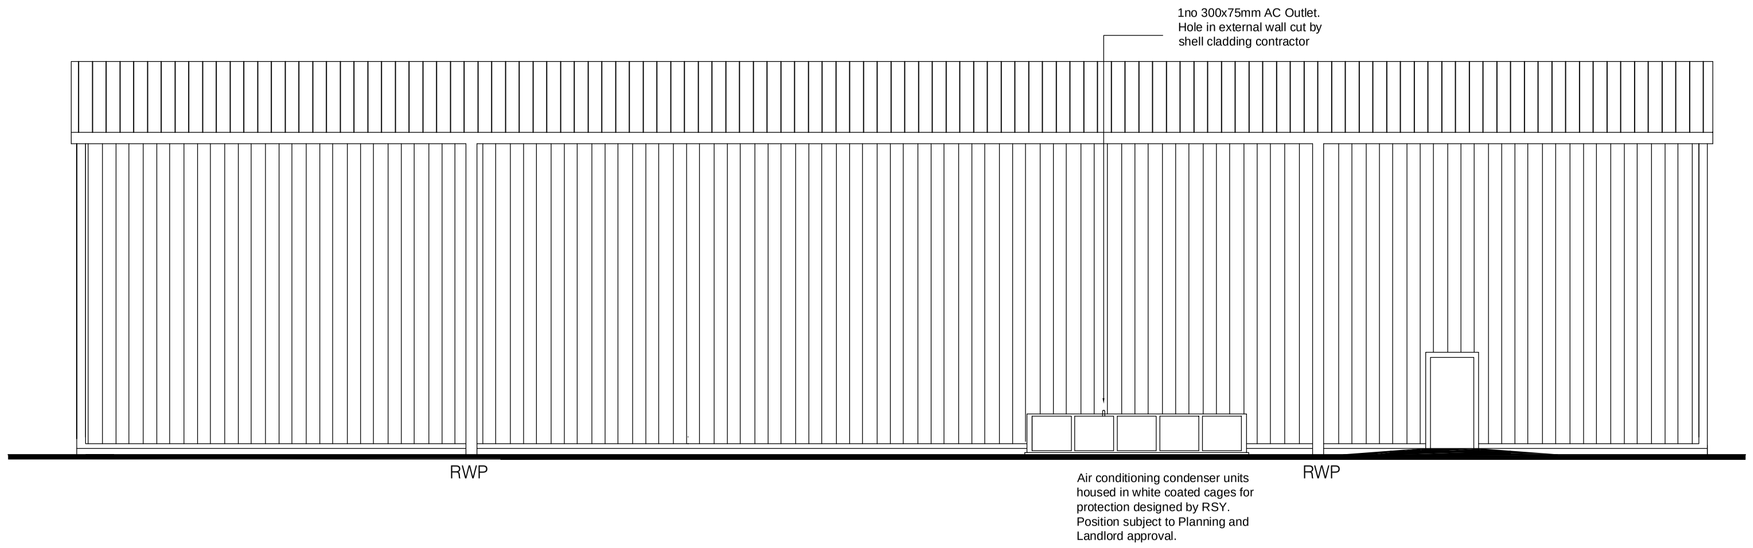

West Elevation.

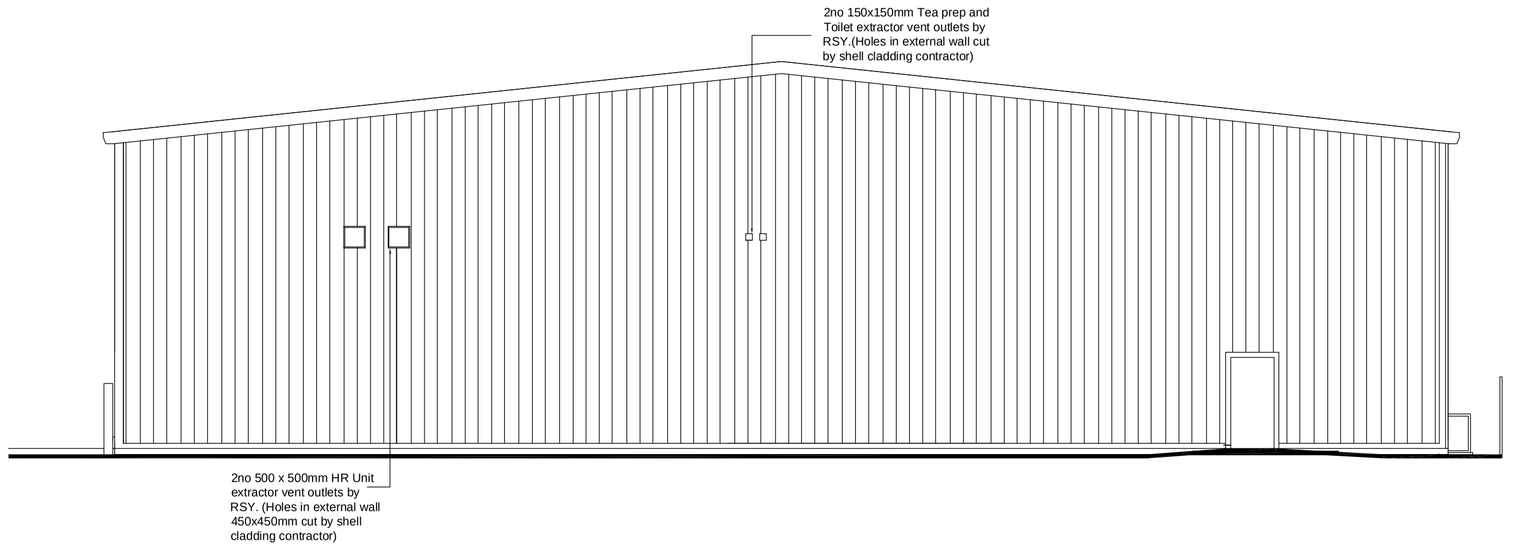

North Elevation.

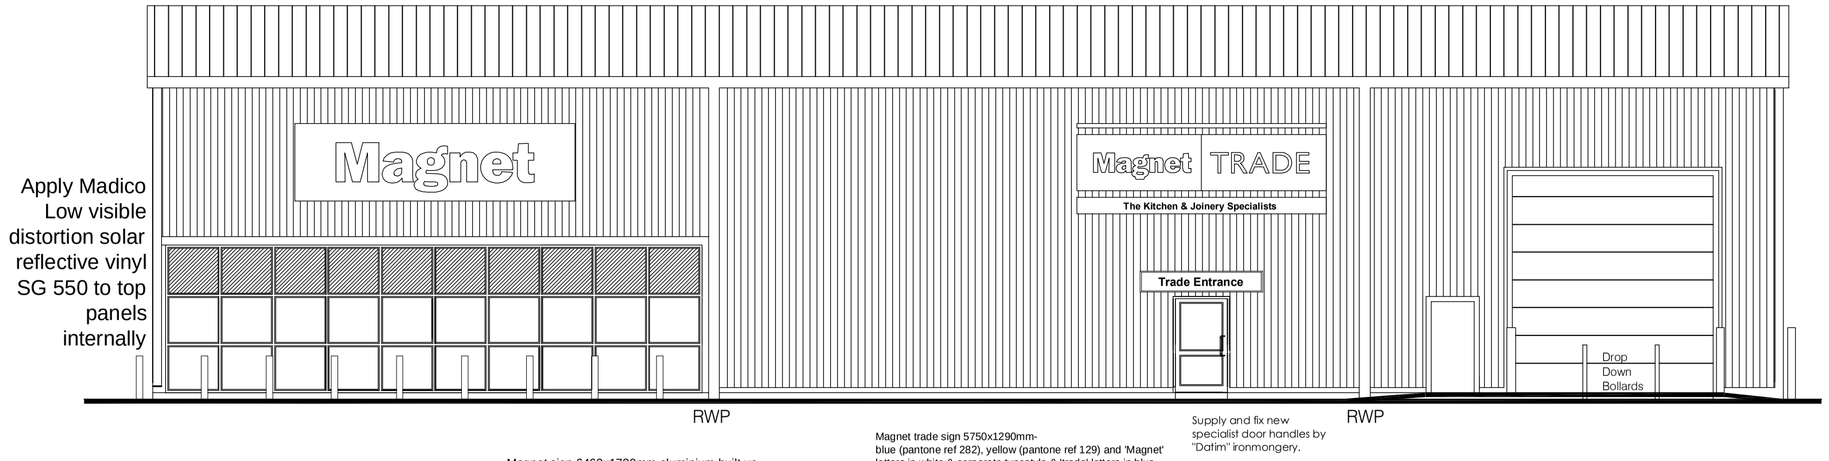

East Elevation.

Magnet sign 6460x1780mm aluminium built up 'Magnet' lettering stove enamelled grey (colour RAL 9007) mounted on to gloss green acrylic panel with stove enamelled aluminium panel secured to cladding, housing LED to provide subtle static halo illumination.

Magnet trade sign 5750x1290mm-
blue (pantone ref 282), yellow (pantone ref 129) and 'Magnet' letters in white & corporate typestyle & 'trade' letters in blue (pantone ref 282).
5750x386mm strap line" The kitchen & joinery specialists. " lettering white flush on silver acrylic background (colour BS 00A 09)
Trough lit LED illumination

Magnet sign 2000x285mm- aluminium built up "trade Entrance" lettering stove enameled grey (colour RAL 9007) individual letters mounted on to clear acrylic fascia panel and stove enameled white aluminum panel then secured to cladding over entrance. Non-illuminated.


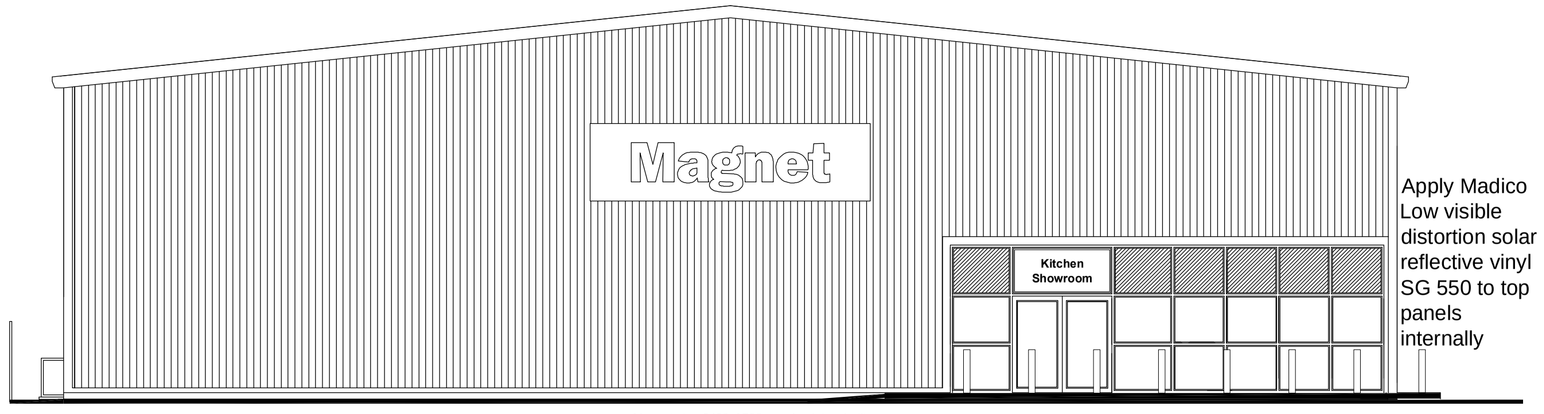

South Elevation.

Magnet sign 6460x1780mm aluminium built up 'Magnet' lettering stove enamelled grey (colour RAL 9007) mounted on to gloss green acrylic panel with stove enamelled aluminium panel secured to cladding, housing LED to provide subtle static halo illumination.

Magnet sign 2250x1025mm- aluminium built up "Kitchen Showroom" lettering stove enameled grey (colour ref. 9007) individual letters mounted on to clear acrylic fascia panel and stove enameled white aluminum panel then secured to plyboard panel over entrance. non illuminated.

Signage installation by others. Contractor to supply power to illuminated signs

Rev	Date	Description	Rev By	Chk'd
H	13-08-12	Amended to 'As built' status. Vinyl specification amended. Magnet trade signed amended and A/C units location amended.	SJB	SC
G	29-06-12	Loading bay bollards amended. A/C pipe amended.	SJB	SC
F	20-06-12	RWP positions amended to suit actual position. air condition units moved to suit RWP and Plan position tea prep and toilet vents relocated.	SJB	SC
E	11-06-12	Aerial note added. Extract positions moved to suit side rails on site.	SJB	SC
D	23-05-12	Air conditioning relocated and vents added	SJB	SM
C	10-05-12	Air conditioning units added	SJB	SM
B	09-05-12	Magnet signage altered	SJB	SM
A	04-05-12	Magnet signage altered	SJB	SM

Project Title	Magnet Fit Out Hamilton Business Park Botley Road Hedge End Southampton SO30 2JR
Client	Magnet Ltd
Status	As Built
Scale	1:50
Drawing Size	A1
Drawn By	SJB
Checked By	SM
Date	05/12

Drawing Title	Proposed Elevations
Job-Dwg No	11358-102
Rev	H

THE HARRIS PARTNERSHIP WAKEFIELD
2 St. Johns North, Wakefield, WF1 3QA
t. 01924 291 800 f. 01924 290 072

THE HARRIS PARTNERSHIP MANCHESTER
2nd Floor, Carvers Warehouse,
77 Dale Street, Manchester, M1 2HG
t. 0161 238 8555 f. 0161 244 5809

THE HARRIS PARTNERSHIP MILTON KEYNES
The Old Rectory, 79 High Street
Newport Pagnell, MK16 8AB
t. 01908 211 577 f. 01908 211 722

THE HARRIS PARTNERSHIP READING
101 London Road, Reading, RG1 5BY
t. 0118 950 7700 f. 0118 956 8642

THE HARRIS PARTNERSHIP
ARCHITECTS
www.harrispartnership.com

This drawing is copyright and may not be reproduced in whole or part without written authority. Do not scale off this drawing.

CAD file reference J:\6001-7000\Magnet\11358 Hedge End\17.0 Drawings and Issue Sheets