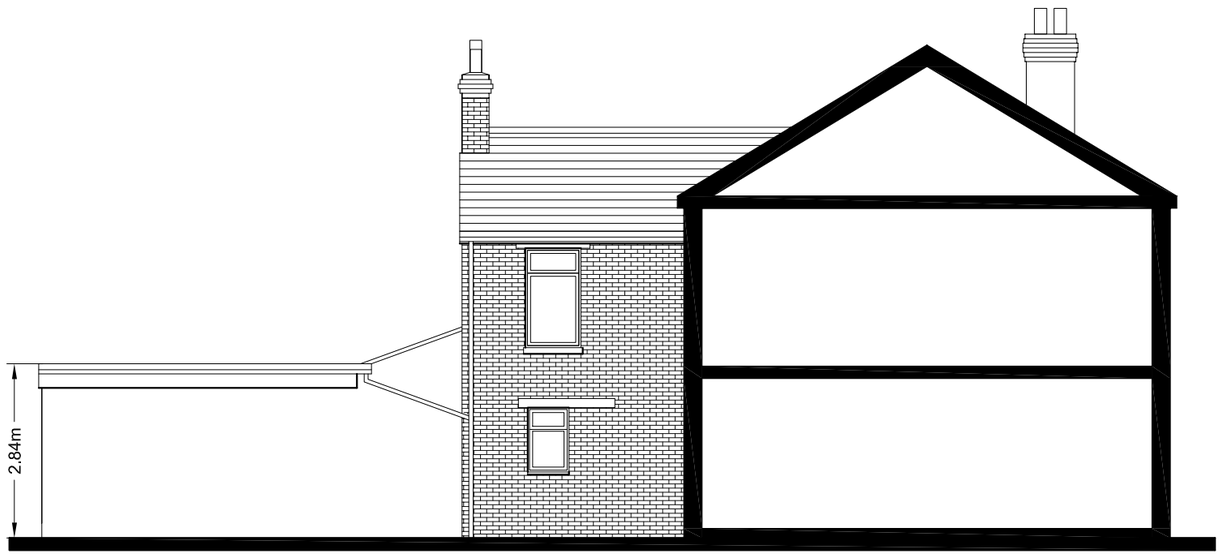

North (Side) Elevation
As Built @ 1:100



Existing West (Front) Elevation
(Not Affected) @ 1:100

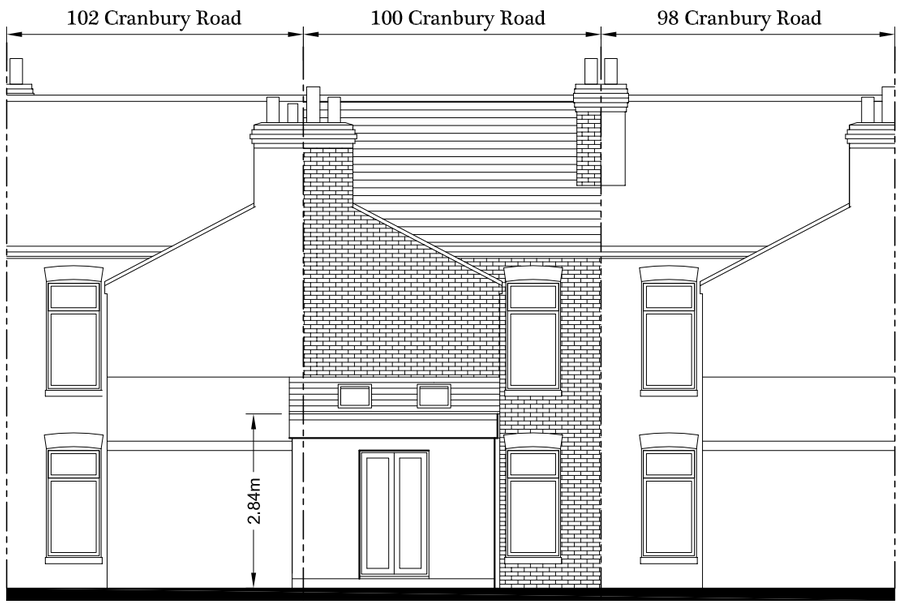

East (Rear) Elevation
As Built @ 1:100

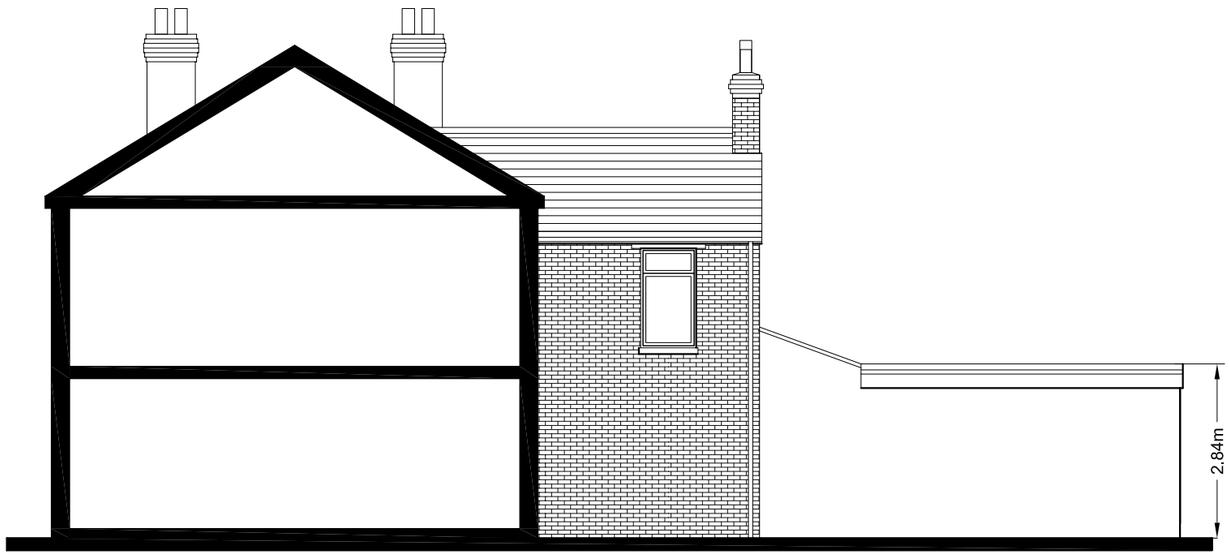

South (Side) Elevation
As Built @ 1:100

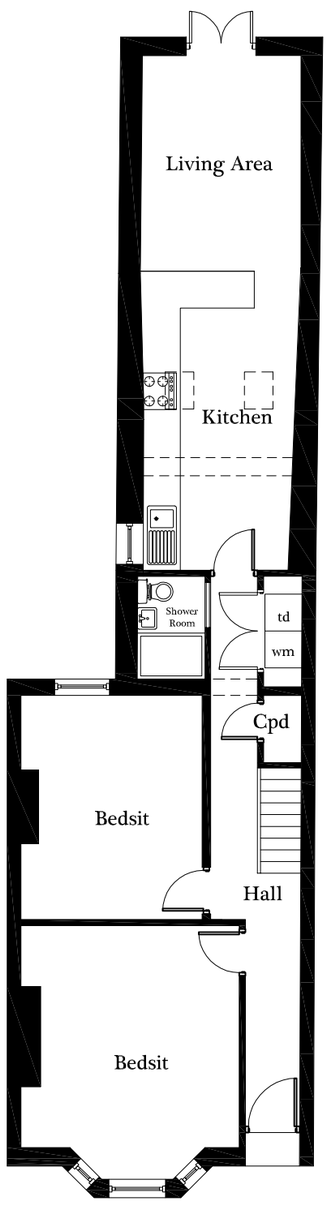

Ground Floor Plan
As Built @ 1:100

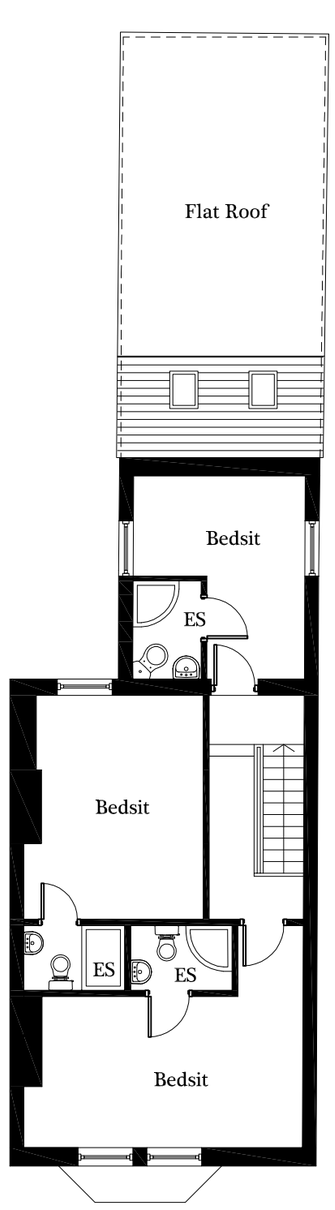

First Floor Plan
As Built @ 1:100

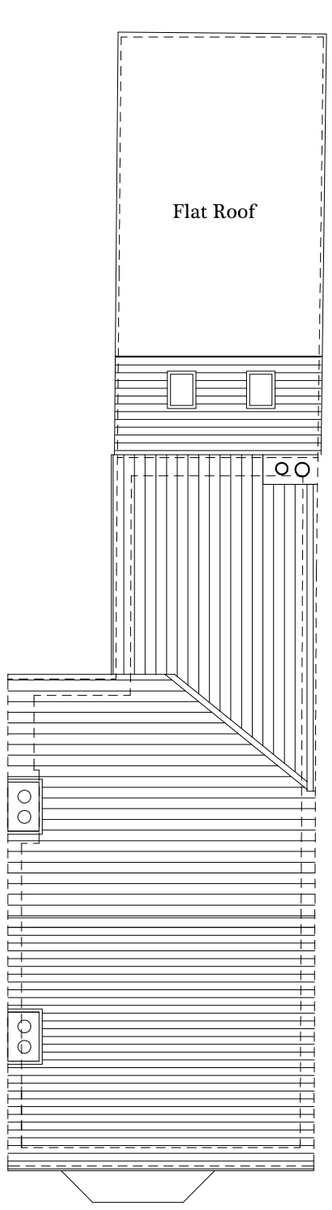

Roof Plan As Built
@ 1:100

GRAHAM ASH ARCHITECTS

CHARTERED ARCHITECTS TOWN PLANNING CONSULTANTS
Graham Ash Architects Ltd
65 Leigh Road, Eastleigh, Hampshire SO50 9DF
TELEPHONE 01794 518706 Or 07768 453105
EMAIL: Info@grahamasharchitects.com
WEBSITE: www.grahamasharchitects.com

CLIENT: **Mr S Game**

PROJECT: **100 Cranbury Road, Eastleigh, SO50 5HD**

TITLE: **As Built Plans & Elevations**

DESIGNED BY	DATE	DRWN / DTALD BY:
GA	26-7-16	JAT
SCALE 1:100	PLOTTED 26-7-16	REV.

SCALE @ 1:100 0 1 2 3 4 5m

PURPOSE OF ISSUE: ☐ information ☑ approval ☐ tender ☐ construction

DWG. NO. **16:060:03**