

Outline of previously refused scheme F/15/76213 dismissed at appeal shown in red

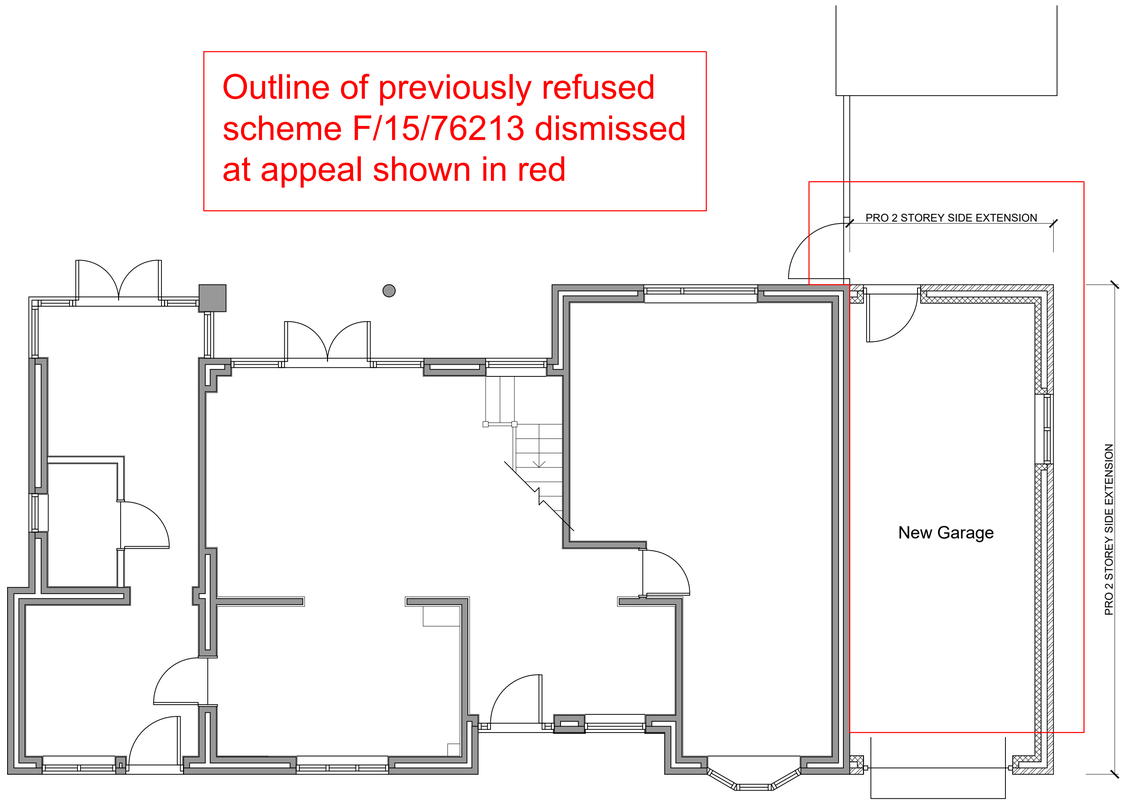


Proposed Ground Floor Plan (1:50)

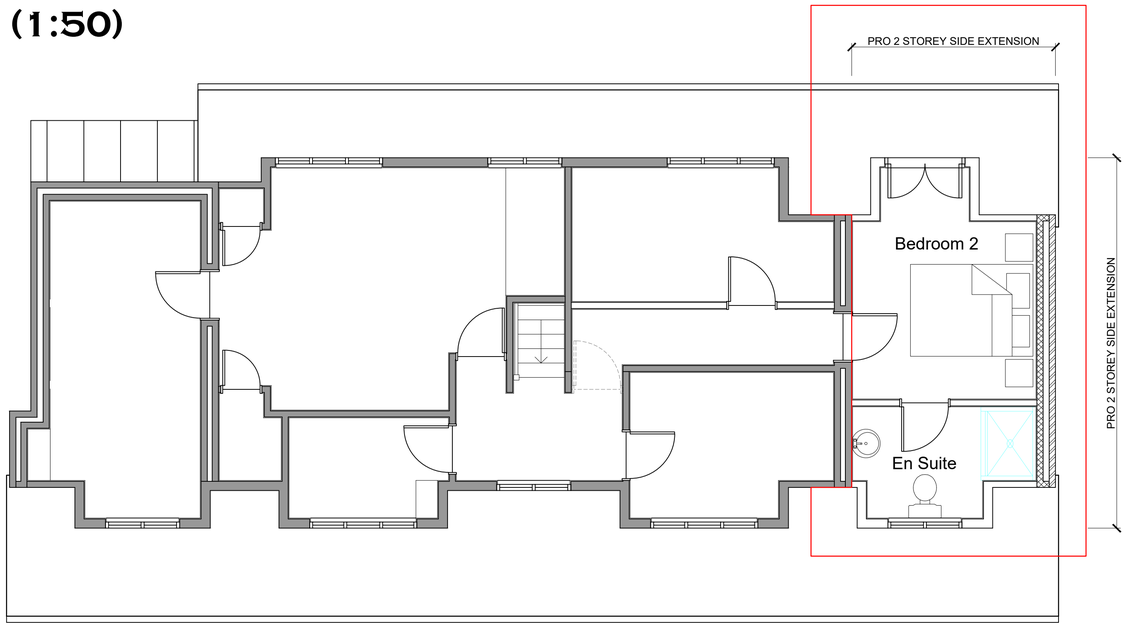


Proposed First Floor Plan (1:50)




Proposed East Elevation (1:100)

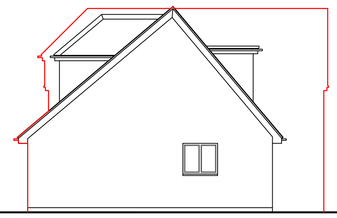

Proposed North Elevation (1:100)

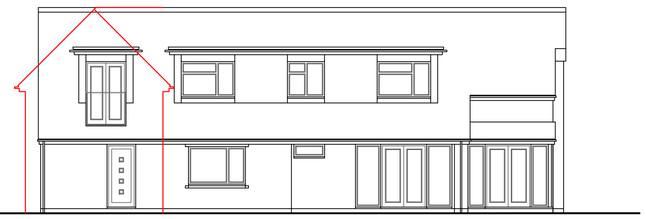

Proposed West Elevation (1:100)

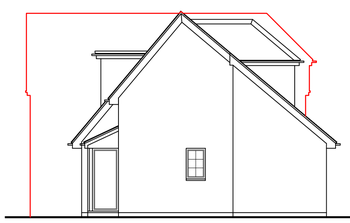

Proposed South Elevation (1:100)

Notes

THIS DRAWING IS THE COPYRIGHT OF VIVID DESIGN STUDIO LTD AND MUST NOT BE COPIED, ALTERED OR REPRODUCED IN ANY WAY NEITHER PASSED TO A THIRD PARTY WITHOUT THEIR WRITTEN PERMISSION.

DIMENSIONS TO BE CHECKED ON SITE BEFORE COMMENCING WORK AND ANY DISCREPANCIES SHALL BE REPORTED TO THE DESIGNER. FIGURED DIMENSIONS MUST BE TAKEN IN PREFERENCE TO SCALED DIMENSIONS.

Rev:-	Description:-	Date:-	Chkd by:-

VIVID design studio

The Barn, Calcot Mount Business Park, Calcot Lane,
Curdridge, Southampton, Hampshire, SO32 2BN
Tel: 01489 786670
Email: info@vividdesignstudio.co.uk
Website: www.vividdesignstudio.co.uk

Project:-

159 Satchell Lane
Hamble
Southampton
Hampshire

Title:-

Appeal Scheme Comparison

Client:-

Mr Kevan Roberts

Scale:-

1:50, 1:100 (@A1)

Drawn By:- PJD

Checked By:-

Date:- 01/02/16

Date:-

Job.No:- 150005

Drg.No:- 15

Rev:-