Application for a non-material amendment following a grant of planning permission.

Town and Country Planning Act 1990

Publication of applications on planning authority websites

Please note that the information provided on this application form and in supporting documents may be published on the Authority's website. If you require any further clarification, please contact the Authority's planning department.

Please complete using block capitals and black ink.
It is important that you read the accompanying guidance notes as incorrect completion will delay the processing of your application.

1. Applicant Name and Address

Title:	MR	First name:	JEREMY		
Last name:	DAVIS				
Company (optional):					
Unit:		House number:	17	House suffix:	
House name:					
Address 1:	FOORD ROAD				
Address 2:	HEDGE END				
Address 3:					
Town:	SOUTHAMPTON				
County:	HAMPSHIRE				
Country:					
Postcode:	SO30 0DB				

2. Agent Name and Address

Title:		First name:			
Last name:					
Company (optional):					
Unit:		House number:		House suffix:	
House name:					
Address 1:					
Address 2:					
Address 3:					
Town:					
County:					
Country:					
Postcode:					

7. Description Of Your Proposal

Please provide a description of the approved development as shown on the decision letter, including application reference number and date of decision in the sections below. Please also provide the original application type:

FIRST FLOOR SIDE EXTENSION + PITCHED ROOF TO EXISTING SINGLE STOREY FRONT PROJECTION
F/13/73583

Reference number: F/13/73583

Date of decision (DD/MM/YYYY): 13 JANUARY 2014.

What was the original application type?:
(e.g. 'Full', 'Householder and Listed Building', 'Outline') ? FULL

For the purpose of calculating fees, which of the following best describes the original application type?

Householder development: development to an existing dwelling-house or development within its curtilage ☑

Other: anything not covered by the above category ☐

8. Non-Material Amendment(s) Sought

Please describe the non-material amendment(s) you are seeking to make:

TO AMEND THE ROOF DESIGN OF PROPOSED EXTENSION AS PER INCLUDED SKETCH. IT IMPROVES THE LOOK OF THE EXTENSION AND NEGATES THE NEED FOR A LONG AND POTENTIALLY PROBLEMATIC GULLY. SKETCH ATTACHED

Are you intending to substitute amended plans or drawings? ☐ Yes ☑ No

If Yes, please complete the following:


Old plan/drawing number(s):

New plan/drawing number(s):

Please state why you wish to make this amendment:

FOR VISUAL IMPROVEMENT AND REMOVAL OF PROBLEMATIC LONG GULLY DUE TO MATURE TREES

DRAWING No. 2.

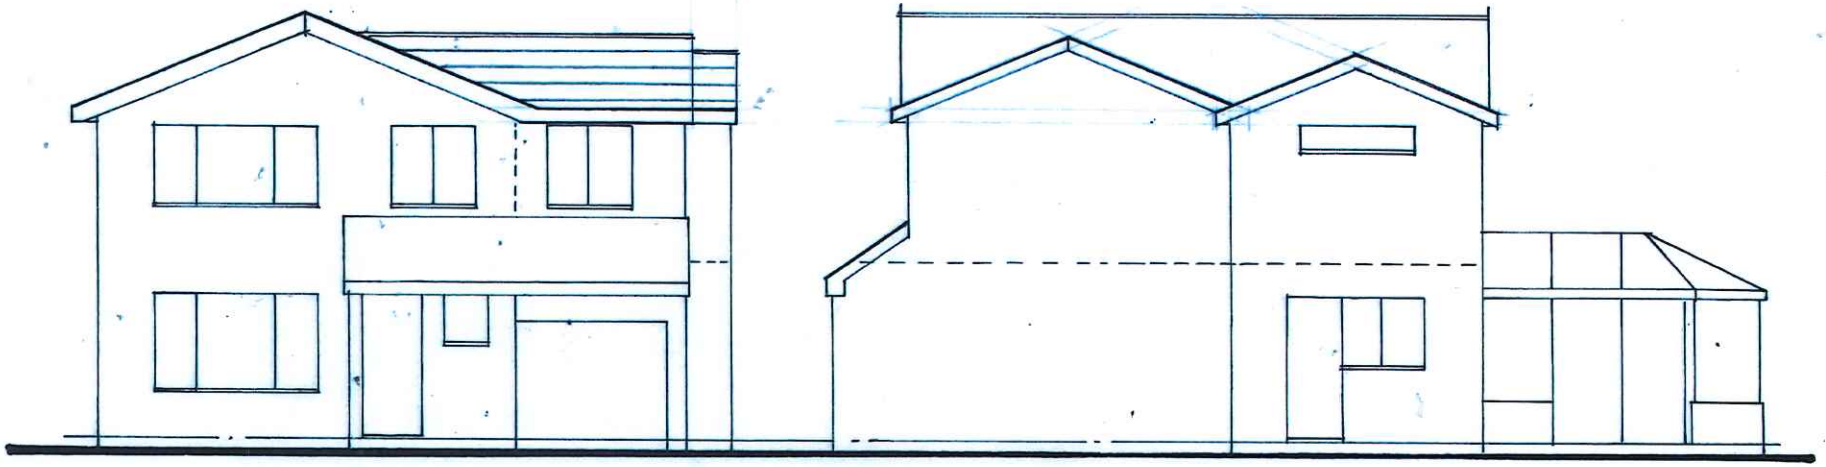

FRONT

SIDE



REAR

17 FOORD ROAD HEDGE END