PLEASE NOTE:-
Figured dimensions to take preference to scaled dimensions. The contractor is responsible for checking all figured dimensions against actual dimensions on site prior to starting any work.

This drawing is the Copyright of the Architect and must not be reproduced without the Architects permission.

CONSTRUCTION STANDARDS
All work shown on this drawing must be carried out to conform with the relevant British Standards of Codes of Practice or any National or International standards applicable, then the higher standard shall apply.



Existing Front Elevation
1:100



Existing Rear Elevation
1:100



Existing Section
1:100

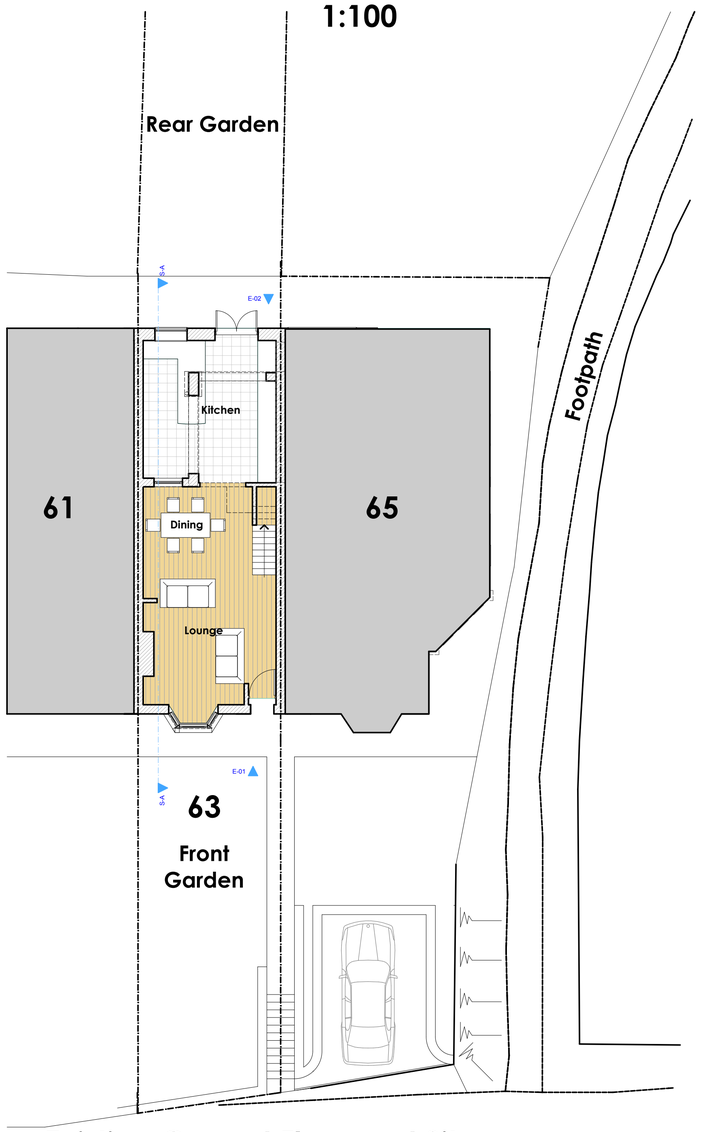

Existing Ground Floor and Site
Plan 1:100

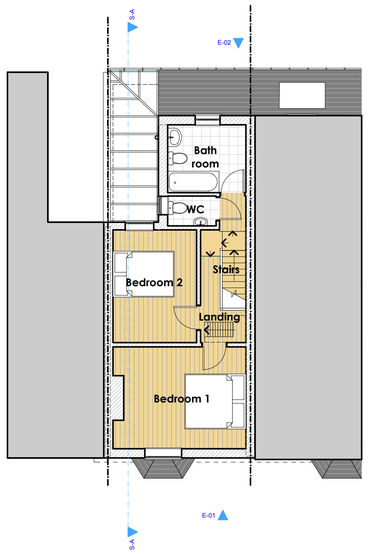

Existing First Floor
Plan 1:100

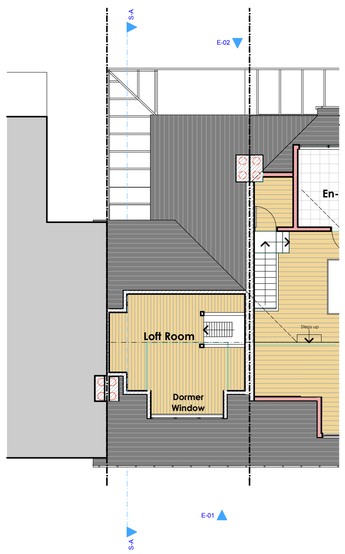

Existing Loft Floor
Plan 1:100

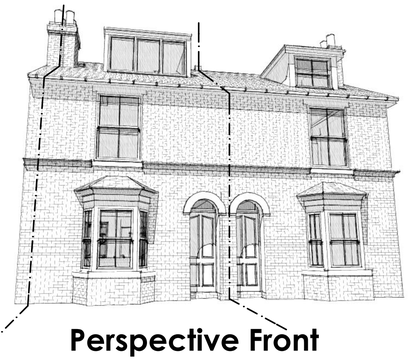

Perspective Front
View

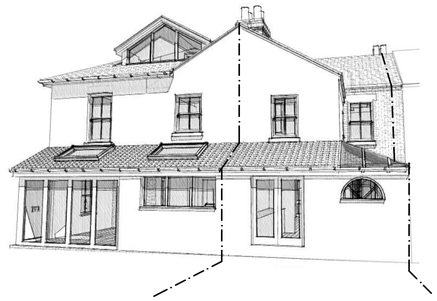

Perspective Rear
View

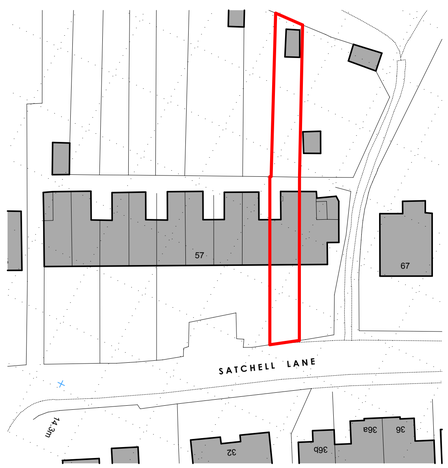

Block Plan 1:500

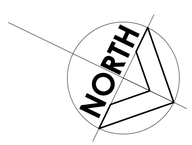

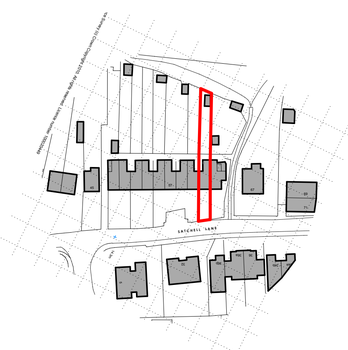

Location Plan 1:1250

Revision A. Generally up dated 17/04/2013

MTA ARCHITECTS LTD
The Boat House 1 Admiralty Cottages
Fort Road Gosport Hampshire PO12 2AP
Tel:- 023 9258 8699 Fax:- 023 925 20322
E-mail:- mtagos@aol.com
Web Site:- www.mtaarachitects.co.uk

Project
Proposed Alteration and Extensions to 63 Satchell Lane Hamble Southampton SO31 4HZ For Mrs J Walker

Drawing Name
Existing Plans, Section, Elevations & Perspective Views

Drawing Status
Record Drawing

Drawn by **JMT** Date **March 2013**

Drawing Scale
As Shown @ A1 size

Drawing Number
3272/S01A

Also at 52 Fore Street Brixham South Devon TQ5 8DZ
Tel:- 01803 851010