


1:1250




RED LINE IS TREE PROTECTION

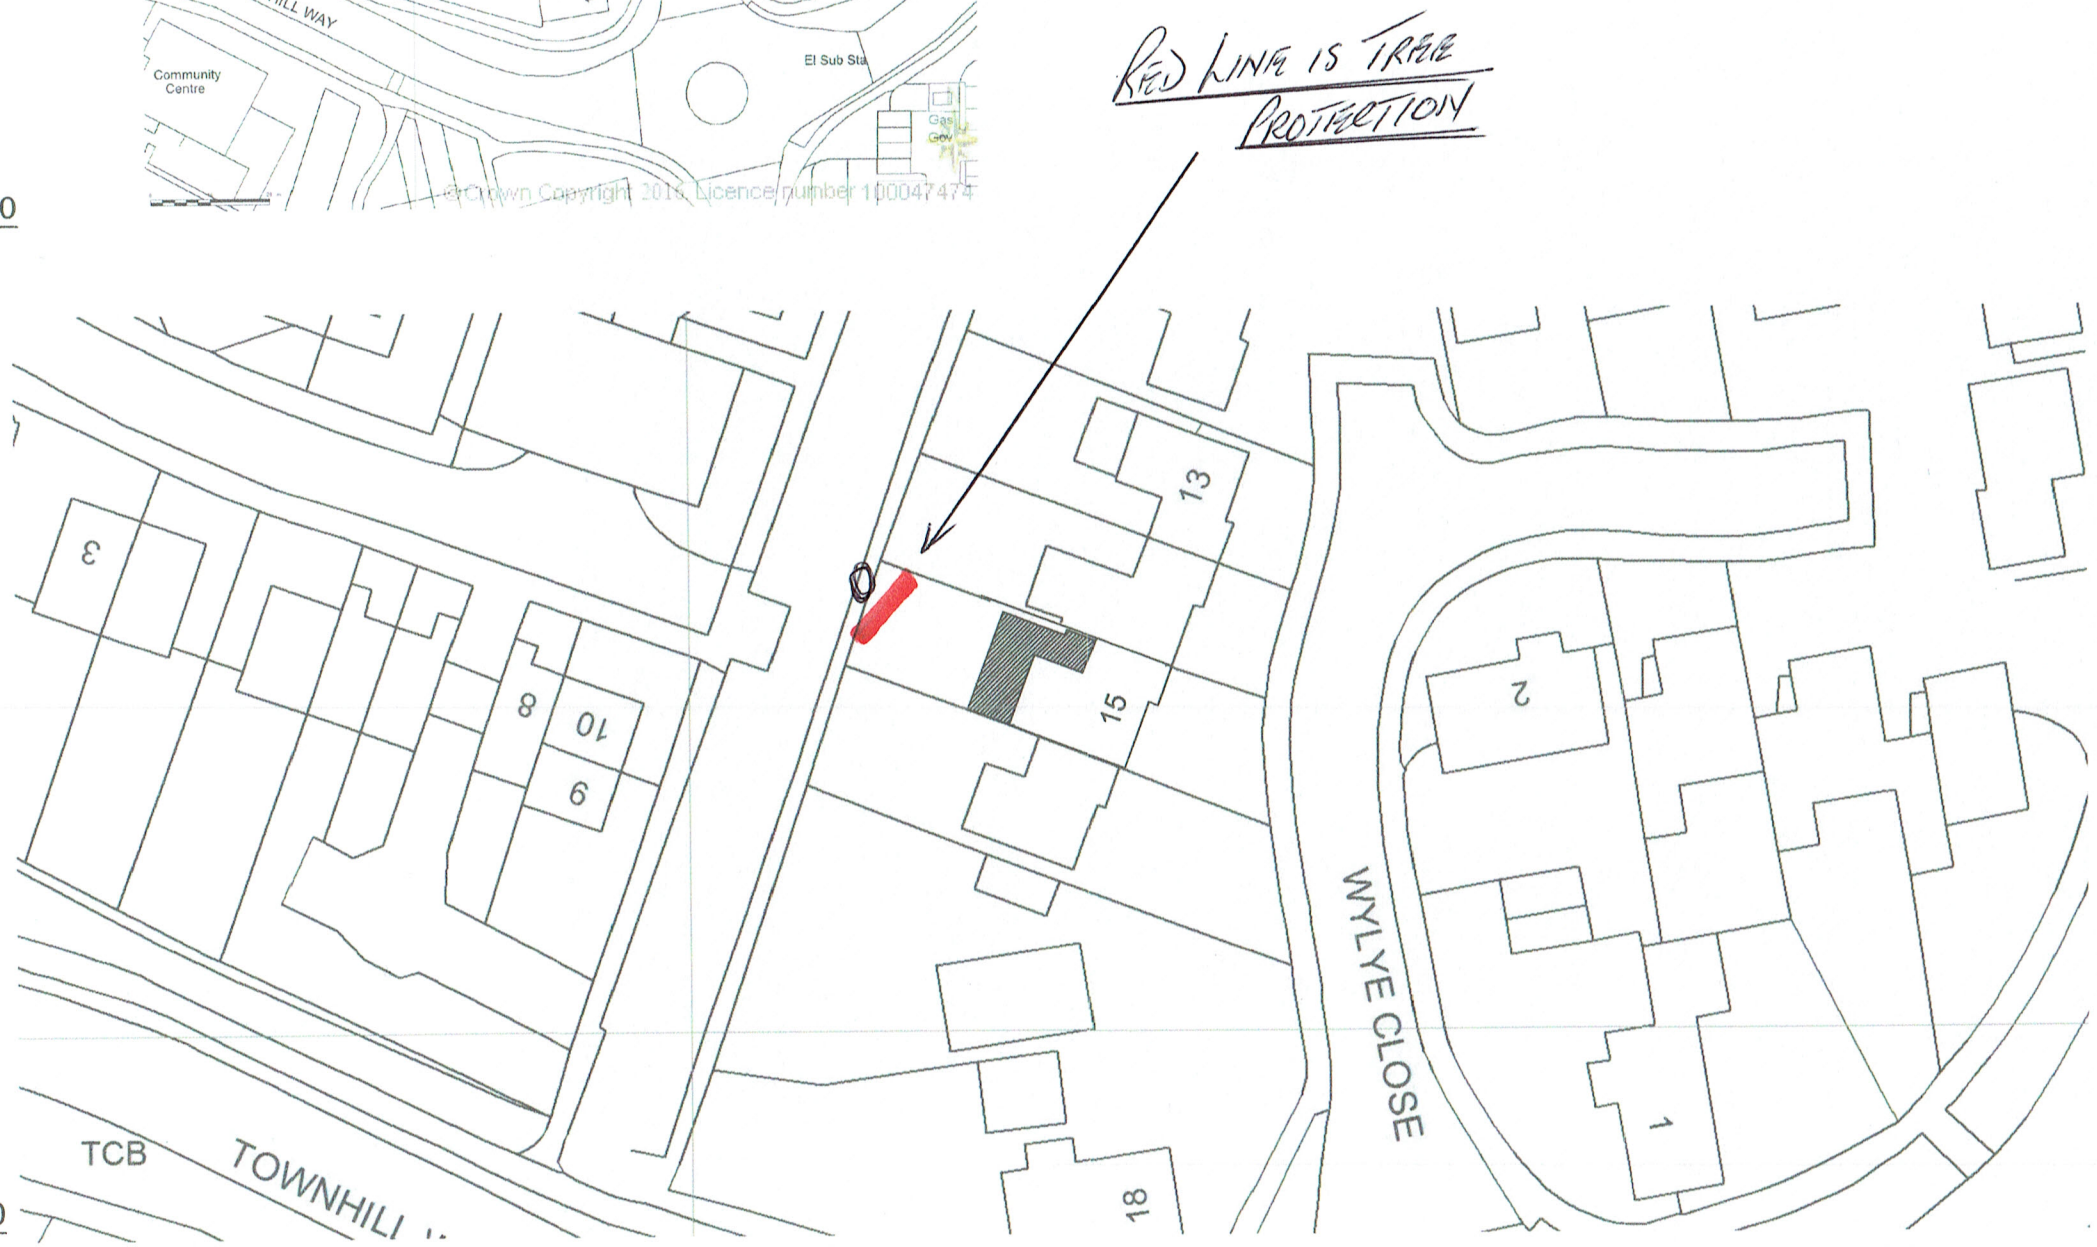


1:500

ROSENTHAL
ARCHITECTURAL SERVICES
07713 483394
info@rosenthalarchitectural.co.uk

## NOTES

01 All new and existing building work dimensions are critical to the construction process.

02 All drawings are preliminary unless stated differently. Preliminary drawings and are not to be built or manufactured from.

03 This drawing is subject to copyright of Rosenthal Architectural SERVICES reproduction only with written authority.

04 Drawing dimensions and scales to be checked prior to commencement of work.

05 All structural work where mentioned on this drawing is subject to a qualified structural and civil engineer calculations before building work commences.

06 These plans may be subject to "Planning & Building Regulation Approval" or any other statute in law before the commencement of building works.

07 All materials to match existing unless otherwise stated.

M 1:1250 0 12.5 25 37.5 50 62.5
M 1:500 0 5 10 15 200 25

Location Plan

**Mr & Mrs Conduct**
15 Wyle Close,
West End,
Southampton,
SO18 3LF

**DRAFT 2A - 21.10.16**

| | |
|---|---|
| CLIENT NO: | DRAWN: DS |
| JOB NO: | DATE: 05.10.16 |
| SCALE @ A3: shown | PG NO: 07 |