


Plan A



Scale 1:500

In plan above 2.0m from the edge of highway, with a clear line of site of 43.0m is shown in red


Plan B

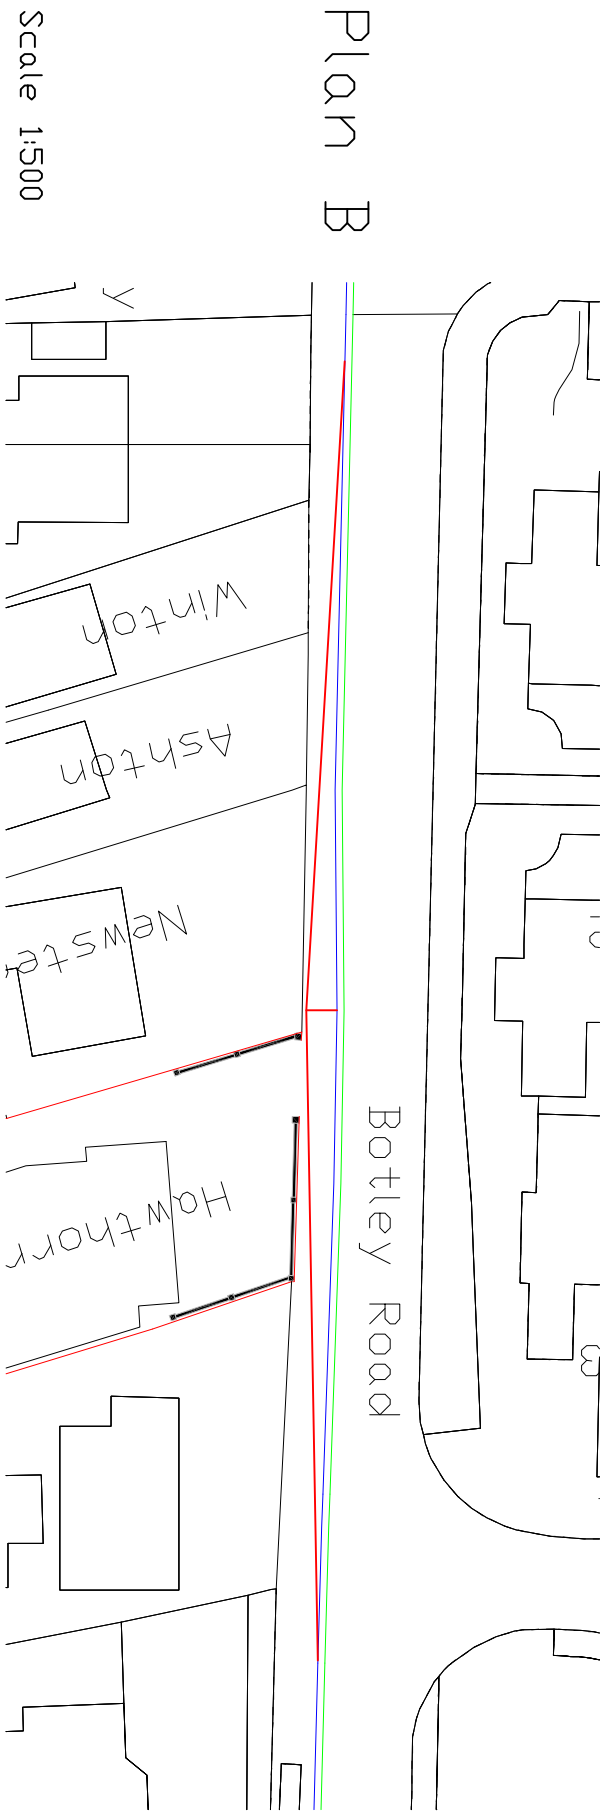

Scale 1:500

In plan above 2.0m from the edge of highway, with a clear line of site of 43.0m is shown in red


Plan C

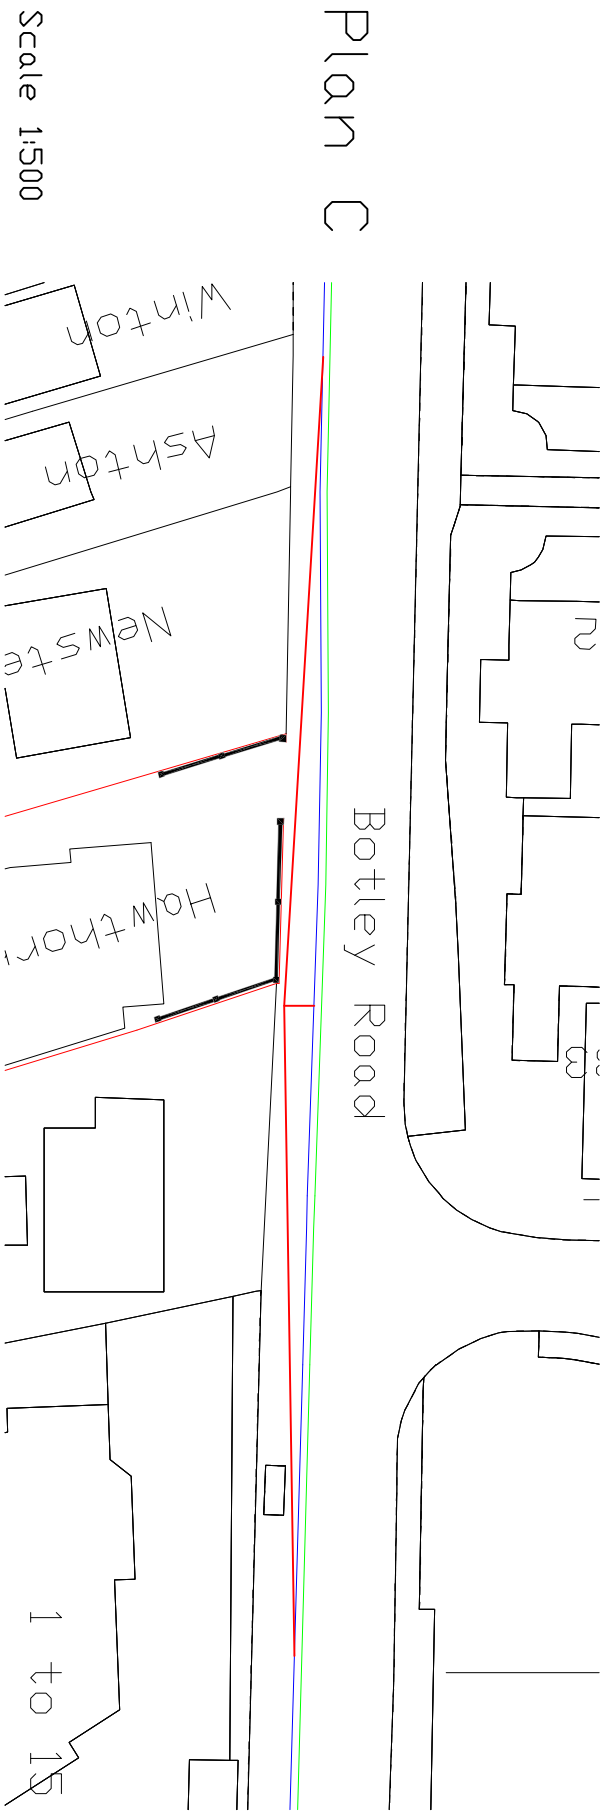

Scale 1:500

In plan above 2.0m from the edge of highway, with a clear line of site of 43.0m is shown in red

Address	Hawthorne House Botley Rd SD30 3HA
Description	Amended Boundary
Client	P Bunting
Scale	1:50 & 1:500
Paper size	A3
Plan Ref	HHBR – Rev3 – Boundary – JT – 06

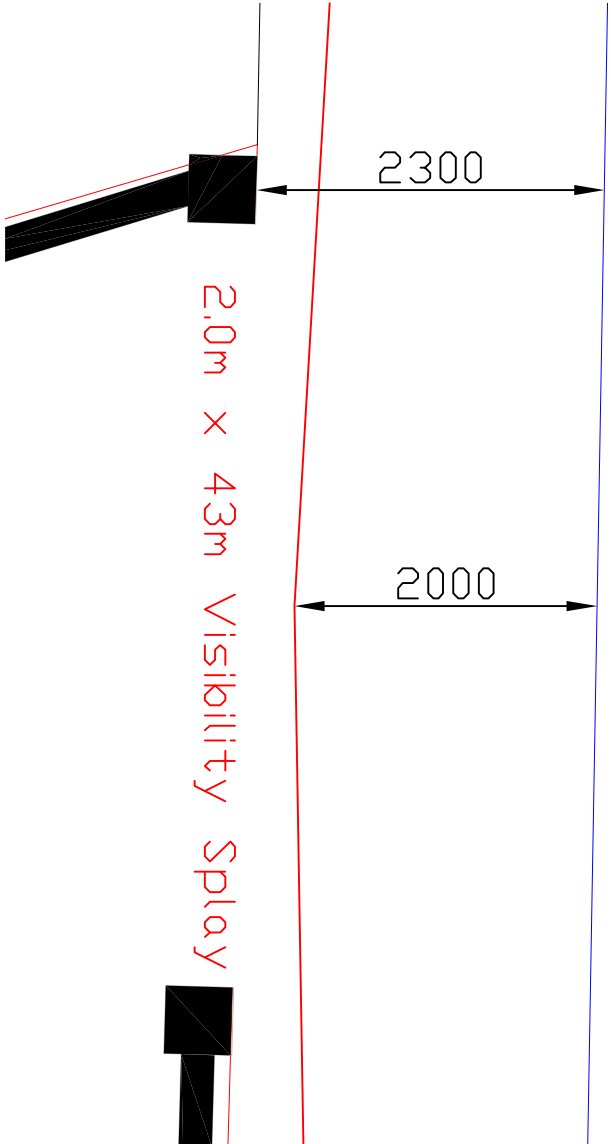

Scale 1:50

In plan above Green line is the original OS map position of pavement. The true position of pavement is shown by Blue line with a distance of 2.3m from edge of pavement to wall.

2.0m into site from the edge of highway, with a clear line of site from here of 43.0m has then been shown in red.

Plans A,B & C to left shows 2m x 4.3m visibility splays from Hawthorne House and neighbours properties.