





South (Front) Elevation - As Proposed

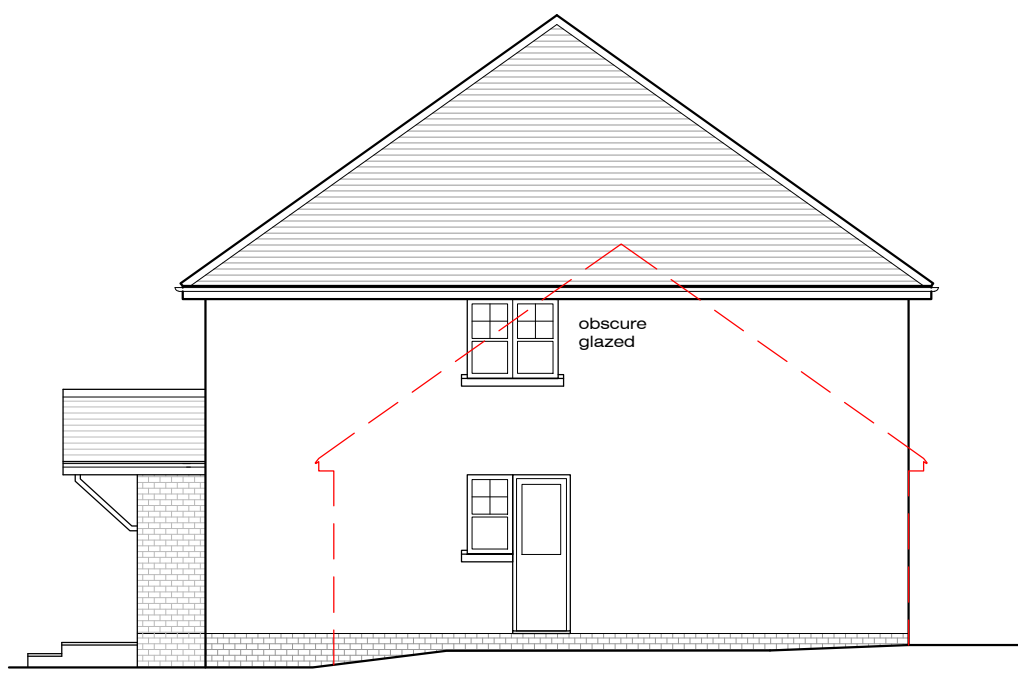


East (Side) Elevation - As Proposed



North (Rear) Elevation - As Proposed

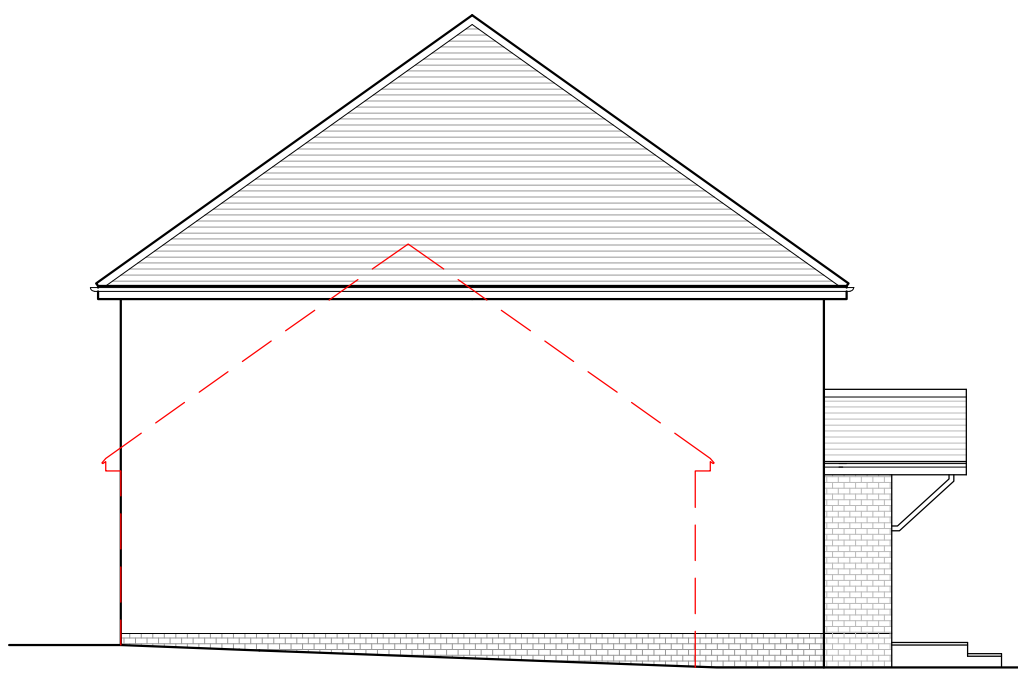


West (Side) Elevation - As Proposed

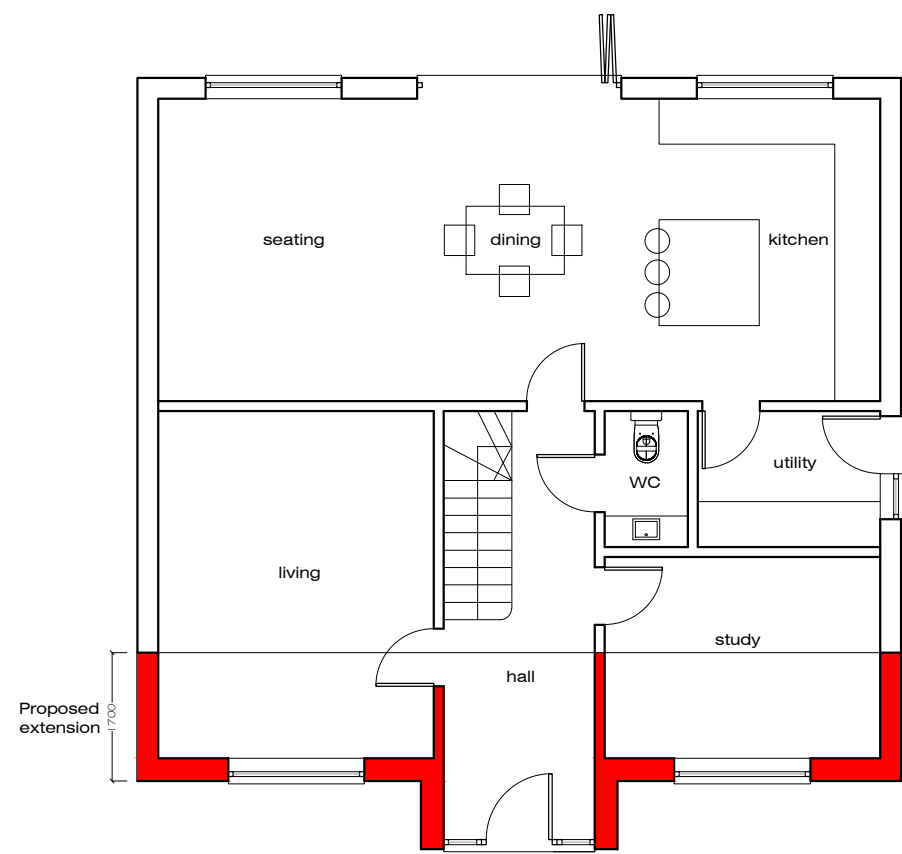


Ground Floor Plan - As Proposed

Areas hi-lighted in red indicate extended areas of existing building

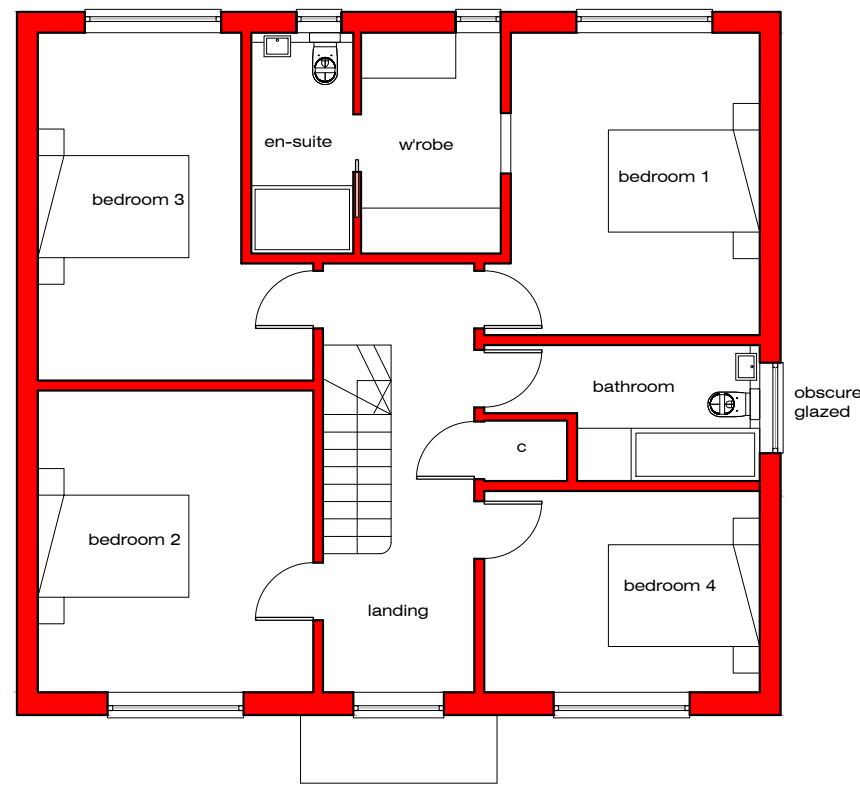

First Floor Plan - As Proposed

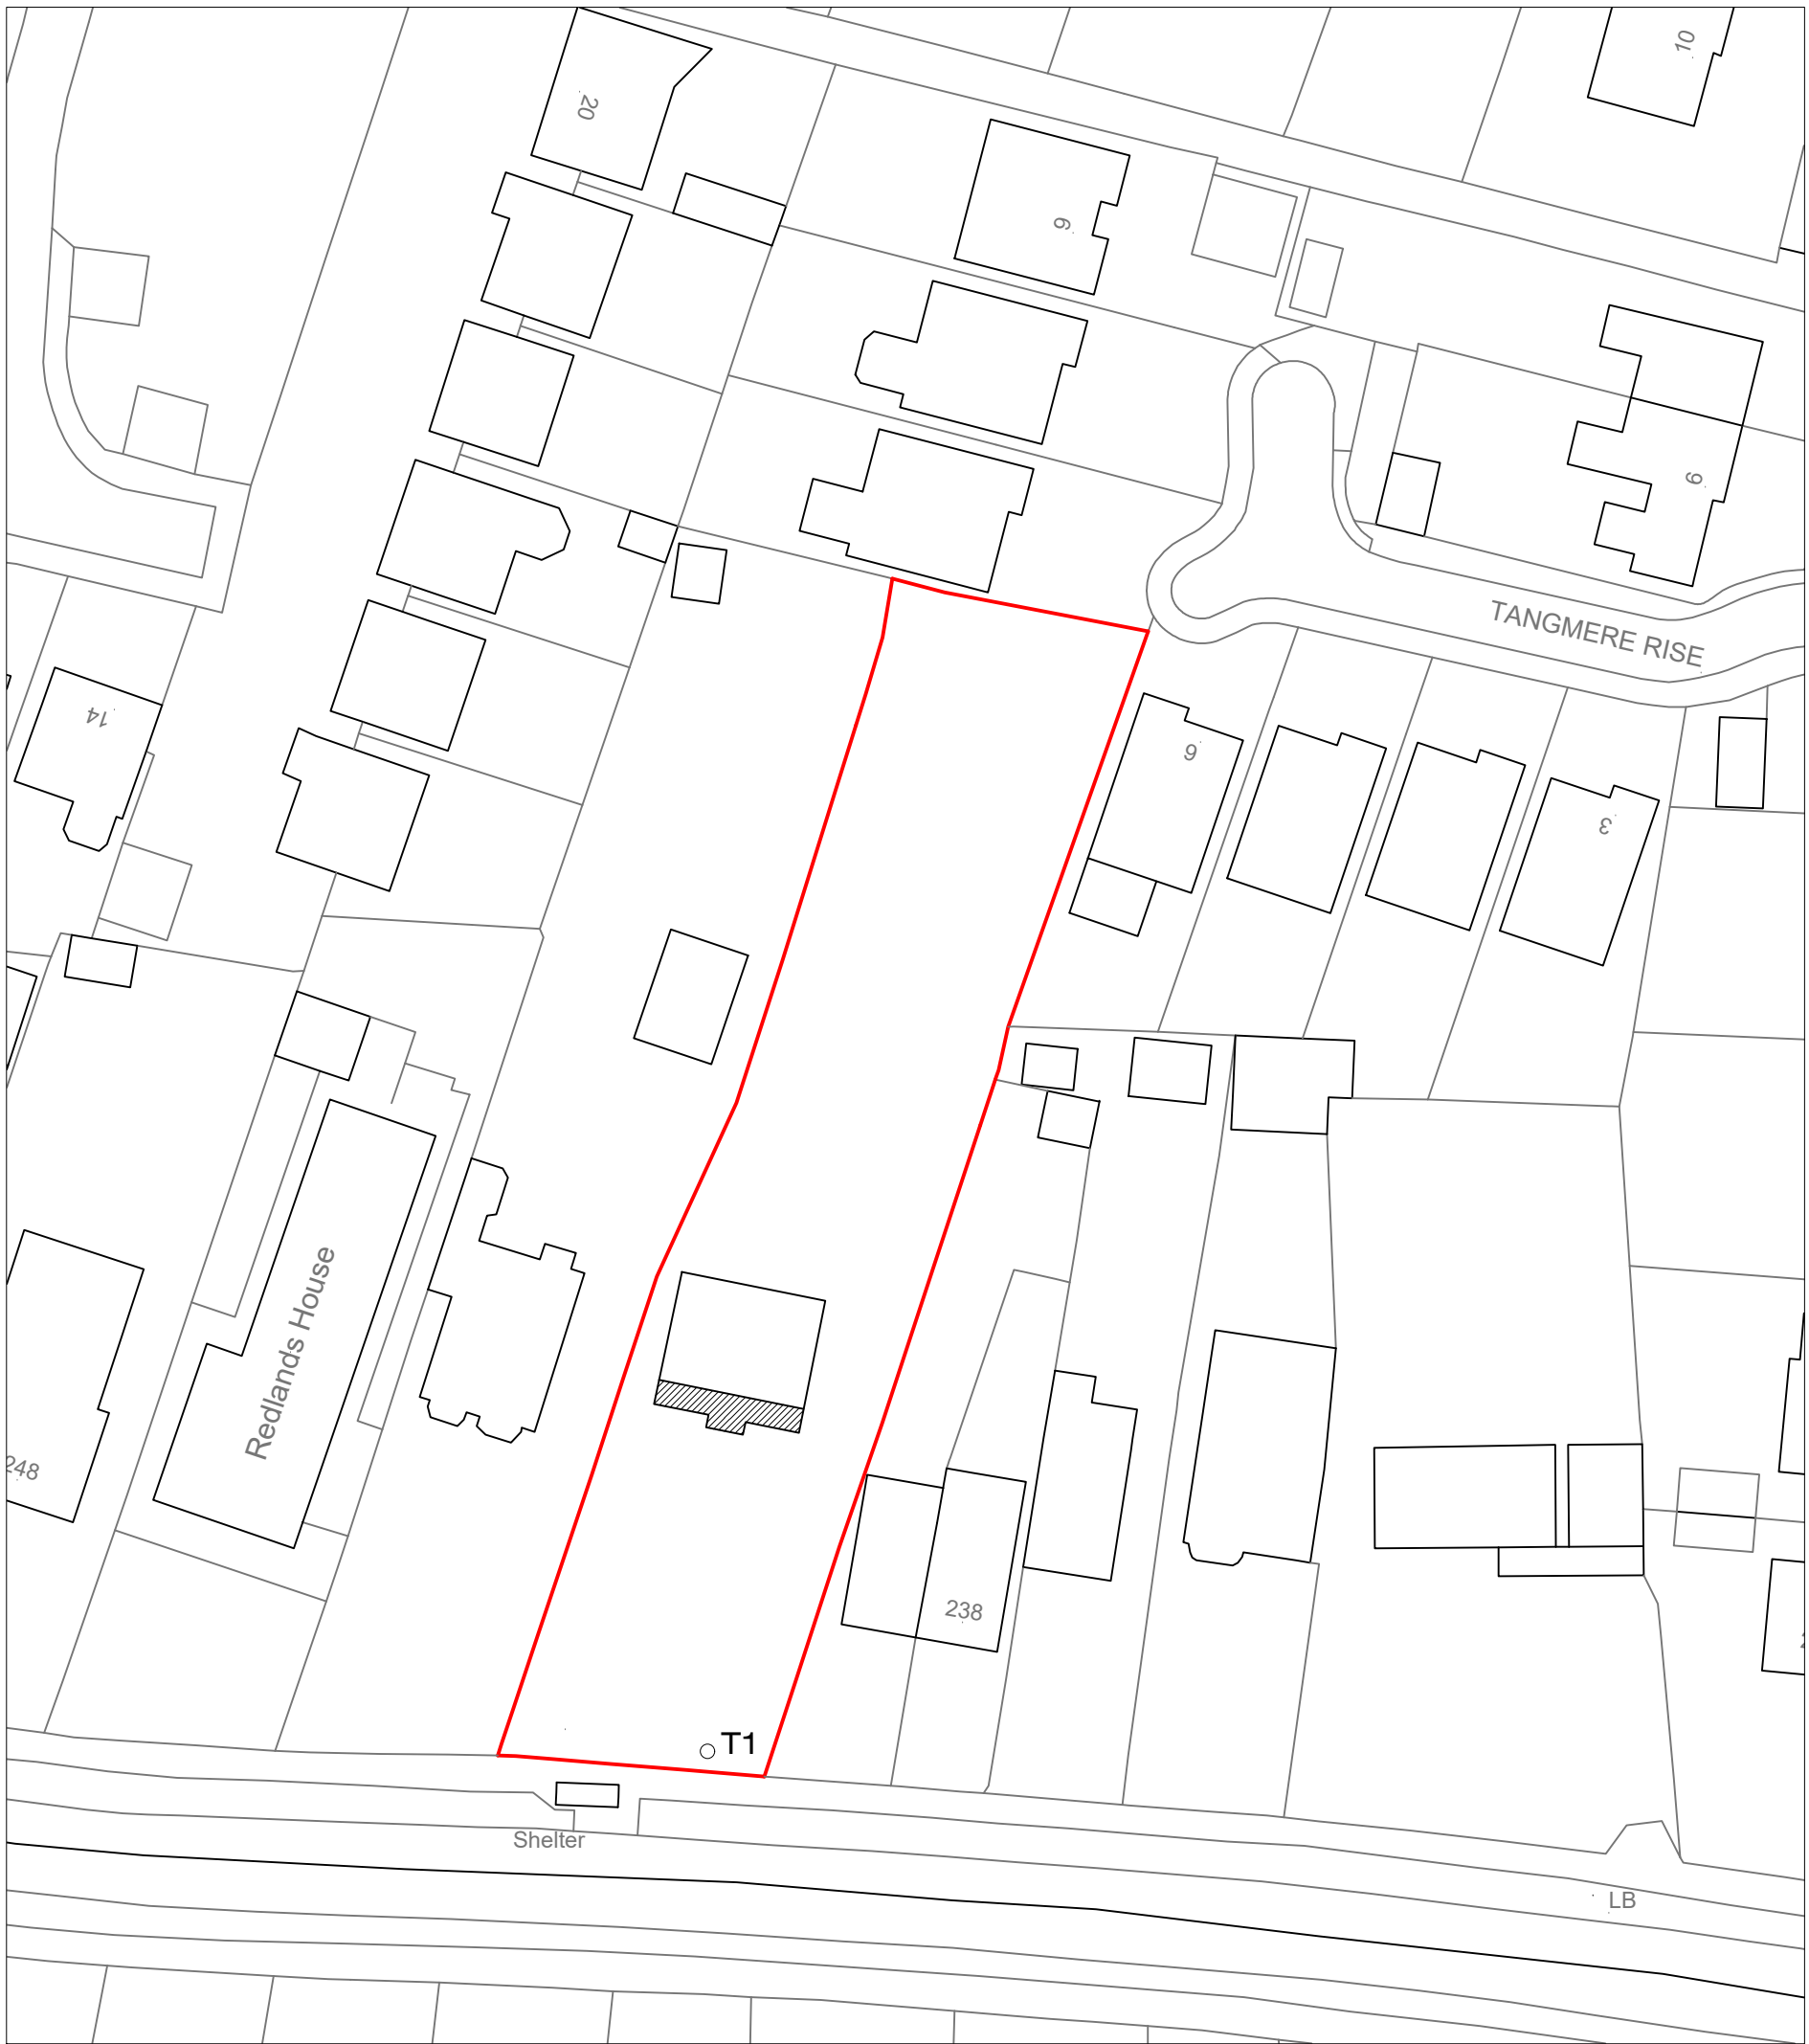

Block Plan - As Proposed 1:500

A	Red lines added to show outline of existing building on elevations and solid red areas added to floor plans to show extended areas - Re-issued for Planning Application	NJ	19-11-22
-	Issued for Planning Application	NJ	26-07-22
Rev.		By	Date

Wildern Architecture Ltd
The Hawthorns, 105 Dibles Road,
Warsash, Southampton, SO31 9JL
07920 260758

Project
242 Leigh Road, Chandler's
Ford, Eastleigh, SO53 3AW

Client
Mr K Turner

Title Plans and Elevations - As Proposed			
Date	May 22	Drawn By	NJ
Job No.	Drawing No.	Scale	Revision
W22-004	101	1:100 /500@A1	A