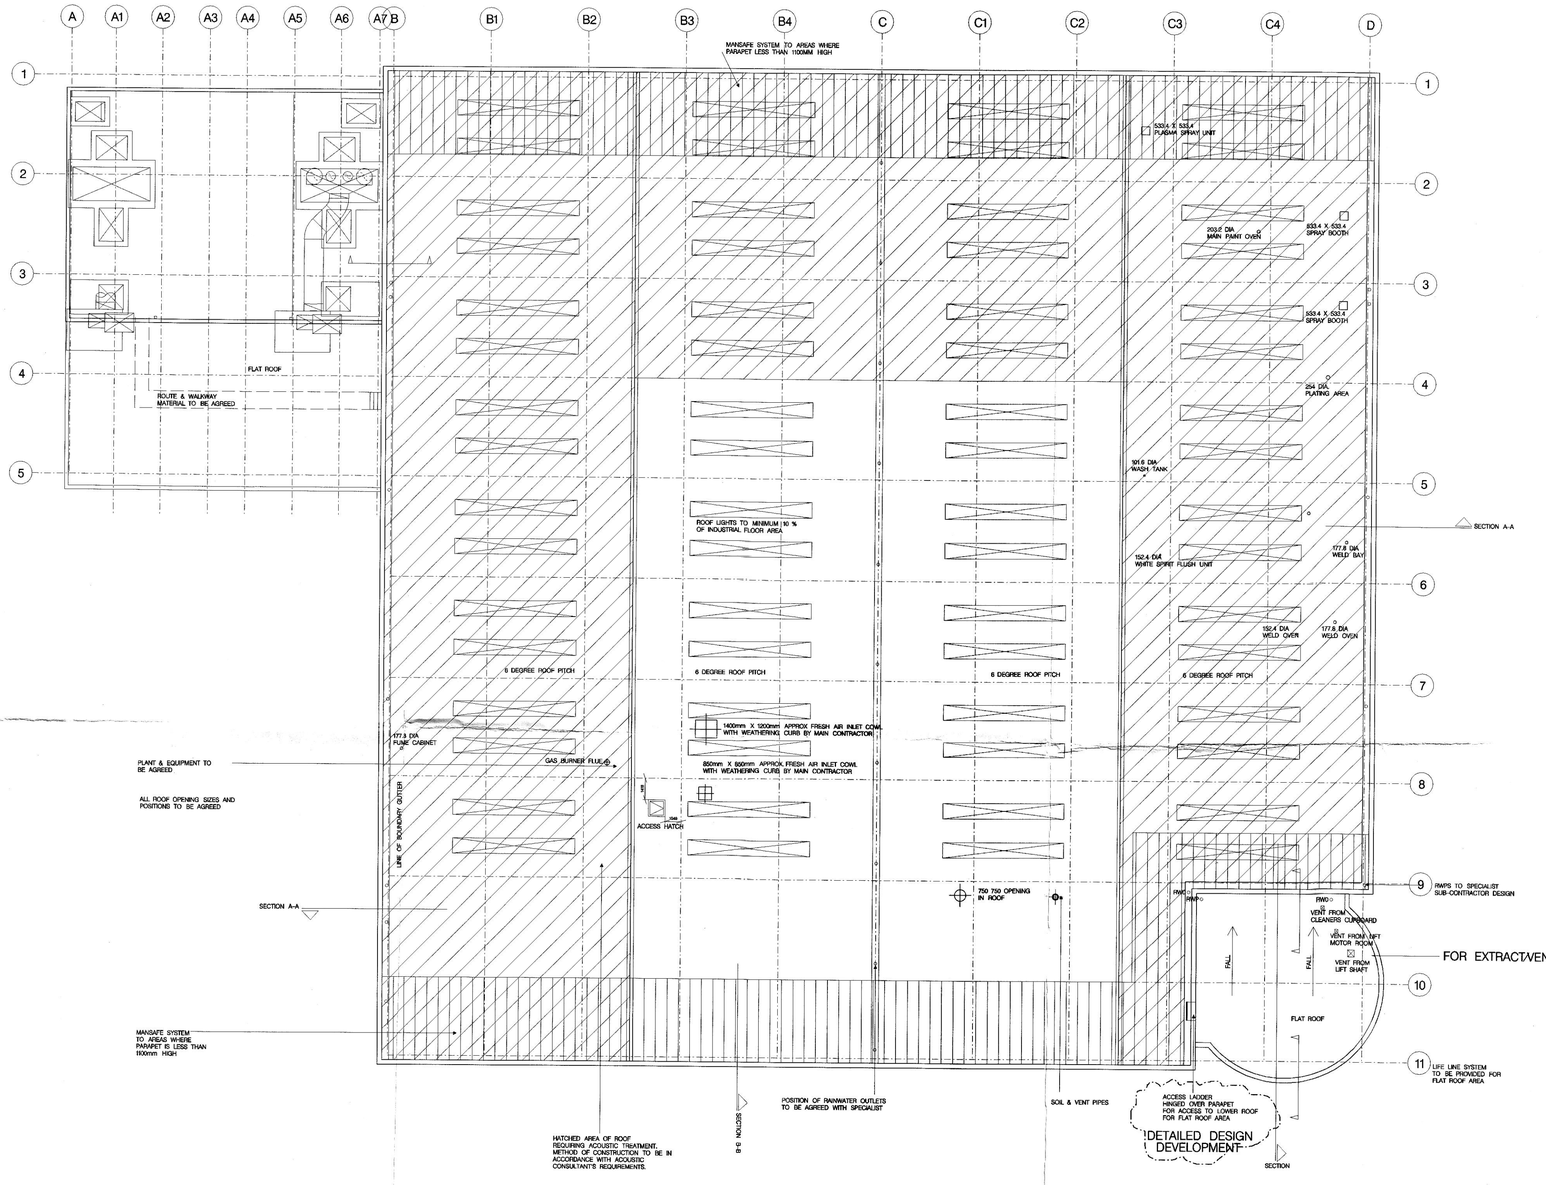


GENERAL ARRANGEMENT ROOF LEVEL PLAN.

RECORD DRAWING

REV E: TEST CELL ADJUSTED, INLET COWLS MOVED OFF ROOFLIGHTS. (LMS) 28.05.99
REV D: AREA OF ACOUSTIC TREATMENT CHANGED, LIFT SHAFT VENT ENLARGED, RWP AND RWO TO FLAT ROOF REVISED, (LMS) 17.05.99
REV C: GENERAL UPDATE. (MPG) 05.05.99
REV B: GRID NUMBERS & ROOF OPENINGS SHOWN, 15.04.99
REV A: HIPS REMOVED & ROOFLIGHTS AMENDED, NOTE ON MANSAFE SYSTEM ADDED, CIRCULAR ROOFLIGHT ADDED. 12.04.99

CMC ARCHITECTS
Gibson House, 57-61 Burleigh Street, Cambridge CB1 1DJ
Telephone: 01223 312238 Facsimile: 01223 363155
E-Mail: 01223 328160 Internet: @cmc-camb.demon.co.uk

Client
WARINGS CONTRACTORS LTD.

Project
SOUTHAMPTON INTERNATIONAL PARK

Title
PROPOSED ROOF PLAN.
PLOT TWO.

Scale	Drawn	Date
1:200	EDM	18.03.99

Drg.No. E072 /1005 Revision E

Covell Matthews Cambridge Architects Ltd.
This drawing is copyright. Do not scale from drawing.