




1 Section 1
1 : 100




2 Section 2
1 : 100



3 Section 3
1 : 100

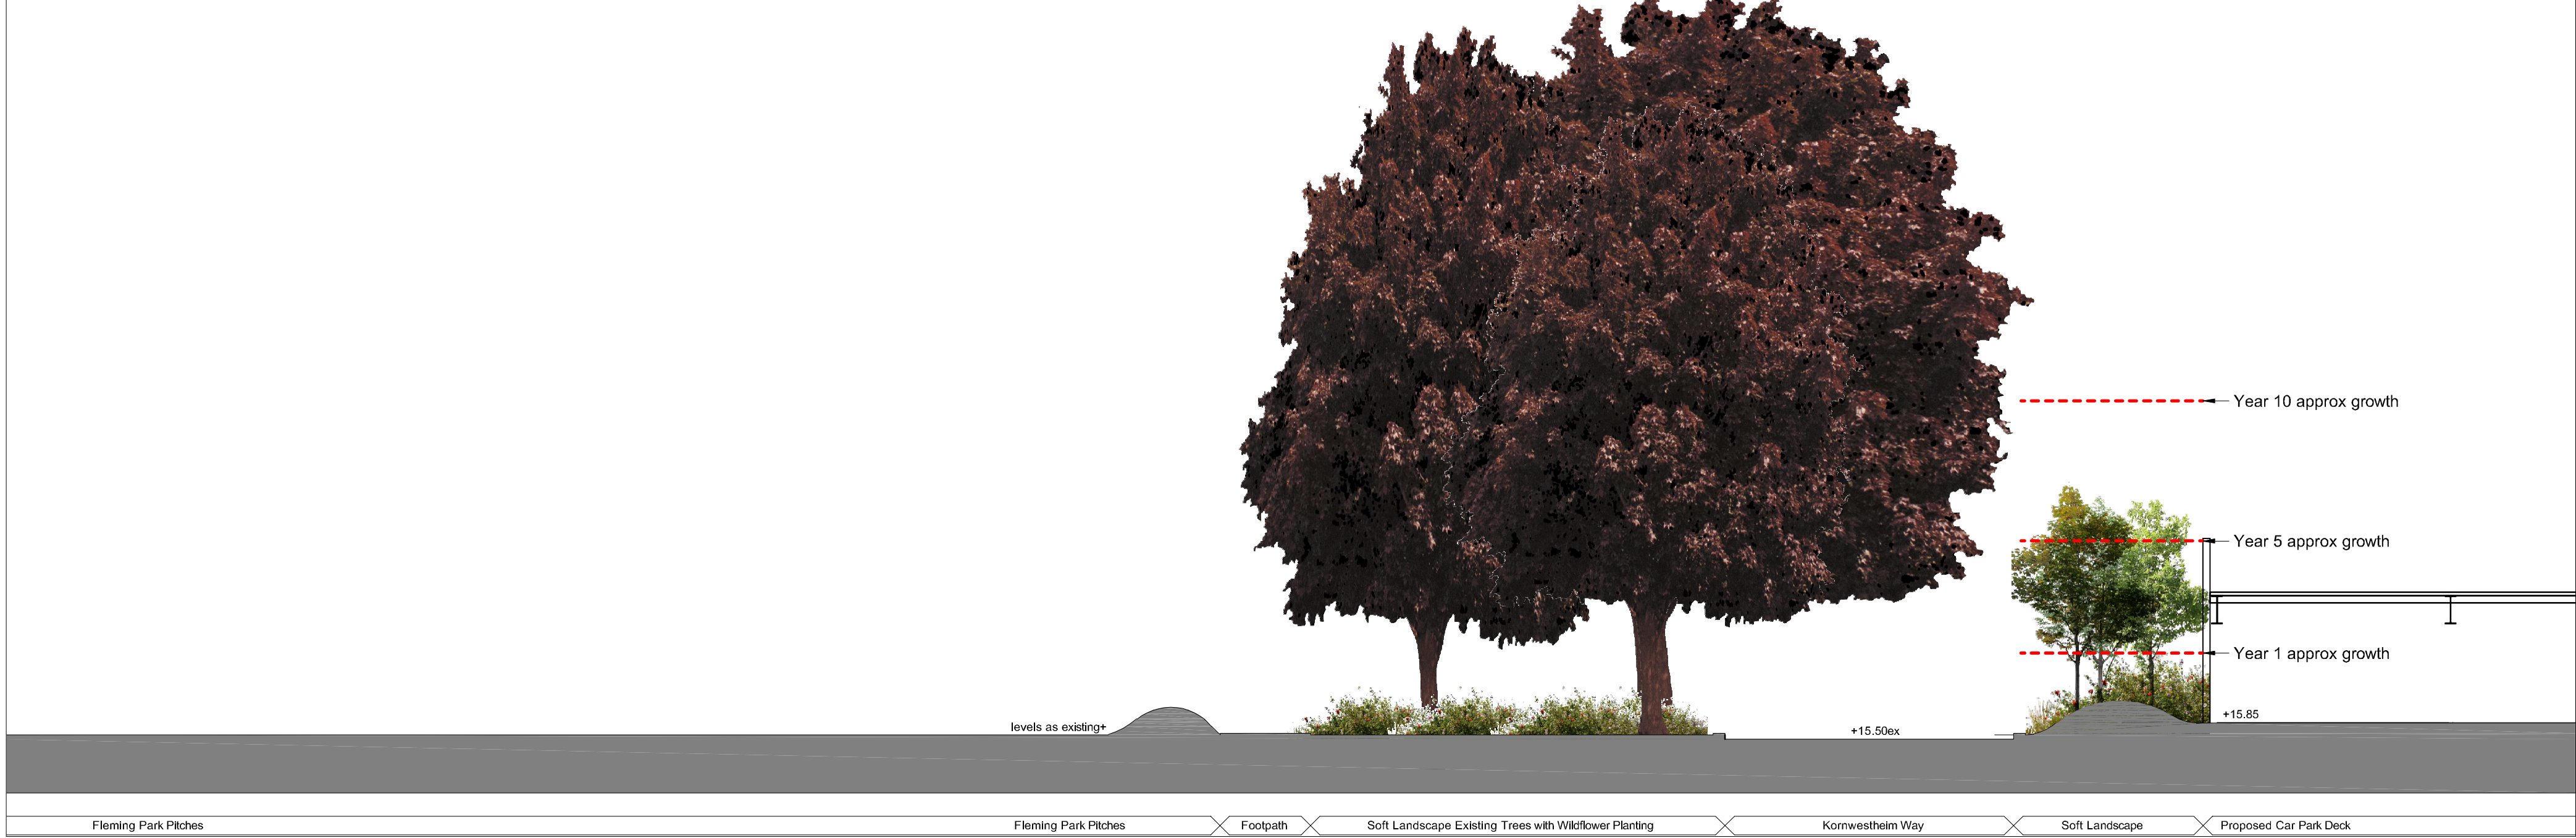

4 Section 4
1 : 100

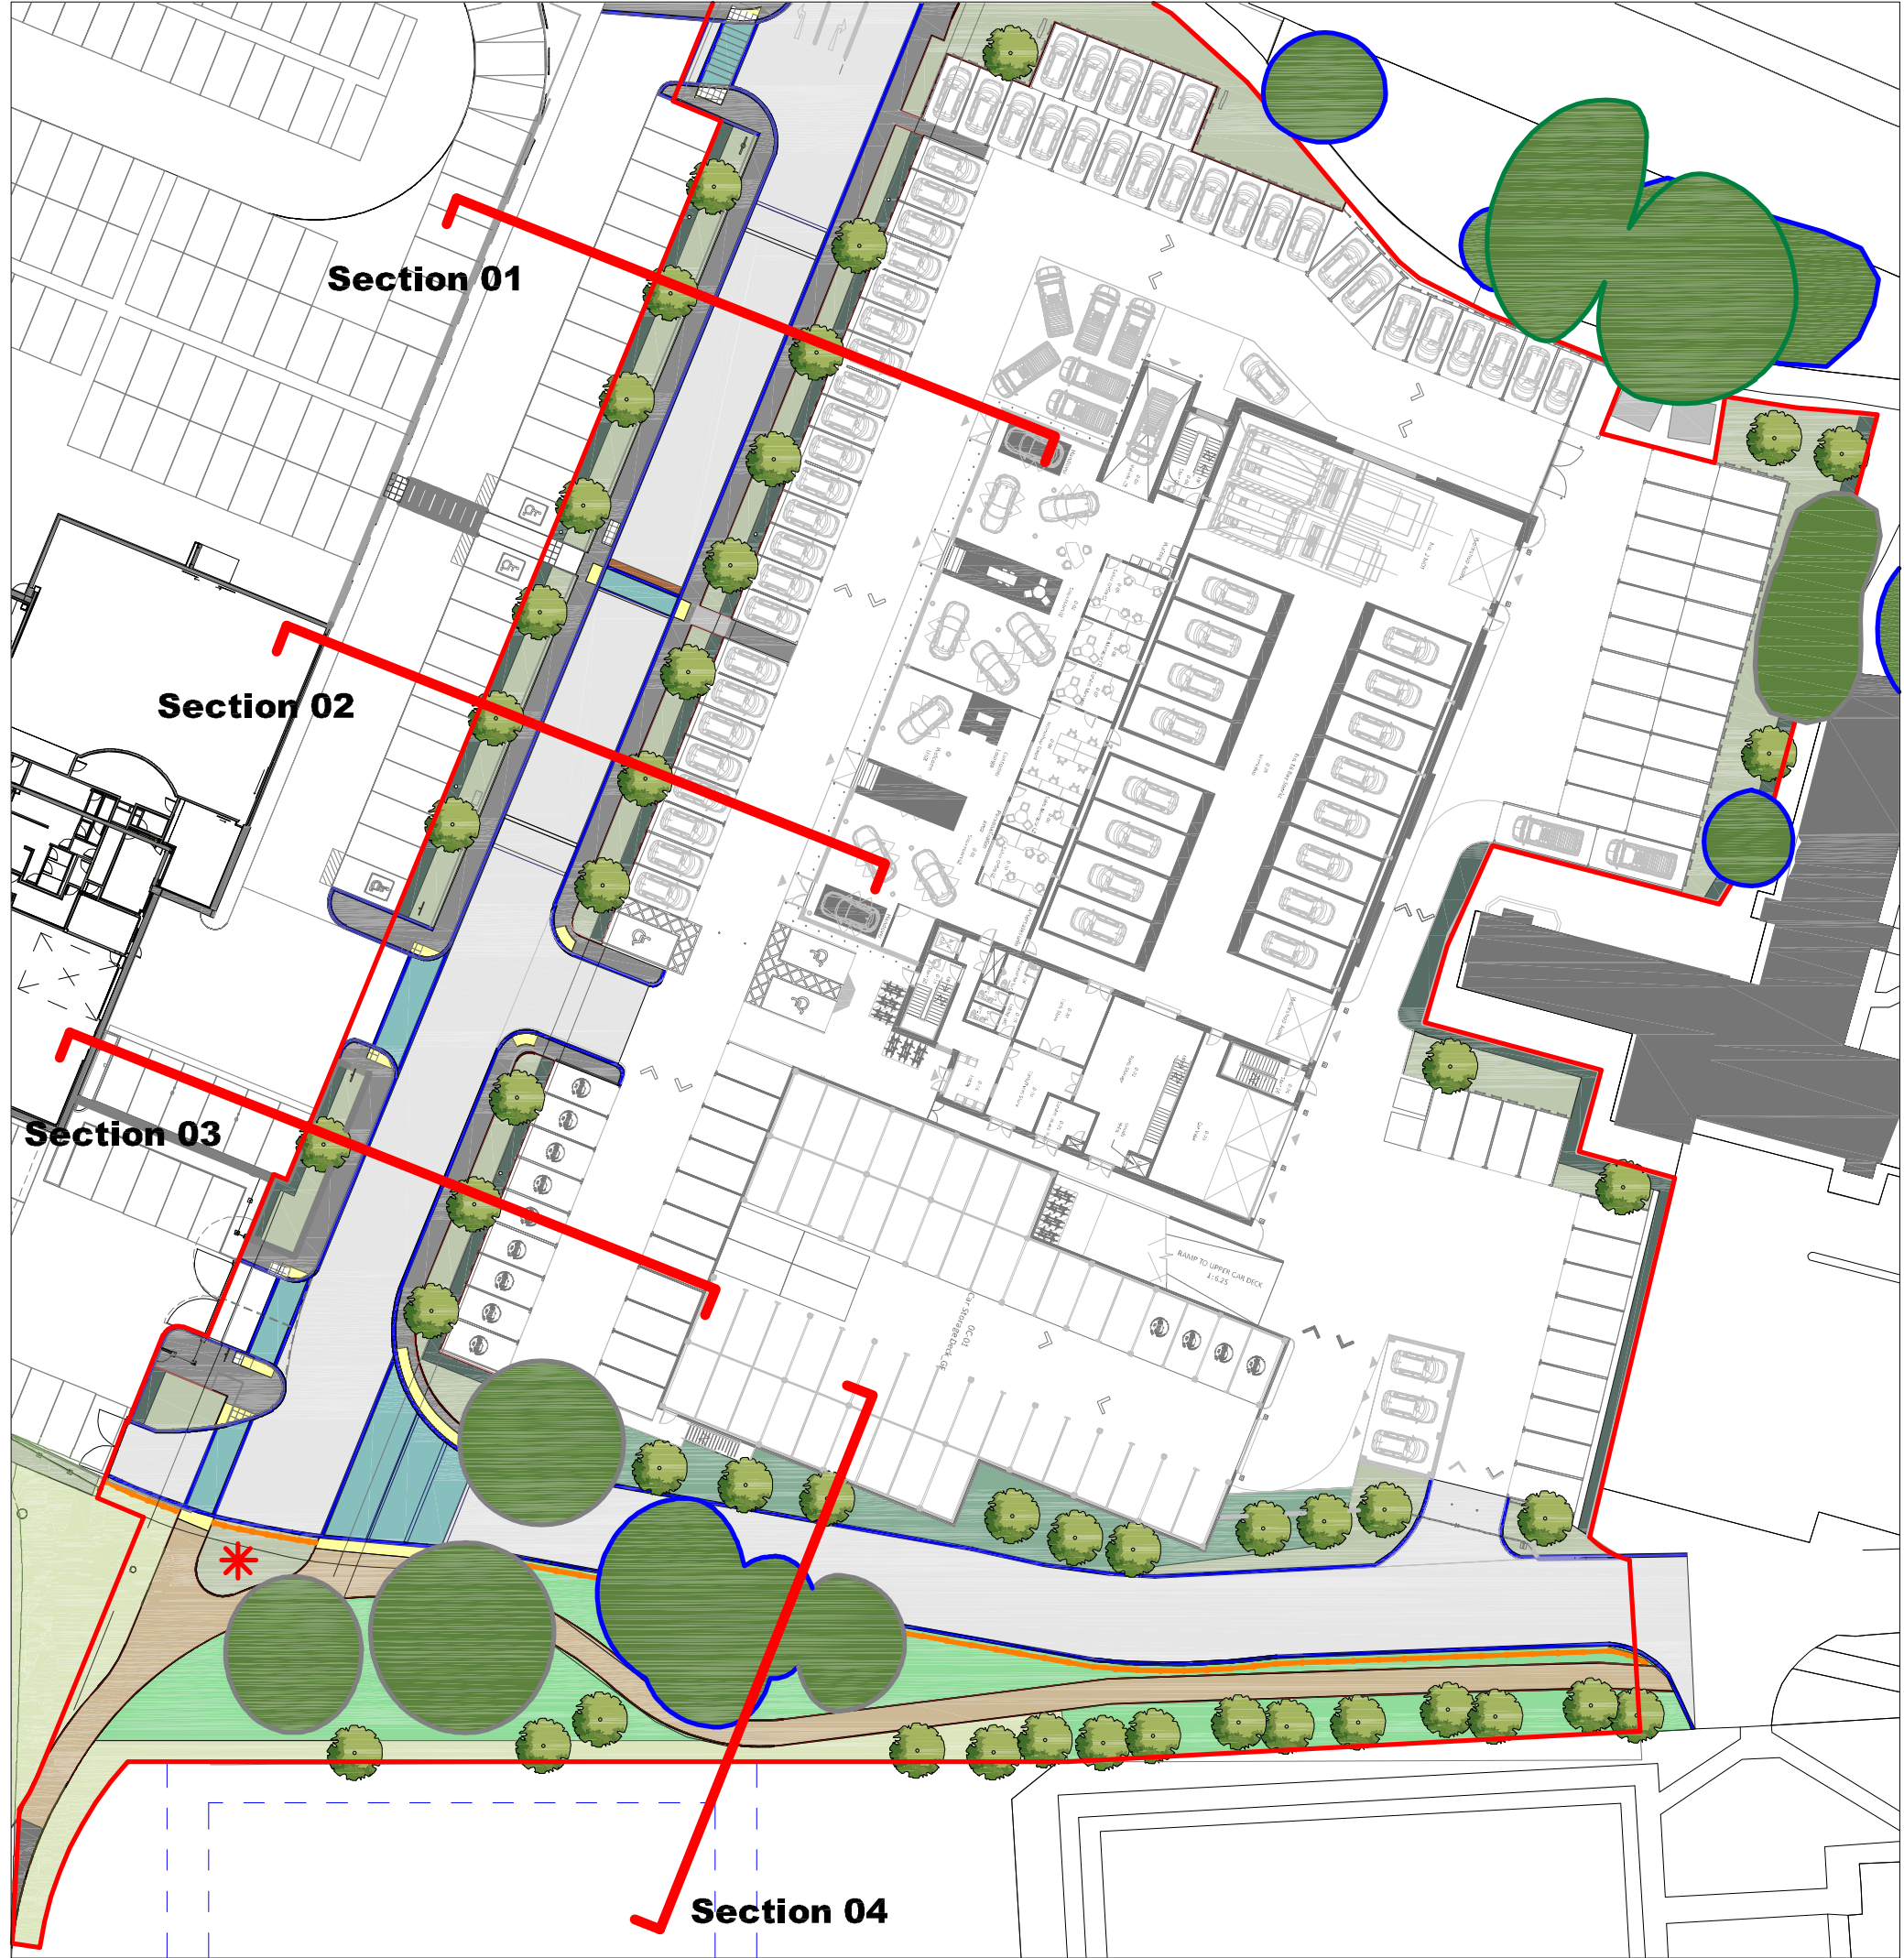

5 Section Location Plan
1 : 500

NOTES:
To be read in conjunction with the following landscape drawings / Reports:
EVW-AHR-ZZ-ZZ-DR-L-0001 - Landscape Site Plan
EVW-AHR-ZZ-ZZ-DR-L-0002 - Tree protection and Removal Plan
EVW-AHR-ZZ-ZZ-DR-L-0003 - Soft Landscape Plan
EVW-AHR-ZZ-ZZ-DR-L-0004 - Top Soil Plan
EVW-AHR-ZZ-ZZ-DR-L-0005 - Site Sections
EVW-AHR-ZZ-ZZ-DR-L-0006 - Tree Pit Plan and Detail
EVW-AHR-ZZ-ZZ-DR-L-0010 - Typical Hard Landscape Detail
EVW-AHR-ZZ-ZZ-DR-L-0011 - Typical Soft Landscape Detail
EVW-AHR-ZZ-ZZ-SH-L-0001 - Soft Landscape Planting and Maintenance Schedule

P6	(S2) Planning Issue - PRC Updated to incorporate planning comments - amendments shown in red	08.12.2022	GW	GW
P5	(S2) Planning Issue - Sections updated in line with comments	20.12.2021	KV	CP
P4	(S2) First Issue for Tender	19.11.2021	KV	CP
P3	(S2) Planning Issue - Landscape updated in line with latest car show room and general comments	18.10.2021	KV	CP
P2	Soft landscape updated in line with latest car showroom plan amendments	06.10.2021	KV	CP
P1	First Issue	13.09.2021	CP	CP
Rev	Description	Date	Dr by	App by
CP		08/09/21		CP

AHR
AHR Architects Ltd
First Floor
Victoria House
Victoria Quay
Shrewsbury
SY1 1HH
United Kingdom
T +44(0)1743 283000
F +44(0)1743 232717
E shrewsbury@ahr.co.uk
www.ahr.co.uk

client name	HENDY GROUP LTD.
project	EASTLEIGH - VILLENEUVE WAY
drawing	Site Sections
computer file	C:\Rek Projects\Eastleigh\AHR\AHR-ZZ-ZZ-DR-L-0001-01.dwg
project number	2021.00497.000
drawing number	EVW-AHR-ZZ-ZZ-DR-L-0005
scale	As indicated@A1
rev	P6
issue status	S2
This drawing is to be read in conjunction with all related drawings. All dimensions must be checked and verified on site before commencing any work or producing shop drawings. The originator should be notified immediately of any discrepancy. This drawing is copyright and remains the property of AHR.	