




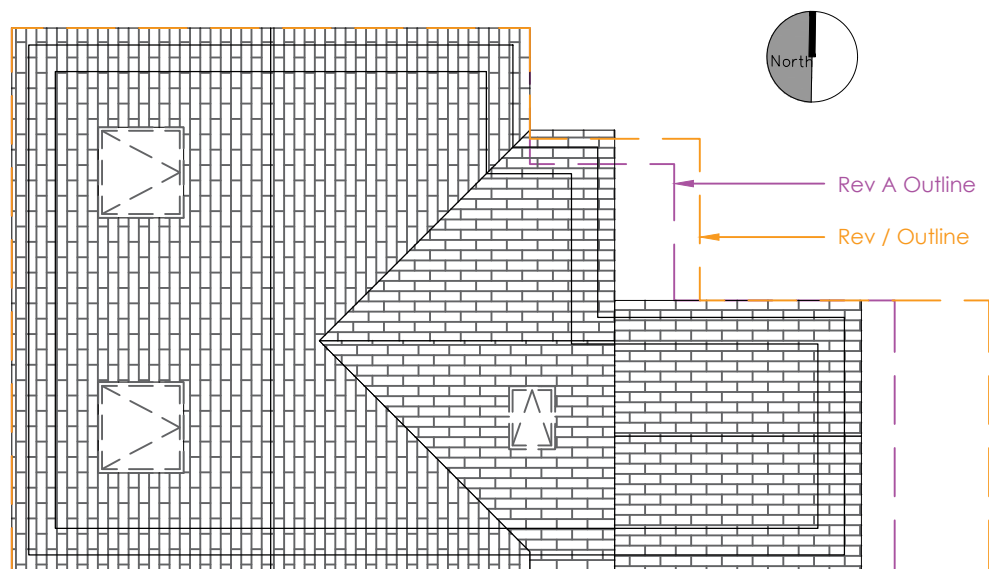


PROPOSED ROOF PLAN
SCALE 1:100

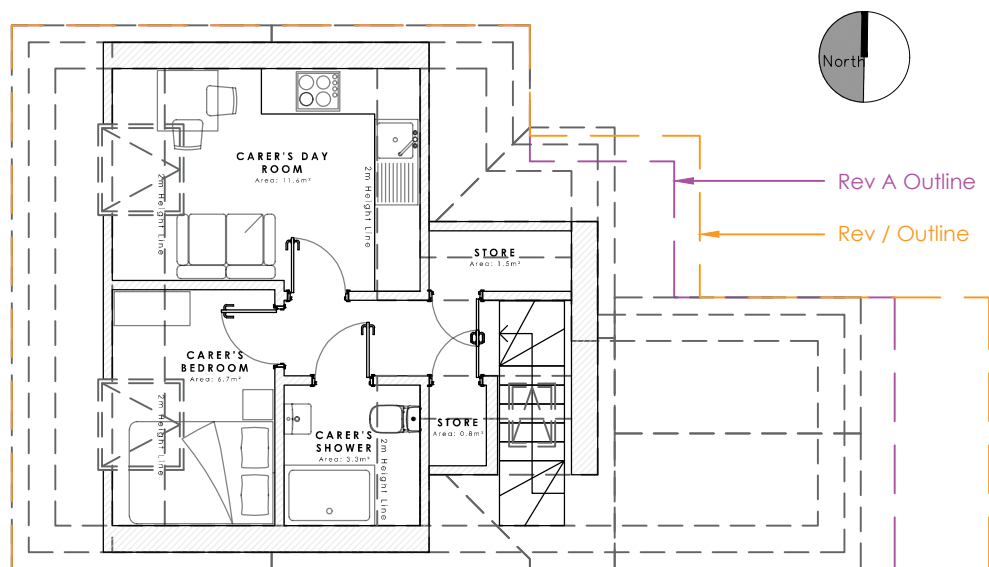

PROPOSED FIRST FLOOR
SCALE 1:100

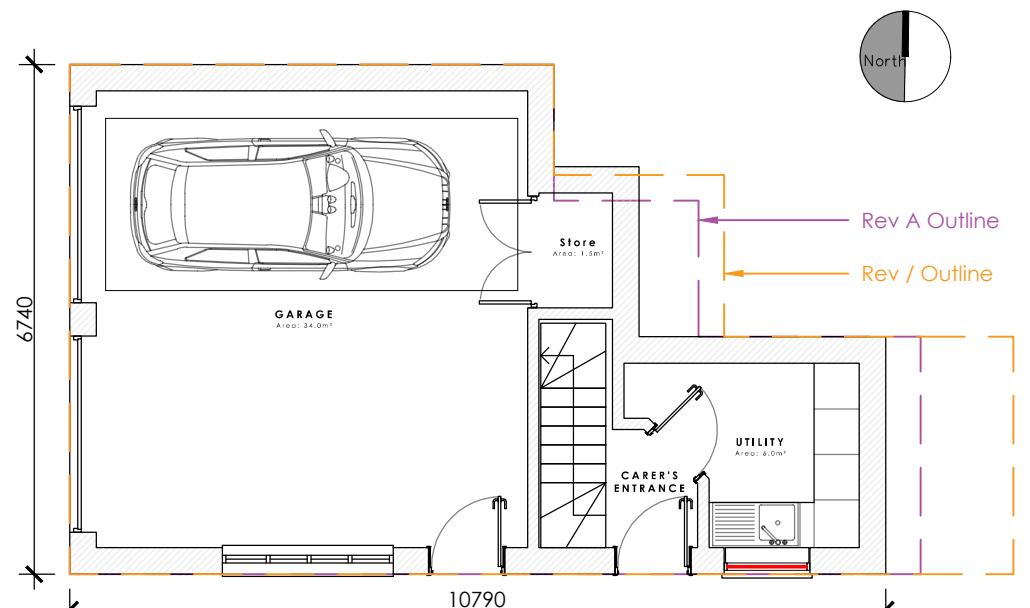

PROPOSED GROUND FLOOR
SCALE 1:100

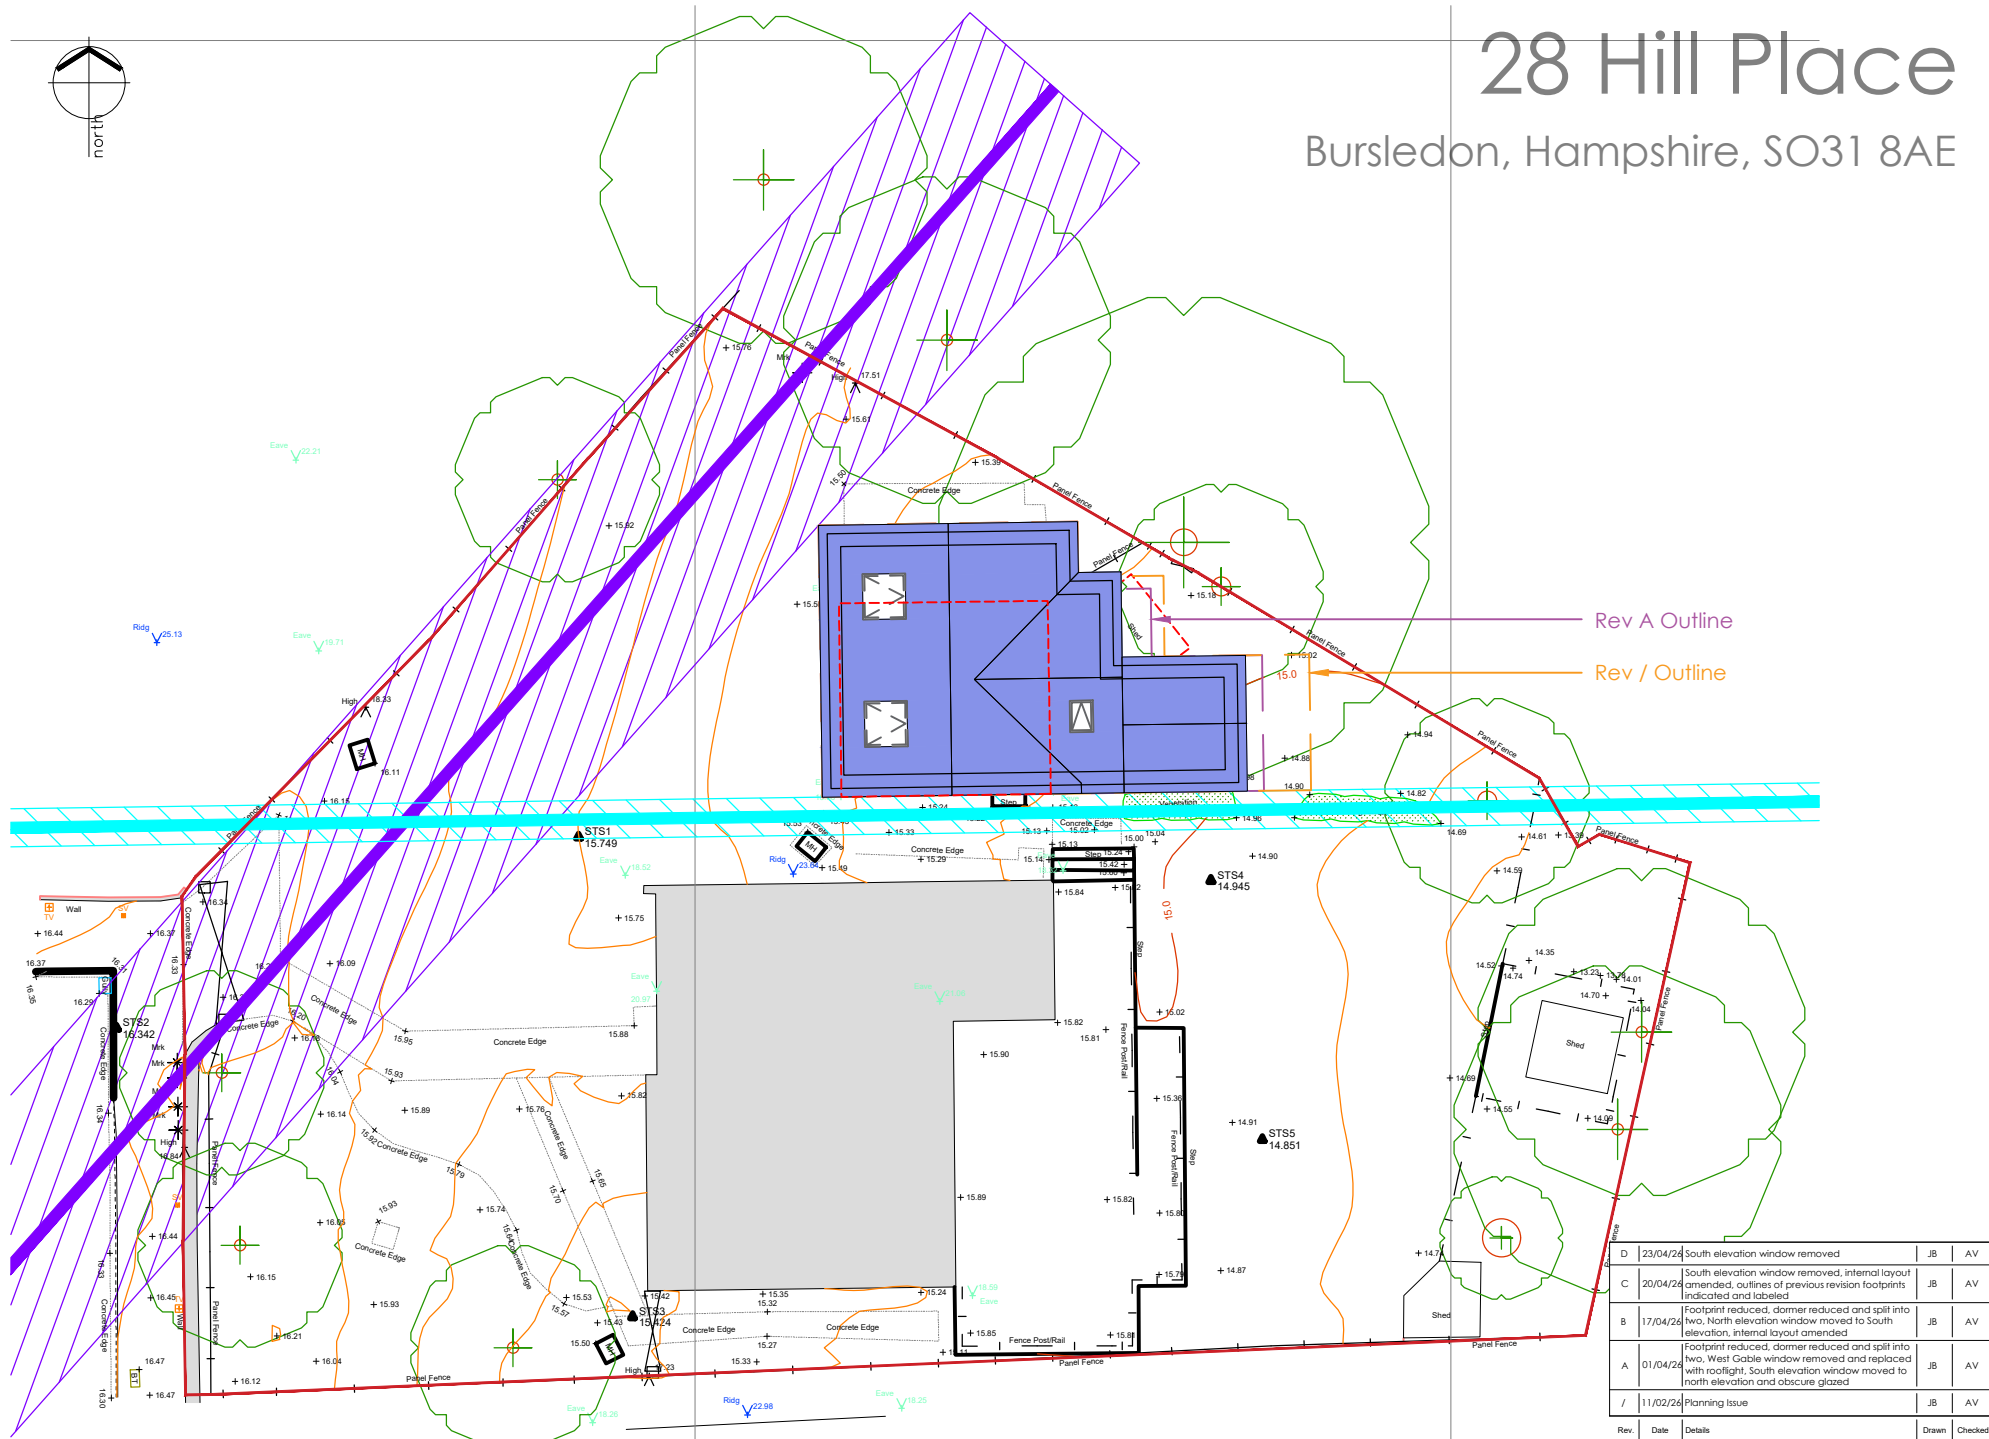

PROPOSED BLOCK PLAN
SCALE 1:200


Rev.	Date	Details	Drawn	Checked
------	------	---------	-------	---------

Project/Client:		Project No:	
28 Hill Place,		PRO214	
Bursledon,		Dwg No:	
Hampshire,		P-003	
SO31 8AE		Rev:	
		D	
Drawing:		Scale:	
Proposed Plans		Labelled @A3	
		Drawn By:	
		JB	
		Date:	
		Jan 26	
		Checked By:	
		AV	
		Date:	
		Jan 26	



Leicestershire Office: Unit 6, Brook Park Gaddesby Lane, Rearsby, LE17 4ZB
Devon Office: 1 Devon Square, Newton Abbot, TQ12 2HN
Central Office: 176 King Street, London, W6 0RA

T: +44 (0)333 577 0809 E: projects@plg.uk
www.plg.uk

Registered Office: Venture House, 27-29 Glasshouse Street, London W1B 5DP. Registered Number: 08046920
STANDARD NOTES:
• This drawing exceeds quantity taken in any way, the building designers are to be informed before works initiated.
• Only figured dimensions to be taken from this drawing. Do not scale off this drawing.
• Drawing based on Ordnance Survey and/or existing record drawings, design and drawing content subject to site survey, structural survey, site investigations, planning and statutory requirements and approvals.
• PLG Consultants Ltd retain the copyright of the design, scheme and ownership of the drawings.
• Drawings to be read in conjunction with structural engineers drawings.
• Any omissions to be reported to and clarified with client prior to commencement.
• Verify dimensions, levels and existing structure on site prior to commencement.
• All works to comply with current regulations, British standards etc.
• The builder is responsible for serving party wall notices should they be necessary prior to commencement.
• Unless drawings submitted to building control are subject to additional information required by building control which could have a significant impact on additional works to be done on site.
• All works commenced prior to Building Regulation Approval are carried out at the client's risk.
• ALL DIMENSIONS TO BE DOUBLE CHECKED ON SITE PRIOR TO SETTING OUT