


28 Hill Place


Bursledon, Hampshire, SO31 8AE

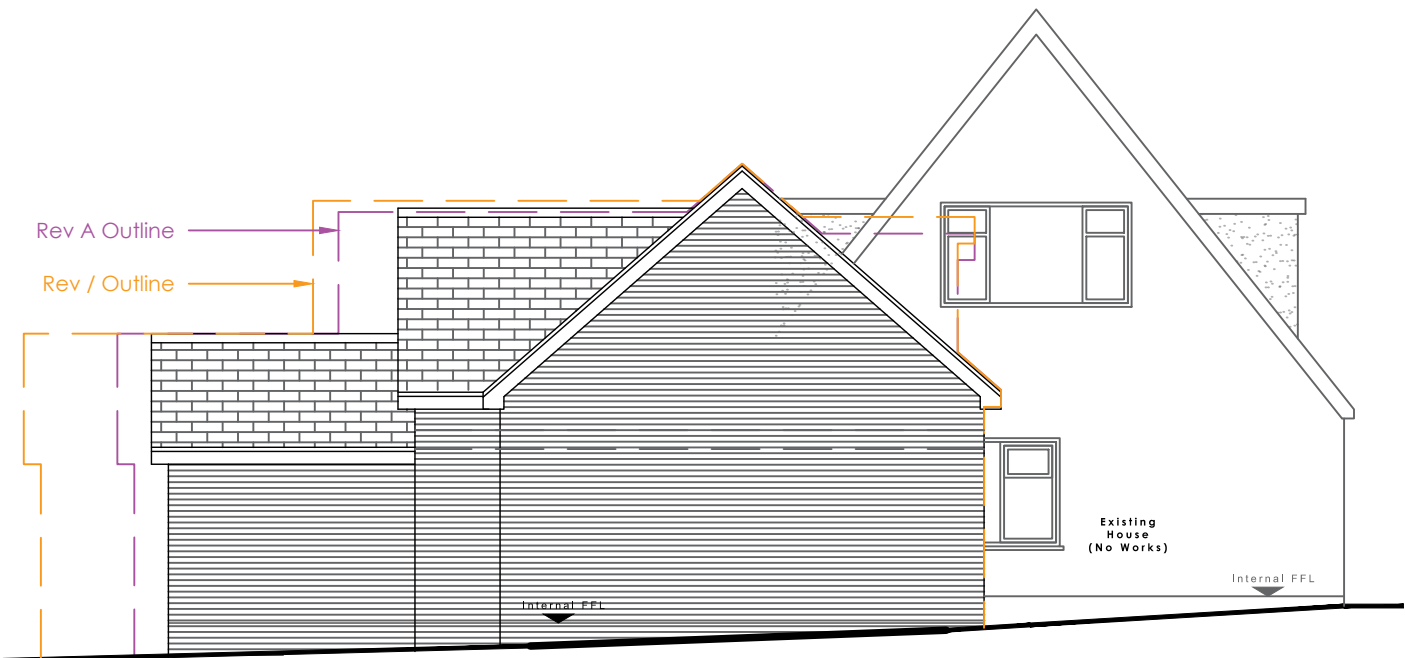


PROPOSED WEST ELEVATION
SCALE 1:100



PROPOSED NORTH ELEVATION
SCALE 1:100

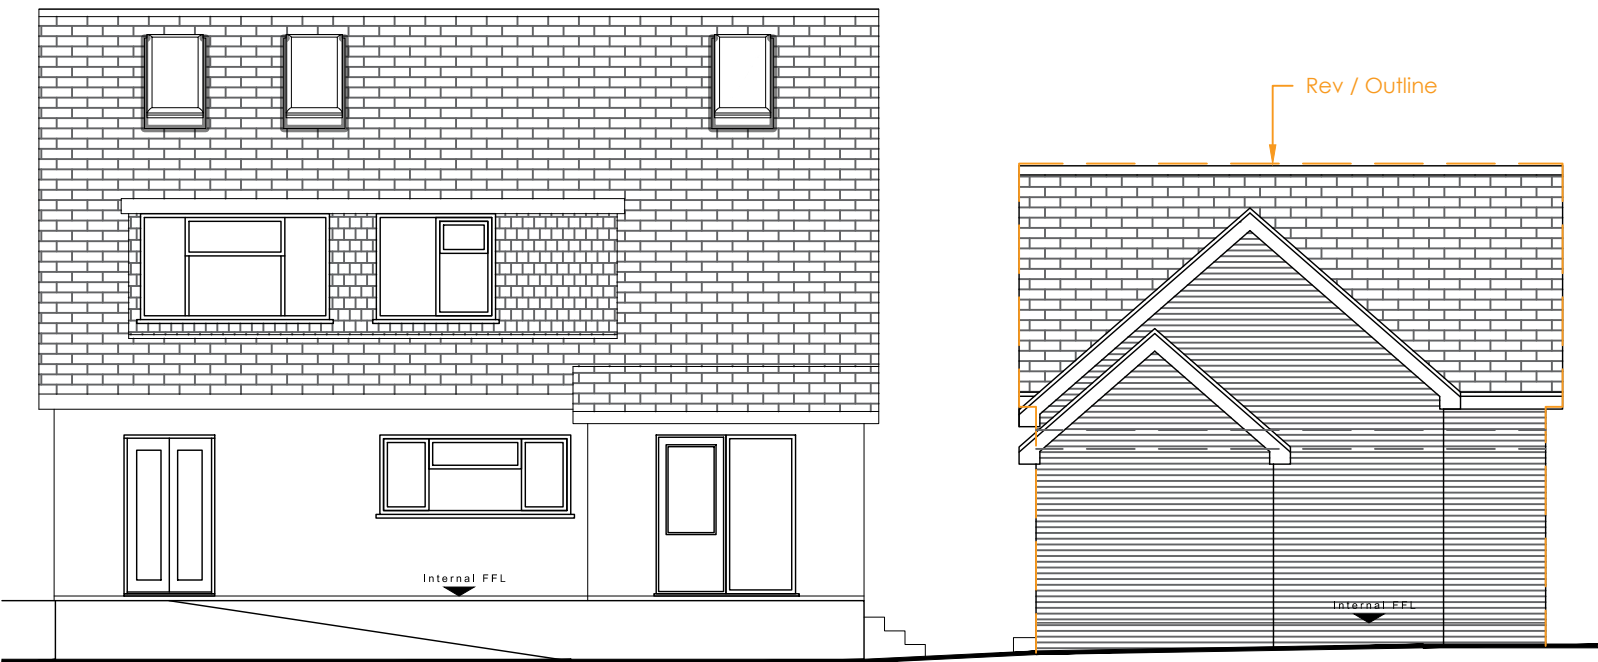

PROPOSED EAST ELEVATION
SCALE 1:100

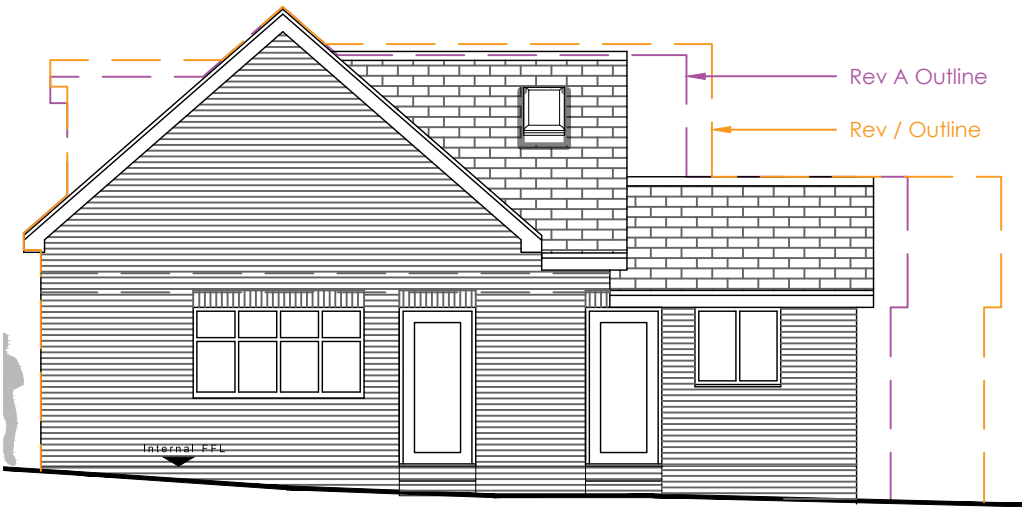

PROPOSED SOUTH ELEVATION
SCALE 1:100

C	20/04/24	South elevation window removed, internal layout amended, outlines of previous revision footprints indicated and labeled	JB	AV
B	17/04/24	Footprint reduced, dormer reduced and split into two, north elevation window moved to south elevation, internal layout amended	JB	AV
A	01/04/24	Footprint reduced, dormer reduced and split into two, West Gable window removed and replaced with rooflight, South elevation window moved to north elevation and obscure glazed	JB	AV
/	23/02/24	Planning Issue	JB	AV
Rev.	Date	Details	Drawn	Checked

Issued for:				
PLANNING				
Project/Client:		Project No:		
28 Hill Place,		PRO214		
Bursledon,		Dwg No:		
Hampshire,		P-004		
SO31 8AE		Rev:		
Drawing:		C		
Proposed Elevations		Scale:		
		Labelled @A3		
		Drawn By:		
		JB		
		Date:		
		Jan 26		
		Checked By:		
		AV		
		Date:		
		Jan 26		



Leicestershire Office: Unit 6, Brook Park Gaddesby Lane, Rearsby, LE7 4ZB
Devon Office: 1 Devon Square, Newton Abbot, TQ12 2HN
Central Office: 176 King Street, London, W6 0RA

T: +44 (0)333 577 0809 E: projects@plg.uk
www.plg.uk

Registered Office: Venture House, 27-29 Glasshouse Street, London W1B 5DF. Registered Number: 08048930
STANDARD NOTES:
• If this drawing exceeds your's taken in any way, the building designers are to be informed before works initiated.
• Only figured dimensions to be taken from this drawing. Do not scale off this drawing.
• Drawing based on Ordnance Survey and/or existing record drawings - design and drawing content subject to site survey, structural survey, site investigations, planning and statutory requirements and approvals.
• PLG Consultants retain the copyright of the design, scheme and ownership of the drawings.
• Drawings to be read in conjunction with structural engineers drawings.
• Any omissions to be reported to and clarified with client prior to commencement.
• Verify dimensions, levels and existing structure on site prior to commencement.
• All works to comply with current regulations, British standards etc.
• The builder is responsible for serving party wall notices should they be necessary prior to commencement.
• Valid drawings submitted to building control are subject to additional information required by Building control which could have a significant cost or additional works to be done on site.
• All works commenced prior to Building Regulation Approval are carried out at the client's risk.
• ALL DIMENSIONS TO BE DOUBLE CHECKED ON SITE PRIOR TO SETTING OUT